

TEMPORARY AND DURABLE 100mm WHITE LINE

STA 10+395 TO 10+427	SOLID LT
STA 10+395 TO 10+470	SOLID RT
STA 10+410 TO 10+414	SOLID LT (NO PARKING)
STA 10+421 TO 10+427	SOLID LT (NO PARKING)
STA 10+427 TO 10+431	SOLID LT (TH 322)
STA 10+428 TO 10+470	SOLID RT (NO PARKING)
STA 10+439 TO 10+443	SOLID LT (TH 322)
STA 10+443 TO 10+449	SOLID LT (NO PARKING)
STA 10+443 TO 10+501	SOLID LT
STA 10+496 TO 10+501	SOLID LT (NO PARKING)
STA 10+501 TO 10+507	SOLID LT (TH 324)
STA 10+507 TO 10+513	SOLID RT (TH 448)
STA 10+514 TO 10+515	SOLID LT (TH 324)
STA 10+520 TO 10+530	SOLID RT (TH 448)
STA 10+532 TO 10+538	SOLID RT (NO PARKING)
STA 10+536 TO 10+580	SOLID RT
STA 10+560 TO 10+580	SOLID LT (NO PARKING)

DURABLE 100mm WHITE LINE (TYPE I-TAPE)

STA 10+435 TO 10+470	DOTTED RT (LANE LINE)
STA 10+470 TO 10+504	SOLID RT (LANE LINE)
STA 10+533 TO 10+560	SOLID LT (LANE LINE)
STA 10+560 TO 10+580	DOTTED LT (LANE LINE)

TEMPORARY 100mm WHITE LINE

STA 10+435 TO 10+470	DOTTED RT (LANE LINE)
STA 10+470 TO 10+504	SOLID RT (LANE LINE)
STA 10+533 TO 10+560	SOLID LT (LANE LINE)
STA 10+560 TO 10+580	DOTTED LT (LANE LINE)

DURABLE LETTER OR SYMBOL (TYPE I-TAPE)

STA 10+433	LT - "STOP" (TH 322)
STA 10+471	RT - "ONLY"
STA 10+475	RT-LEFT TURN ARROW
STA 10+498	RT - "ONLY"
STA 10+502	RT-LEFT TURN ARROW
STA 10+508	LT - "STOP" (TH 324)
STA 10+536	LT-LEFT TURN ARROW
STA 10+539	LT - "ONLY"
STA 10+555	LT-LEFT TURN ARROW
STA 10+559	LT - "ONLY"

TEMPORARY LETTERS OR SYMBOLS

STA 10+433	LT - "STOP" (TH 322)
STA 10+475	RT-LEFT TURN ARROW
STA 10+502	RT-LEFT TURN ARROW
STA 10+508	LT - "STOP" (TH 324)
STA 10+536	LT-LEFT TURN ARROW
STA 10+555	LT-LEFT TURN ARROW

DURABLE 600mm STOP BAR (TYPE I-TAPE)

STA 10+435	LT (TH 322)
STA 10+504	RT
STA 10+506	LT (TH 324)
STA 10+534	LT

TEMPORARY 600mm STOP BAR

STA 10+435	LT (TH 322)
STA 10+504	RT
STA 10+506	LT (TH 324)
STA 10+534	LT


DURABLE CROSSWALK MARKINGS W/DIAGONAL LINES (MOD)

STA 10+426 TO 10+443	LT
STA 10+500 TO 10+530	RT
STA 10+502 TO 10+516	LT
STA 10+532	LT TO RT

TEMPORARY CROSSWALK MARKINGS W/DIAGONAL LINES

STA 10+426 TO 10+443	LT
STA 10+500 TO 10+530	RT
STA 10+502 TO 10+516	LT
STA 10+532	LT TO RT

CHANGED TOWN'S REQUEST 6/17/04

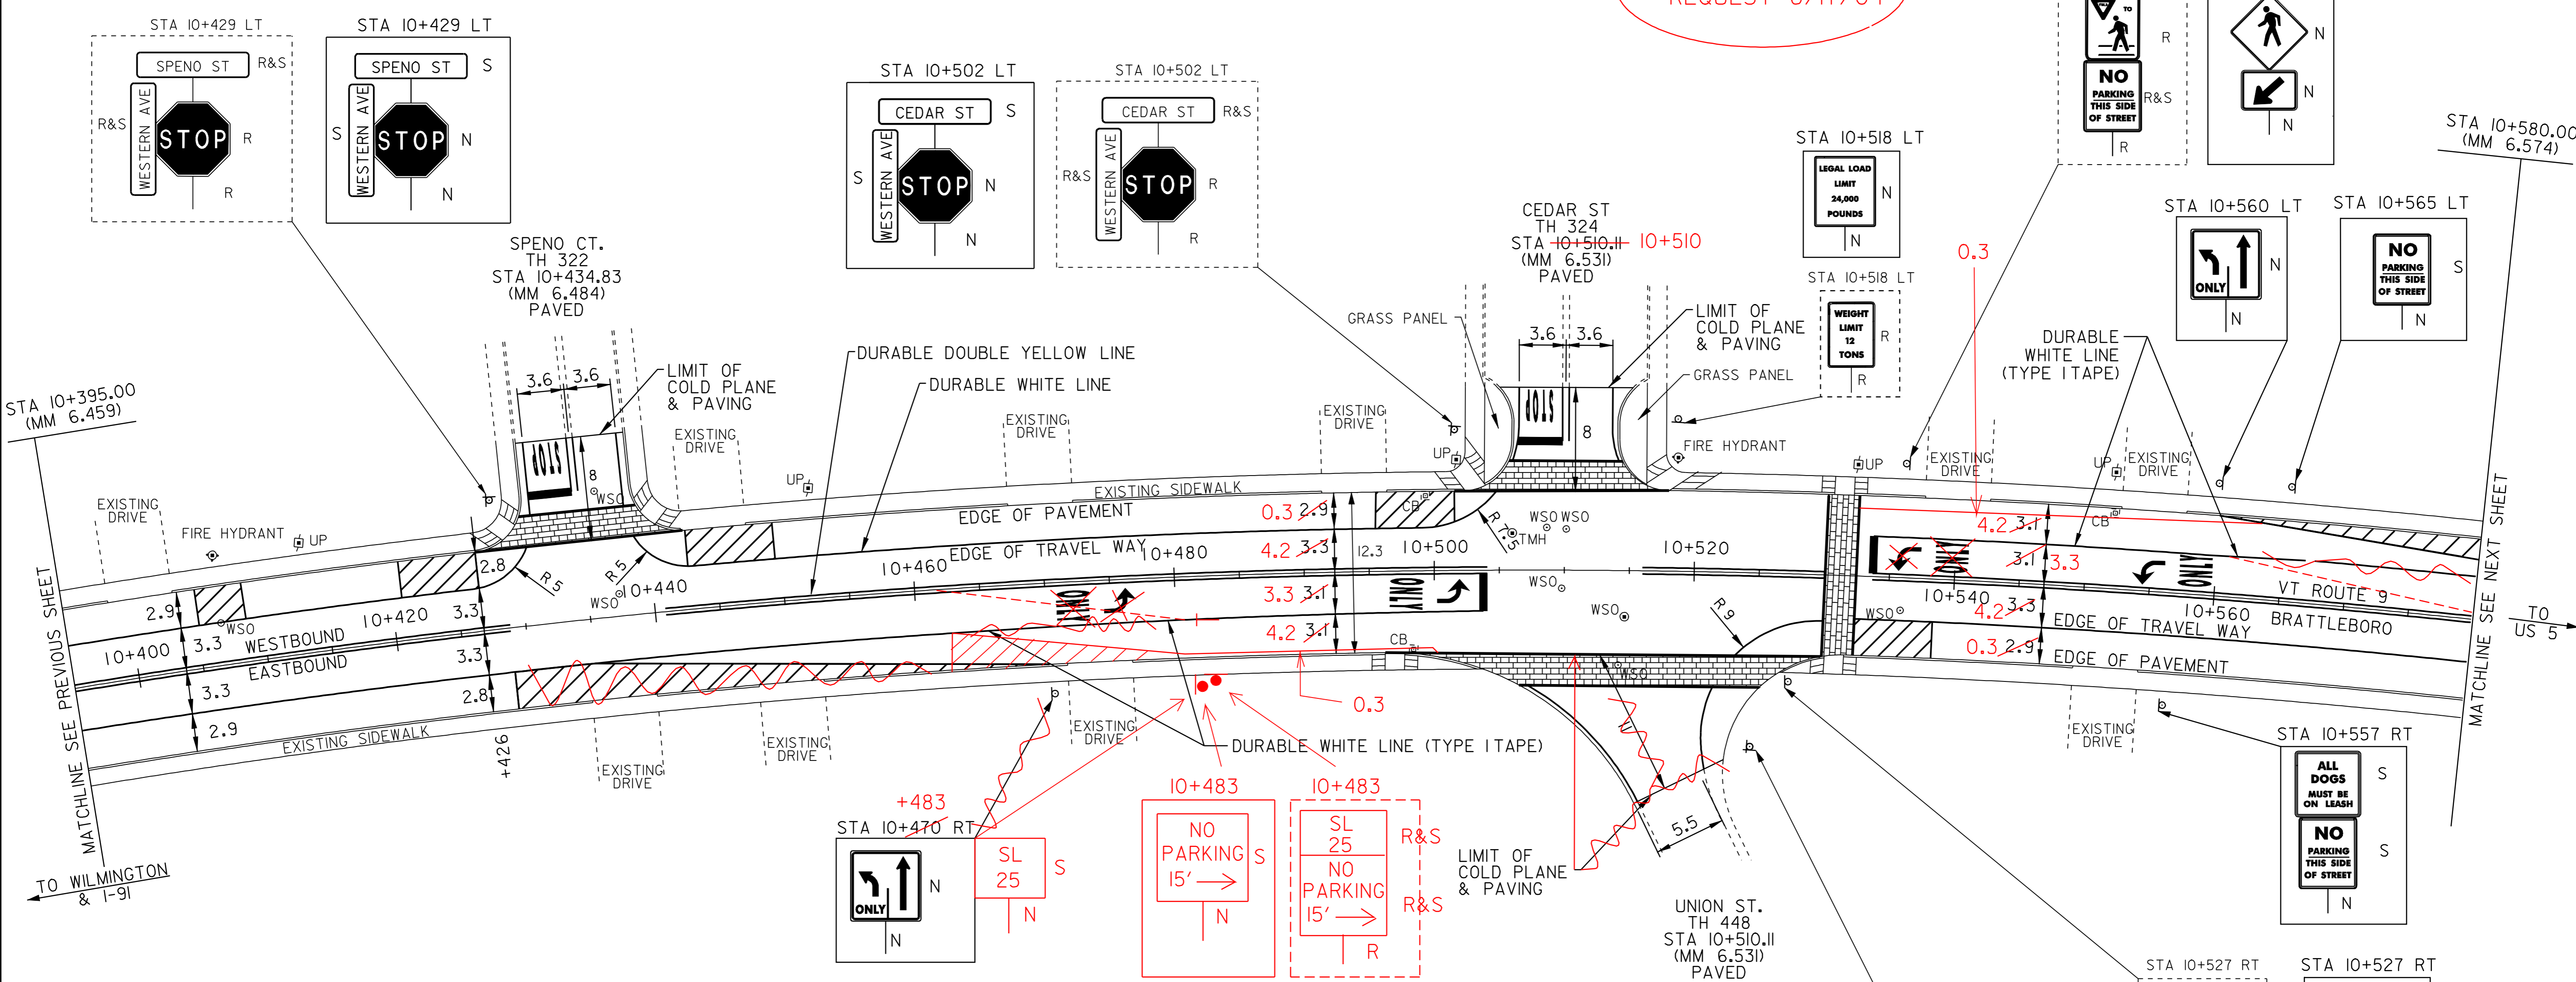

ADJUST ELEVATION OF VALVE BOX

STA 10+406	LT
STA 10+436	LT-TH 322
STA 10+436	LT
STA 10+509	LT
STA 10+511	LT
STA 10+511	RT
STA 10+514	RT-TH 448
STA 10+514	RT
STA 10+535	RT

CHANGING ELEV. OF DI, CB, OR MH

STA 10+506	LT (TMH)
------------	----------

REHABILITATION OF DI, CB, OR MH, CLASS I

STA 10+499	LT (CB)
STA 10+499	RT (CB)
STA 10+552	LT (CB)

REMOVING SIGNS

AS SHOWN - 15 17

ERECTING SALVAGED SIGNS

AS SHOWN - 9

LEGEND

R	= REMOVE EXISTING
S	= SALVAGE
R&S	= REMOVE AND SALVAGE
N	= NEW
RET	= RETAIN
B-B	= BACK TO BACK

NOTE: ALL DIMENSIONS IN METERS EXCEPT AS INDICATED

PAVING PROJECT LAYOUT #21	PROJECT NAME: BRATTLEBORO	FILE NAME: \PAVE\01026\PD026.dgn	PLOT DATE: \$DATE\$	
	PROJECT NUMBER: SI-STP_2303(I)S	PROJECT LEADER: WRH	DRAWN BY: JAC	
	DESIGNED BY: -	CHECKED BY: NLL	CLD REF. NO.: pd026(2)I	SHEET 29 OF 55

NOT TO SCALE