

TEMPORARY AND DURABLE 100mm WHITE LINE

STA 10+760 TO 10+772 SOLID LT  
 STA 10+760 TO 10+778 SOLID RT  
 STA 10+778 TO 10+782 SOLID RT (NO PARKING)  
 STA 10+782 TO 10+940 SOLID RT  
 STA 10+790 TO 10+796 SOLID LT (NO PARKING)  
 STA 10+796 TO 10+833 SOLID LT  
 STA 10+833 TO 10+837 SOLID LT (NO PARKING)  
 STA 10+837 TO 10+940 SOLID LT

REHABILITATION OF DI, CB, OR MH, CLASS I

STA 10+777 LT (CB)  
 STA 10+801 RT (CB)  
 STA 10+806 LT (CB)  
 STA 10+839 LT (CB)  
 STA 10+839 RT (CB)  
 STA 10+887 LT (CB)  
 STA 10+887 RT (CB)  
 STA 10+935 LT (CB)  
 STA 10+935 RT (CB)

ADJUST ELEVATION OF VALVE BOX

STA 10+763 LT  
 STA 10+765 LT  
 STA 10+766 LT  
 STA 10+780 RT  
 STA 10+788 RT  
 STA 10+789 RT  
 STA 10+827 RT

TEMPORARY AND DURABLE 100mm YELLOW LINE

STA 10+760 TO 10+776 SOLID LT & RT  
 STA 10+788 TO 10+940 SOLID LT & RT

CHANGING ELEVATION OF SEWER MANHOLE

STA 10+793 LT  
 STA 10+862 LT

DURABLE LETTER OR SYMBOL (TYPE 1 TAPE)


STA 10+853 RT-" STOP"  
 STA 10+865 RT-" AHEAD"

TEMPORARY LETTERS OR SYMBOLS

STA 10+853 RT-" STOP"  
 STA 10+865 RT-" AHEAD"

REMOVING SIGNS  
 AS SHOWN - 4 ✓

ERECTING SALVAGED SIGNS  
 AS SHOWN - 1

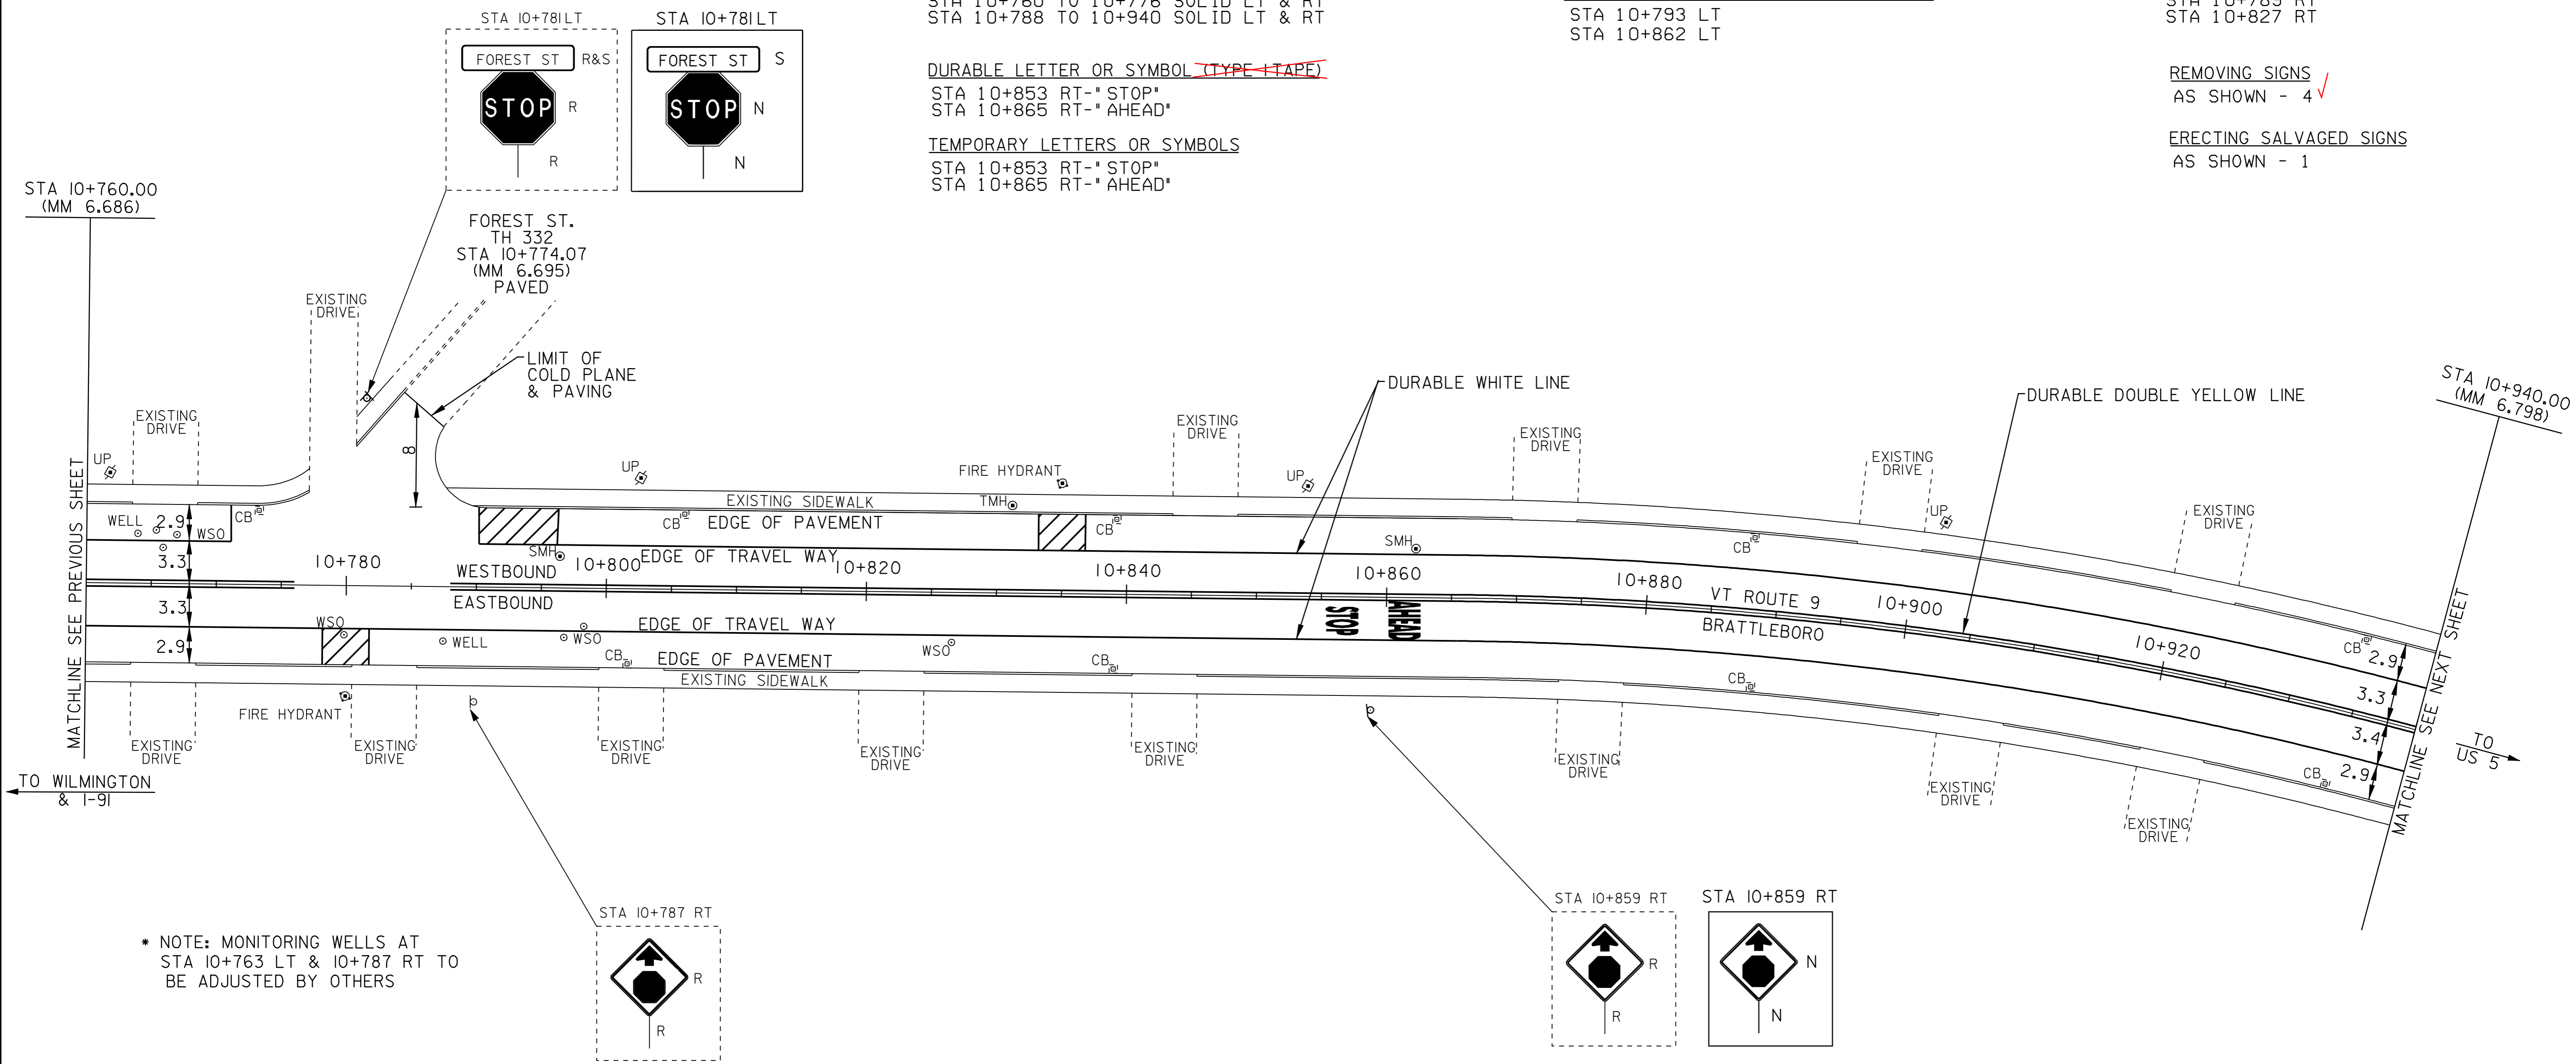

LEGEND

- R = REMOVE EXISTING
- S = SALVAGE
- R&S = REMOVE AND SALVAGE
- N = NEW
- RET = RETAIN
- B-B = BACK TO BACK

NOTE: ALL DIMENSIONS IN METERS EXCEPT AS INDICATED

NOT TO SCALE

<b>PAVING PROJECT LAYOUT #23</b>	PROJECT NAME: BRATTLEBORO	FILE NAME: \PAVE\QID026\PD026.dgn	PLOT DATE: \$DATE\$
	PROJECT NUMBER: ST-STP_2303(I)S	DESIGNED BY: WRH	DRAWN BY: JAC
	CLD REF. NO.: pd026i23.i	CHECKED BY: NLL	SHEET 31 OF 55