

TEMPORARY AND DURABLE 100mm WHITE LINE

- STA 10+940 TO 10+973 SOLID LT
- STA 10+940 TO 10+968 SOLID RT
- STA 10+960 TO 10+968 SOLID LT & RT (NO PARKING)
- STA 10+970 TO 10+973 SOLID LT (NO PARKING)
- STA 10+973 TO 10+978 SOLID LT (TH 340)
- STA 10+987 TO 10+993 SOLID LT (TH 340)
- STA 10+993 TO 11+001 SOLID LT & RT (NO PARKING)
- STA 10+995 TO 11+120 SOLID LT
- STA 10+995 TO 11+066 SOLID RT
- STA 11+072 TO 11+120 SOLID RT

DURABLE 100mm WHITE LINE (TYPE-TAPE)

- STA 10+981 SOLID LT-LANE LINE (TH 340)

TEMPORARY AND DURABLE 100mm YELLOW LINE

- STA 10+940 TO 10+968 SOLID LT & RT
- STA 10+985 SOLID LT (TH 340)
- STA 10+989 TO 11+063 SOLID LT & RT
- STA 11+075 TO 11+120 SOLID LT & RT

DURABLE 600mm STOP BAR (TYPE-TAPE)

- STA 10+967 RT
- STA 10+975 RT (TH 464)
- STA 10+983 LT (TH 340)
- STA 10+996 LT

TEMPORARY 600mm STOP BAR

- STA 10+967 RT
- STA 10+975 RT (TH 464)
- STA 10+983 LT (TH 340)
- STA 10+996 LT

DURABLE LETTER OR SYMBOL (TYPE-TAPE)

- STA 10+966 RT-"STOP"
- STA 10+980 LT-"STOP" (TH 340)
- ~~STA 10+980 LT-RIGHT TURN ARROW (TH 340)~~
- ~~STA 10+980 LT-"ONLY" (TH 340)~~
- STA 10+983 LT-"STOP" (TH 340)
- ~~STA 10+983 LT-LEFT TURN ARROW (TH 340)~~
- ~~STA 10+983 LT-"ONLY" (TH 340)~~
- STA 10+998 LT-"STOP"

TEMPORARY LETTERS OR SYMBOLS

- STA 10+966 RT-"STOP"
- STA 10+980 LT-RIGHT TURN ARROW (TH 340)
- STA 10+980 LT-"STOP" (TH 340)
- STA 10+983 LT-"STOP" (TH 340)
- STA 10+983 LT-LEFT TURN ARROW (TH 340)
- STA 10+998 LT-"STOP"

DURABLE CROSSWALK MARKINGS W/DIAGONAL LINES (MOD)

- STA 10+969 LT TO RT
- STA 10+970 TO 10+978 RT
- STA 10+975 TO 10+993 LT
- STA 10+994 LT TO RT

TEMPORARY CROSSWALK MARKINGS W/DIAGONAL LINES

- STA 10+969 LT TO RT
- STA 10+970 TO 10+978 RT
- STA 10+975 TO 10+993 LT
- STA 10+994 LT TO RT

ADJUST ELEVATION OF VALVE BOX

- STA 10+971 RT
- STA 10+972 RT
- STA 10+986 LT
- STA 10+989 RT (3)
- STA 11+067 RT
- STA 11+068 RT

REHABILITATION OF DI, CB, OR MH, CLASS I

- STA 10+966 RT (CB)
- STA 10+971 LT (CB)
- STA 10+992 LT (CB)
- STA 11+056 RT (CB)
- STA 11+069 LT (CB)

CHANGING ELEVATION OF SEWER MANHOLE

- STA 11+014 LT


REMOVING SIGNS

- AS SHOWN - 12 9

ERECTING SALVAGED SIGNS

- AS SHOWN - 4

STA 11+120.00 (MM 6.910)

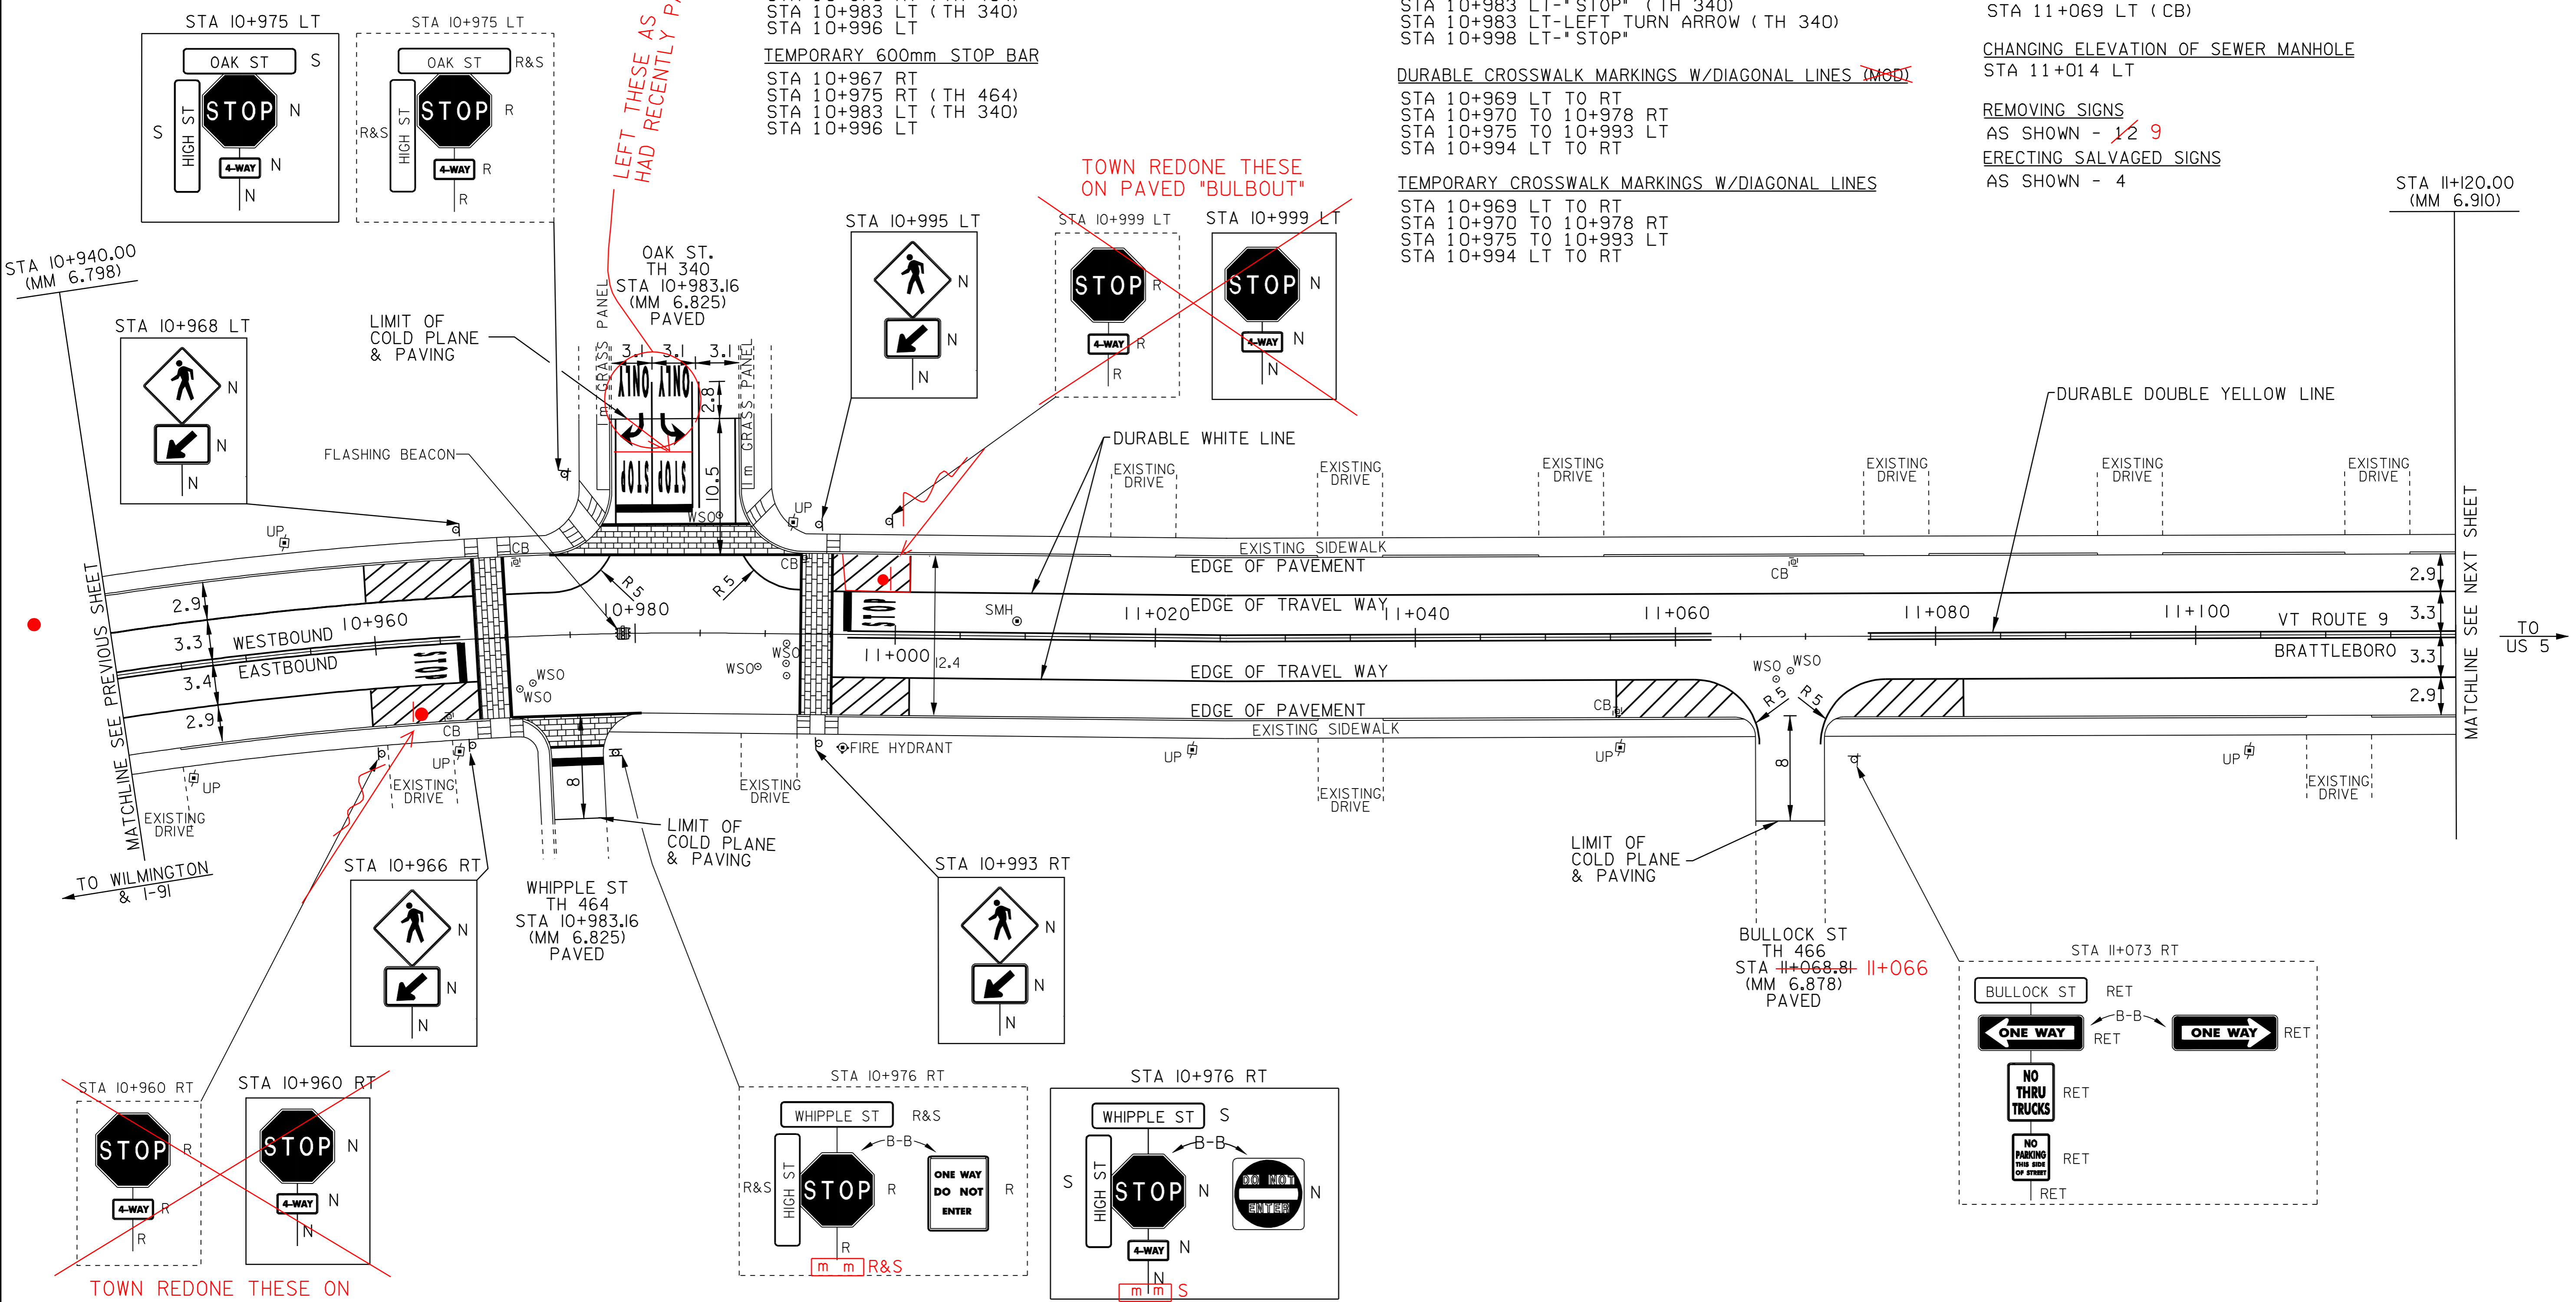

TOWN REDONE THESE ON RAISED CURBED "BULBOUT"

LEFT THESE AS TOWN HAD RECENTLY PAINTED THEM

TOWN REDONE THESE ON PAVED "BULBOUT"

NOTE: ALL DIMENSIONS IN METERS EXCEPT AS INDICATED

NOT TO SCALE

- LEGEND**
- R = REMOVE EXISTING
  - S = SALVAGE
  - R&S = REMOVE AND SALVAGE
  - N = NEW
  - RET = RETAIN
  - B-B = BACK TO BACK

<p><b>PAVING PROJECT LAYOUT #24</b></p>	PROJECT NAME: BRATTLEBORO	FILE NAME: \PAVE\QIDQ26\PDQ26.dgn	PLOT DATE: \$DATE\$
	PROJECT NUMBER: SI-STP_2303(I)S	DESIGNED BY: WRH	DRAWN BY: JAC
	CLD REF. NO.: pd026i24.i	CHECKED BY: NLL	SHEET 32 OF 55