

TEMPORARY AND DURABLE 100mm WHITE LINE

- STA 11+280 TO 11+301 SOLID LT
- STA 11+280 TO 11+283 SOLID RT
- STA 11+291 TO 11+356 SOLID RT
- STA 11+295 TO 11+301 SOLID LT (NO PARKING)
- STA 11+310 TO 11+356 SOLID LT (NO PARKING)
- STA 11+310 TO 11+356 SOLID LT

DURABLE 100mm WHITE LINE (TYPE-TAPE)

- STA 11+295 TO 11+320 SOLID RT (LANE LINE)
- STA 11+326 TO 11+356 SOLID RT (LANE LINE)

TEMPORARY 100mm WHITE LINE

- STA 11+314 TO 11+320 SOLID RT (LANE LINE)
- STA 11+326 TO 11+356 SOLID RT (LANE LINE)

TEMPORARY AND DURABLE 100mm YELLOW LINE

- STA 11+280 TO 11+281 SOLID LT & RT
- STA 11+293 TO 11+356 SOLID LT & RT

DURABLE 600mm STOP BAR (TYPE-TAPE)

- STA 11+320 RT
- STA 11+340 RT
- STA 11+355 RT

TEMPORARY 600mm STOP BAR

- STA 11+320 RT
- STA 11+340 RT
- STA 11+355 RT

DURABLE LETTER OR SYMBOL (TYPE-TAPE)

- STA 11+314 RT - "ONLY" (2)
- STA 11+318 RT - LEFT TURN ARROW
- STA 11+318 RT - RIGHT TURN ARROW
- STA 11+334 RT - "ONLY"
- STA 11+337 RT - LEFT TURN ARROW
- STA 11+349 RT - "ONLY"
- STA 11+353 RT - RIGHT TURN ARROW

TEMPORARY LETTERS OR SYMBOLS

- STA 11+318 RT - LEFT TURN ARROW
- STA 11+318 RT - RIGHT TURN ARROW
- STA 11+337 RT - LEFT TURN ARROW
- STA 11+353 RT - RIGHT TURN ARROW

DURABLE CROSSWALK MARKINGS W/DIAGONAL LINES (MOD)

STA 11+357 LT TO RT

TEMPORARY CROSSWALK MARKINGS W/DIAGONAL LINES

STA 11+357 LT TO RT

ADJUST ELEVATION OF VALVE BOX

- STA 11+286 LT
- STA 11+286 RT
- STA 11+290 RT
- STA 11+292 RT
- STA 11+293 RT
- STA 11+295 RT
- STA 11+306 RT
- STA 11+307 RT
- STA 11+329 RT
- STA 11+330 RT
- STA 11+331 RT
- STA 11+332 RT
- STA 11+352 RT
- STA 11+357 LT

REHABILITATION OF DI, CB, OR MH, CLASS I

- STA 11+293 RT (CB)
- STA 11+301 LT (CB)
- STA 11+348 LT (CB)
- STA 11+353 RT (CB)


CHANGING ELEVATION OF SEWER MANHOLE

- STA 11+282 LT
- STA 11+348 LT


REMOVING SIGNS

AS SHOWN - 1 ✓

VT ROUTE 9
STA ~~11+360.00~~ 11+345
(MM 7.059)
END PROJECT
ST-STP 2303(1)S

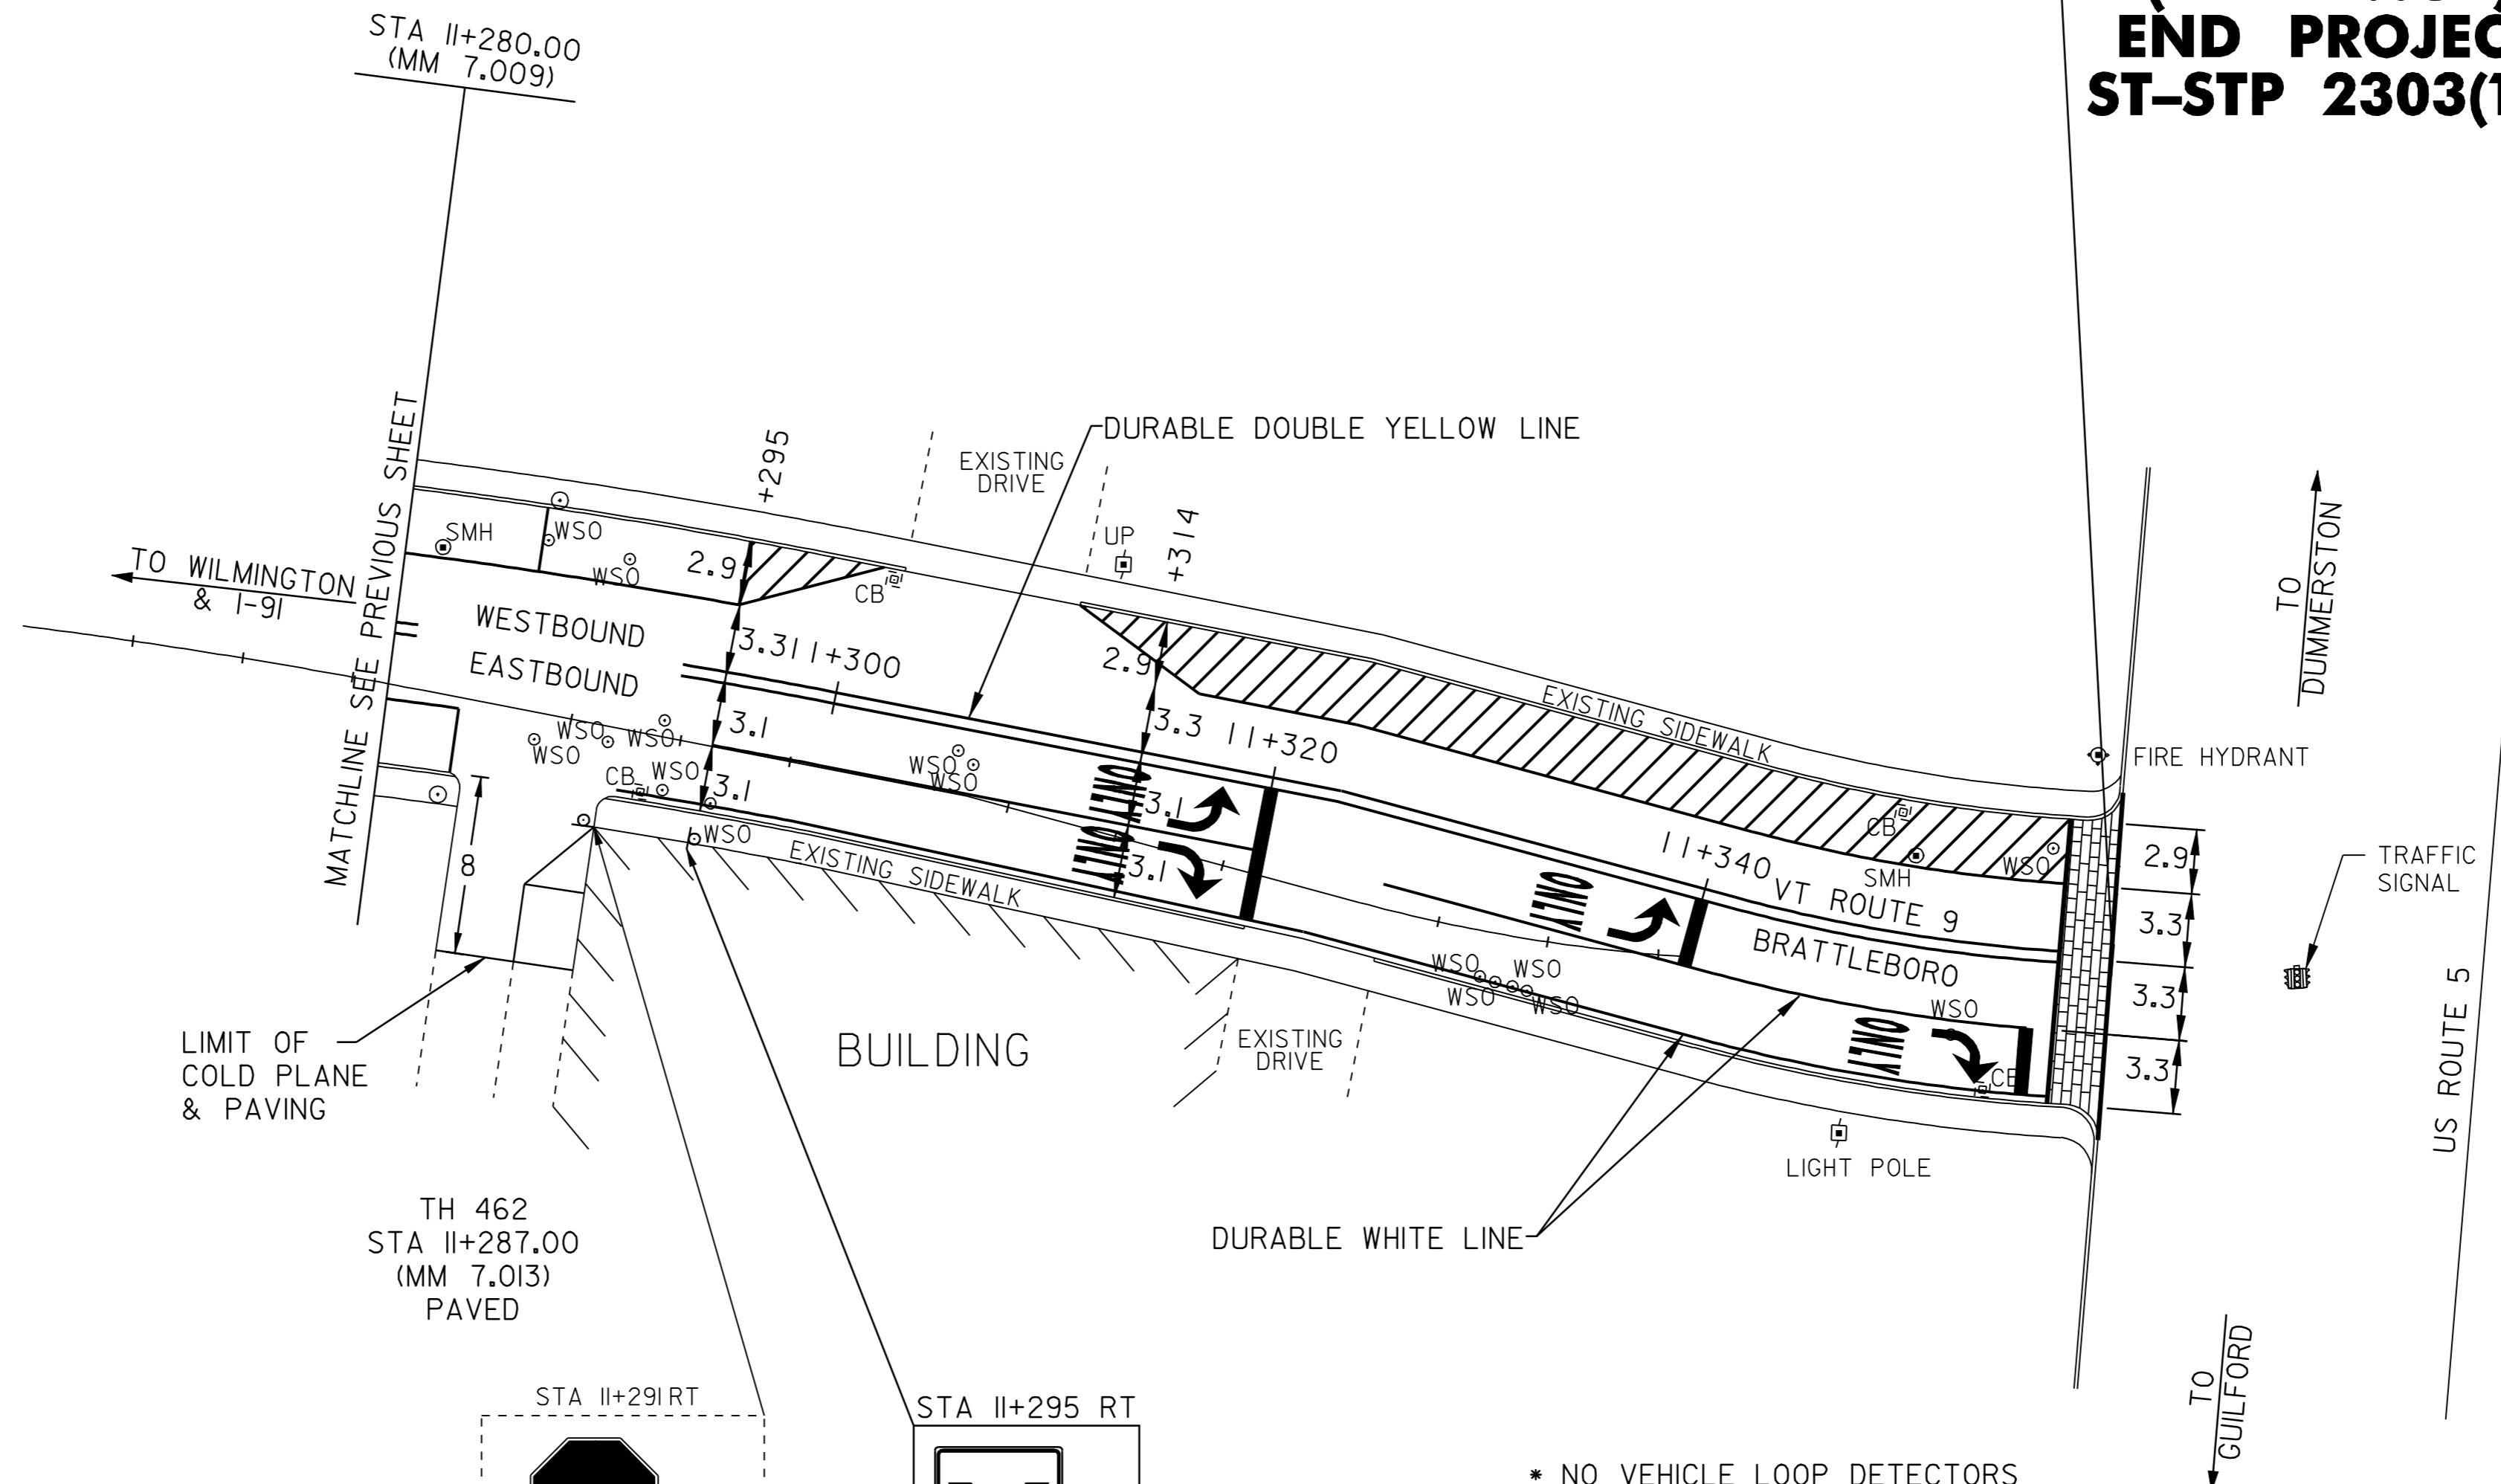

* NO VEHICLE LOOP DETECTORS ON VT ROUTE 9 AT US ROUTE 5 PER THE TOWN OF BRATTLEBORO.

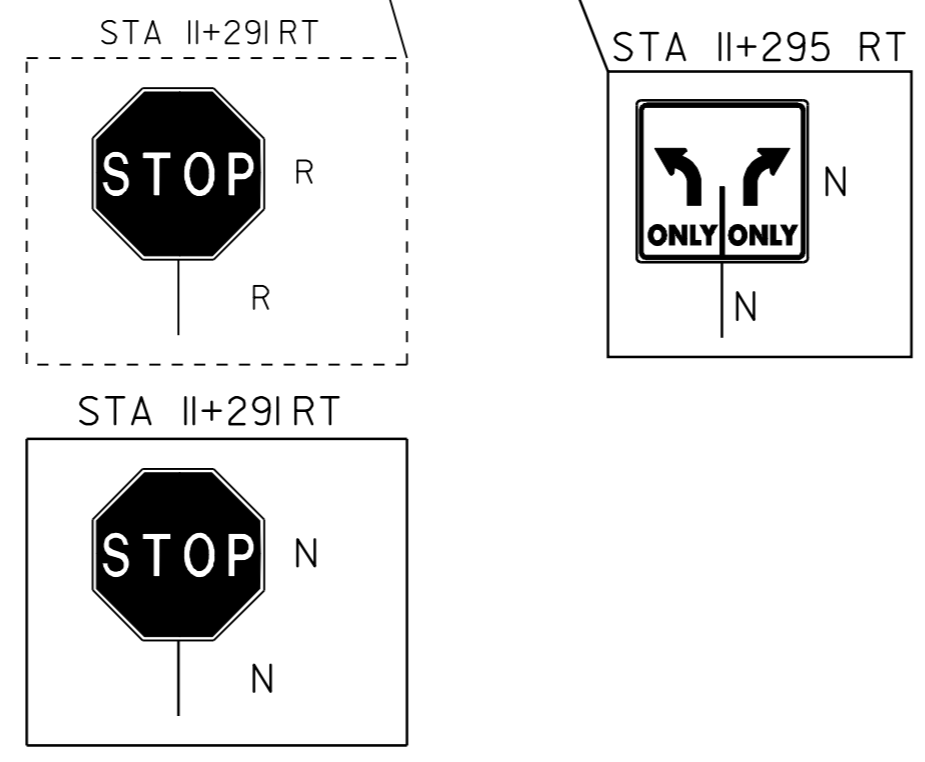

NOT TO SCALE

LEGEND

R	= REMOVE EXISTING
S	= SALVAGE
R&S	= REMOVE AND SALVAGE
N	= NEW
RET	= RETAIN
B-B	= BACK TO BACK

NOTE: ALL DIMENSIONS IN METERS EXCEPT AS INDICATED

PAVING PROJECT LAYOUT #26	PROJECT NAME: BRATTLEBORO	FILE NAME: \PAVE\QD026\PD026.dgn	PLOT DATE: \$DATE\$
	PROJECT NUMBER: ST-STP_2303(1)S	DESIGNED BY: WRH	DRAWN BY: JAC
	CHECKED BY: NLL	CLD REF. NO.: qd026\26.i	SHEET 34 OF 55