
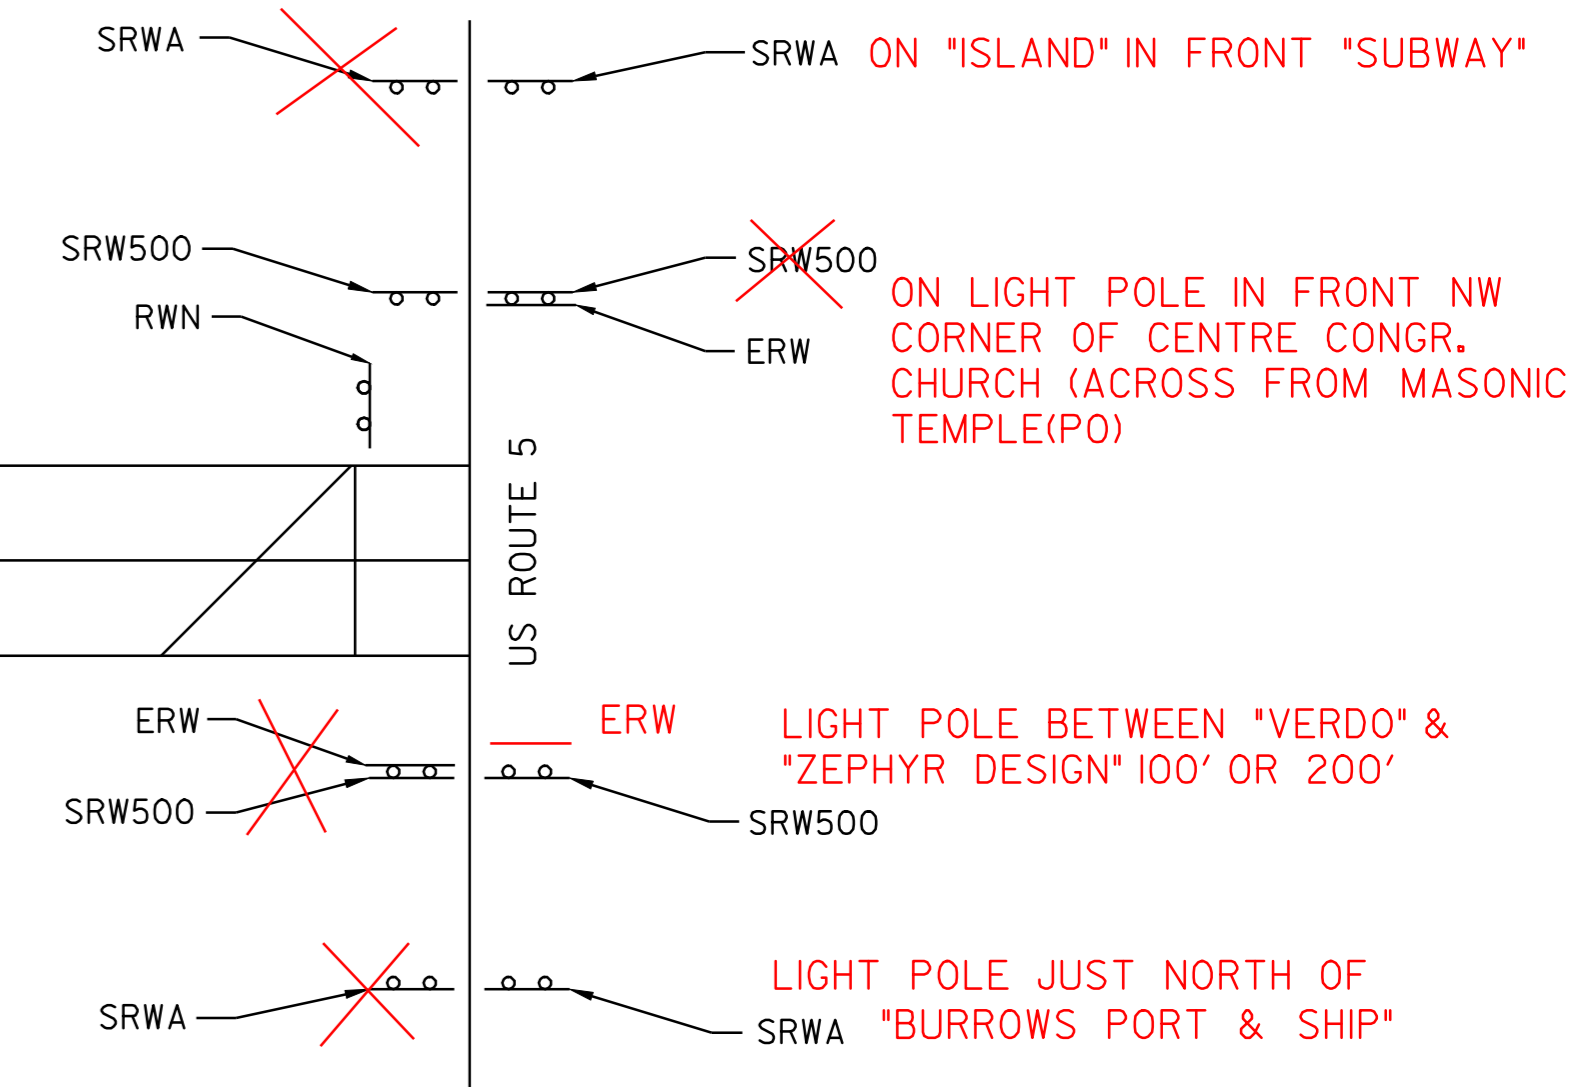
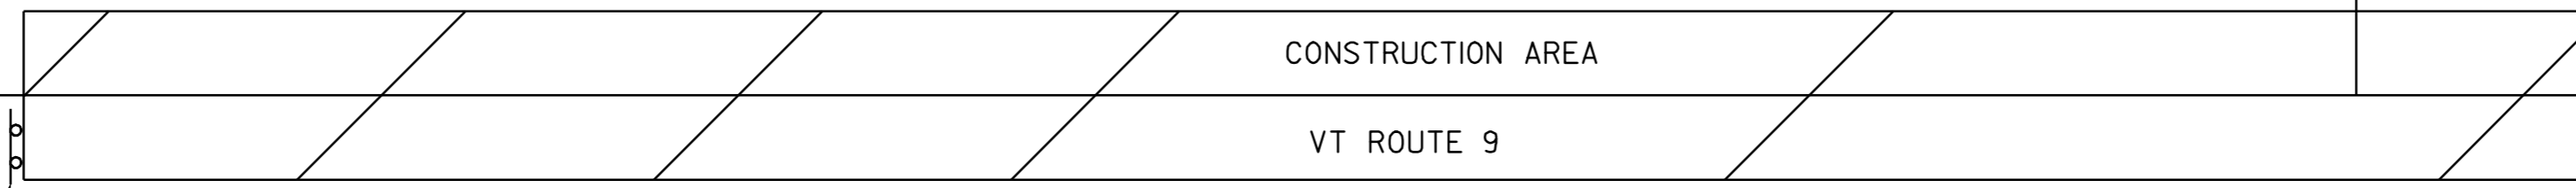


LEGEND

- RWA = ROAD WORK AHEAD
- RW500 = ROAD WORK 500'
- RWN = ROAD WORK NEXT 3 MILES
- ERW = END ROAD WORK
- SRWA = SIDE ROAD WORK AHEAD
- SRW500 = SIDE ROAD WORK 500'

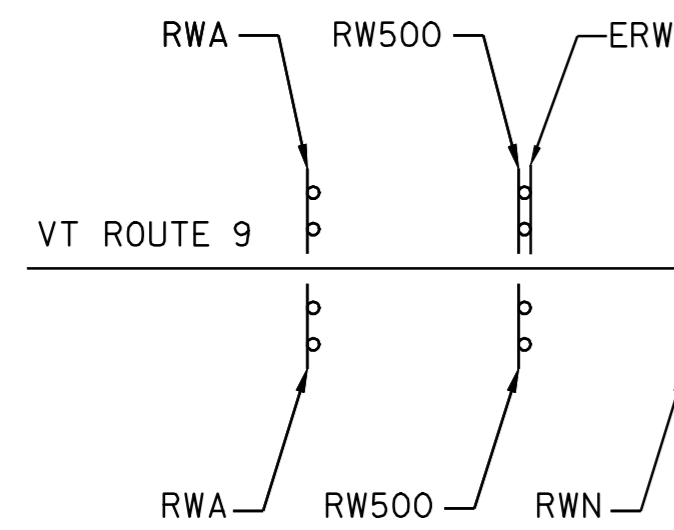

CONSTRUCTION APPROACH SIGNING

NOT TO SCALE

SEE STD E-100M FOR SIGN PLACEMENT

NOTE: WHEN DIRECTED BY THE RESIDENT ENGINEER, "NO OUTLET" SIDE ROADS WILL NOT REQUIRE CONSTRUCTION SIGNING

LIST OF TOWN/STATE HIGHWAYS FOR CONSTRUCTION SIGNS

TOWN/STATE HIGHWAY NAME	ROAD WORK AHEAD	END ROAD WORK	ROAD WORK 500'	ROAD WORK NEXT 3 MILES	SIDE ROAD WORK AHEAD	SIDE ROAD WORK 500'	OTHER
BRATTLEBORO							
TH 702	1	1					
TH 705	1	1					
TH 704		1					
TH 703	1	1					
SA.6	1	1					
TH 710	1	1					
TH 712	1	1					
TH 714 (LEG 1)	1	1					
TH 714 (LEG 2)	1	1					
TH 715	1	1					
TH 716	1	1					
TH 372	1	1					
TH 374	1	1					
TH 304	1	1					
TH 378 (LEG 1)	1	1					
TH 378 (LEG 2)	1	1					
TH 306	1	1					
RAMP D	1						
RAMP C		1					
RAMP B	1						
RAMP A		1					
TH 308	1	1					
TH 380	1	1					
TH 310	1	1					
TH 382	1	1					
TH 314	1	1					
TH 322	1	1					
TH 324	1	1					
TH 448	1	1					
TH 328	1	1					
TH 462	1	1					
TH 332	1	1					
TH 340	1	1					
TH 464	1						
TH 466		1					
TH 462	1	1					
BEGINING OF PROJECT	2	1	2	1	0	0	
END OF PROJECT	0	2	0	1	4	4	
TOTAL	34	36	2	2	4	4	

CONSTRUCTION APPROACH SIGNING

PROJECT NAME: BRATTLEBORO
PROJECT NUMBER: ST-STP 2303(I)S

FILE NAME: /PAVE/01026/PD026.dgn PLOT DATE: \$DATE\$
PROJECT LEADER: WRH DRAWN BY: JAC
DESIGNED BY: - CHECKED BY: NLL
CLD REF. NO.: pd026cas.1 SHEET 55 OF 55