

US ROUTE 7
STA. 0+00 = MM 0.000
BEGIN PROJECT STP 2307(1)S

DURABLE LETTER OR SYMBOL, TYPE I TAPE
 STA 2+64 ~ 2+77 RT (↑) (↓)
 STA 4+00 ~ 4+27 RT (↑) (↓)

TEMPORARY LETTER OR SYMBOL, PAINT
 STA 2+64 ~ 2+77 RT (↑) (↓)
 STA 4+00 ~ 4+27 RT (↑) (↓)

TEMPORARY 24" STOP BAR, PAINT
 STA 4+18 LT-RT

DURABLE 24" STOP BAR, TYPE I TAPE
 STA 4+18 LT-RT

TEMPORARY 4" YELLOW LINE, PAINT
 STA 0+00 ~ 4+26 C.L. (PAINTED ISLAND)

DURABLE 4" YELLOW LINE, TYPE I TAPE
 STA 0+00 ~ 4+26 C.L. (PAINTED ISLAND)

REMOVING SIGNS
 AS SHOWN-9 EA


TEMPORARY 4" WHITE LINE, PAINT
 STA 0+00 ~ 4+19 RT (EDGE LINE--SOLID)
 STA 0+00 ~ 4+50 LT (EDGE LINE--SOLID)
 STA 2+64 ~ 4+17 RT (LANE LINE)

DURABLE 4" WHITE LINE, TYPE I TAPE
 STA 0+00 ~ 4+19 RT (EDGE LINE--SOLID)
 STA 0+00 ~ 4+50 LT (EDGE LINE--SOLID)
 STA 2+64 ~ 4+17 RT (LANE LINE)

DURABLE 8" YELLOW LINE, TYPE I TAPE
 STA 2+00 ~ 4+124 LT (DIAG.--ISLAND)

CHANGING ELEV. OF SEWER MANHOLES
 STA 2+00 - 20' RT
 STA 4+83 - 24' RT

REHABING DI, CB, OR MH, CLASS 1
 STA 0+96 - 23' RT (DI)
 STA 0+97 - 22' LT (DI)
 STA 4+55 - 37' LT (DI)

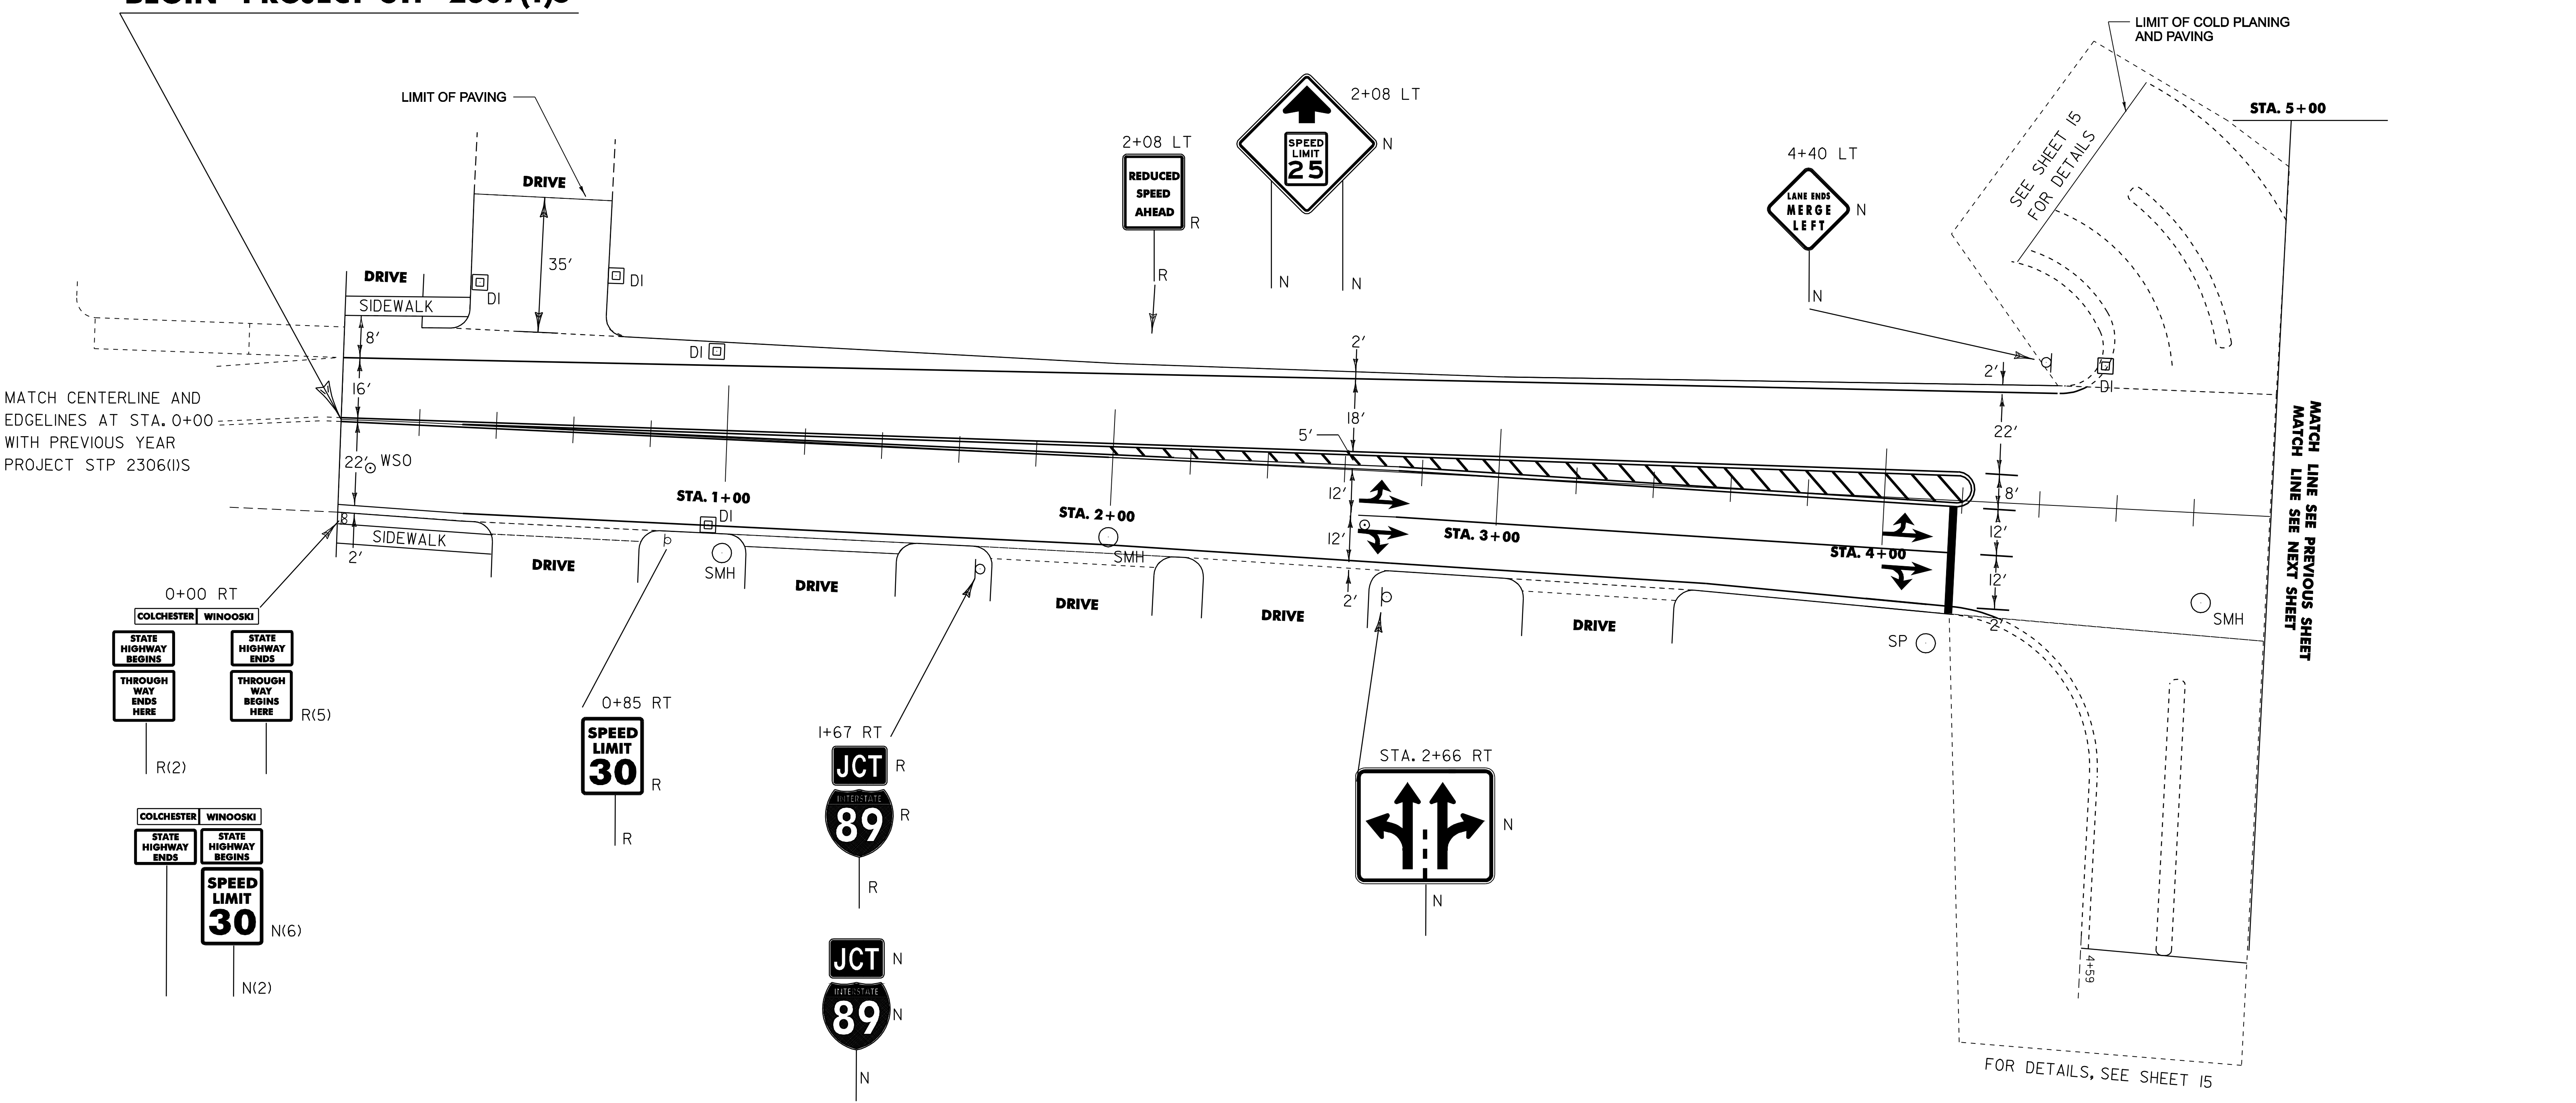

LEGEND

N = NEW
 R = REMOVE
 RET = RETAIN

PROJECT LAYOUT SHEET 1

PROJECT NAME:	COLCHESTER	PLOT DATE:	23-APR-2009 15:3
PROJECT NUMBER:	STP 2307(1)S	DRAWN BY:	LSW
FILE NAME:	/pave01d044p01d044.dgn	CHECKED BY:	LSW
IPARM NAME:	p01d044i01.i	SHEET	6 OF 26