



STA. 12+30 LT

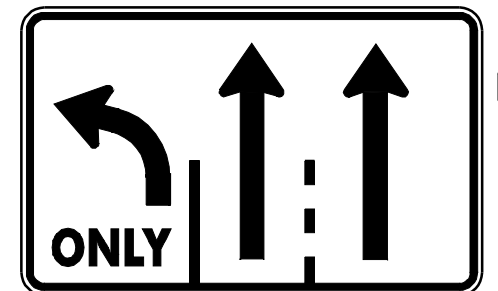

N

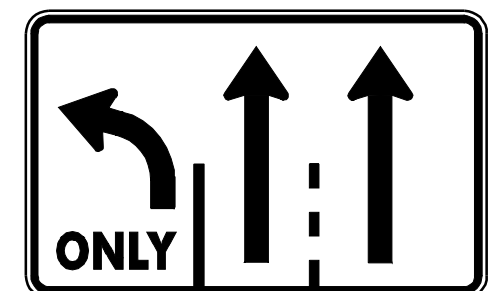

R

STA. 11+00

TEMPORARY LETTER OR SYMBOL, PAINT

- STA 11+67 ~ 11+75 LT (N)
- STA 11+99 ~ 12+09 RT (T)(16' RT)
- STA 12+01 ~ 12+09 RT (N)
- STA 12+19 ~ 12+29 LT (T)(18' LT)
- STA 12+19 ~ 12+29 LT (T)(29' LT)
- STA 12+19 ~ 12+29 LT (T)(18' LT)
- STA 12+19 ~ 12+29 LT (T)(29' LT)
- STA 13+24 ~ 13+33 LT (N)
- STA 13+24 ~ 13+33 LT (T)
- STA 13+24 ~ 13+38 LT (T)
- STA 13+24 ~ 13+38 LT (N)
- STA 13+84 ~ 13+92 LT (ONLY)
- STA 14+46 ~ 14+54 LT (N)
- STA 15+02 ~ 15+12 RT (T)(18' RT)
- STA 15+02 ~ 15+12 RT (T)(29' RT)
- STA 15+40 ~ 15+54 LT (T)
- STA 15+44 ~ 15+54 LT (T)
- STA 15+61 ~ 15+69 LT (N)
- STA 15+81 ~ 15+89 RT (N)
- STA 16+17 ~ 16+27 RT (T)(18' RT)
- STA 16+17 ~ 16+27 RT (T)(29' RT)
- STA 16+78 ~ 16+87 LT (N)

DURABLE LETTER OR SYMBOL, TYPE I TAPE

- STA 11+14 ~ 11+23 LT (ONLY)
- STA 11+42 ~ 11+50 RT (ONLY)
- STA 11+67 ~ 11+75 LT (N)
- STA 11+99 ~ 12+09 RT (T)(16' RT)
- STA 12+01 ~ 12+09 RT (N)
- STA 12+20 ~ 12+28 LT (ONLY)
- STA 12+19 ~ 12+29 LT (T)(18' LT)
- STA 12+19 ~ 12+29 LT (T)(29' LT)
- STA 13+24 ~ 13+33 LT (N)
- STA 13+24 ~ 13+33 LT (T)
- STA 13+24 ~ 13+38 LT (T)
- STA 13+84 ~ 13+92 LT (ONLY)
- STA 14+46 ~ 14+54 LT (N)
- STA 15+02 ~ 15+10 RT (ONLY)
- STA 15+02 ~ 15+10 LT (ONLY)
- STA 15+02 ~ 15+12 RT (T)(18' RT)
- STA 15+02 ~ 15+12 RT (T)(29' RT)
- STA 15+40 ~ 15+54 LT (T)
- STA 15+44 ~ 15+54 LT (T)
- STA 15+61 ~ 15+69 LT (N)
- STA 15+81 ~ 15+89 RT (N)
- STA 16+17 ~ 16+27 RT (T)(18' RT)
- STA 16+17 ~ 16+27 RT (T)(29' RT)
- STA 16+20 ~ 16+28 LT (ONLY)
- STA 16+62 ~ 16+70 RT (ONLY)
- STA 16+78 ~ 16+87 LT (N)

- TEMPORARY 4" YELLOW LINE, PAINT
- STA 11+00 ~ 12+30 C.L. (CTR. LINE--DBL.--SOLID)
- STA 12+30 ~ 13+06 C.L. (CTR. LINE--DOTTED)
- STA 13+00 ~ 14+67 C.L. (DBL.--ISLAND)
- STA 14+67 ~ 17+00 C.L. (CTR. LINE--DBL.--SOLID)

- DURABLE 4" YELLOW LINE, TYPE I, TAPE
- STA 11+00 ~ 12+30 C.L. (CTR. LINE--DBL.--SOLID)
- STA 12+30 ~ 13+06 C.L. (CTR. LINE--DOTTED)
- STA 13+00 ~ 14+67 C.L. (DBL.--ISLAND)
- STA 14+67 ~ 17+00 C.L. (CTR. LINE--DBL.--SOLID)

- TEMPORARY 6" YELLOW LINE, PAINT
- STA 12+71 ~ 12+95 LT (RAMP B)


- DURABLE 6" YELLOW LINE, TYPE I TAPE
- STA 12+71 ~ 12+95 LT (RAMP B)

- DURABLE 8" YELLOW LINE, TYPE I TAPE
- STA 13+03 ~ 14+56 RT (DIAG.--ISLAND)

- TEMPORARY 6" WHITE LINE, PAINT
- STA 13+10 ~ 13+15 LT (RAMP B)

- DURABLE 6" WHITE LINE, TYPE I TAPE
- STA 13+10 ~ 13+15 LT (RAMP B)

STA. 14+90 LT

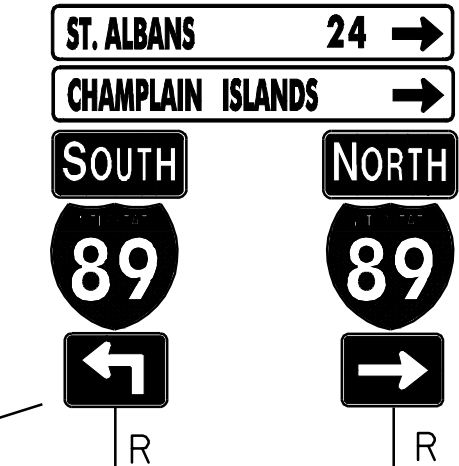

ST. ALBANS 24



CHAMPLAIN ISLANDS



SOUTH 89




NORTH 89



STA. 17+00

MATCH LINE SEE PREVIOUS SHEET

MATCH LINE SEE NEXT SHEET

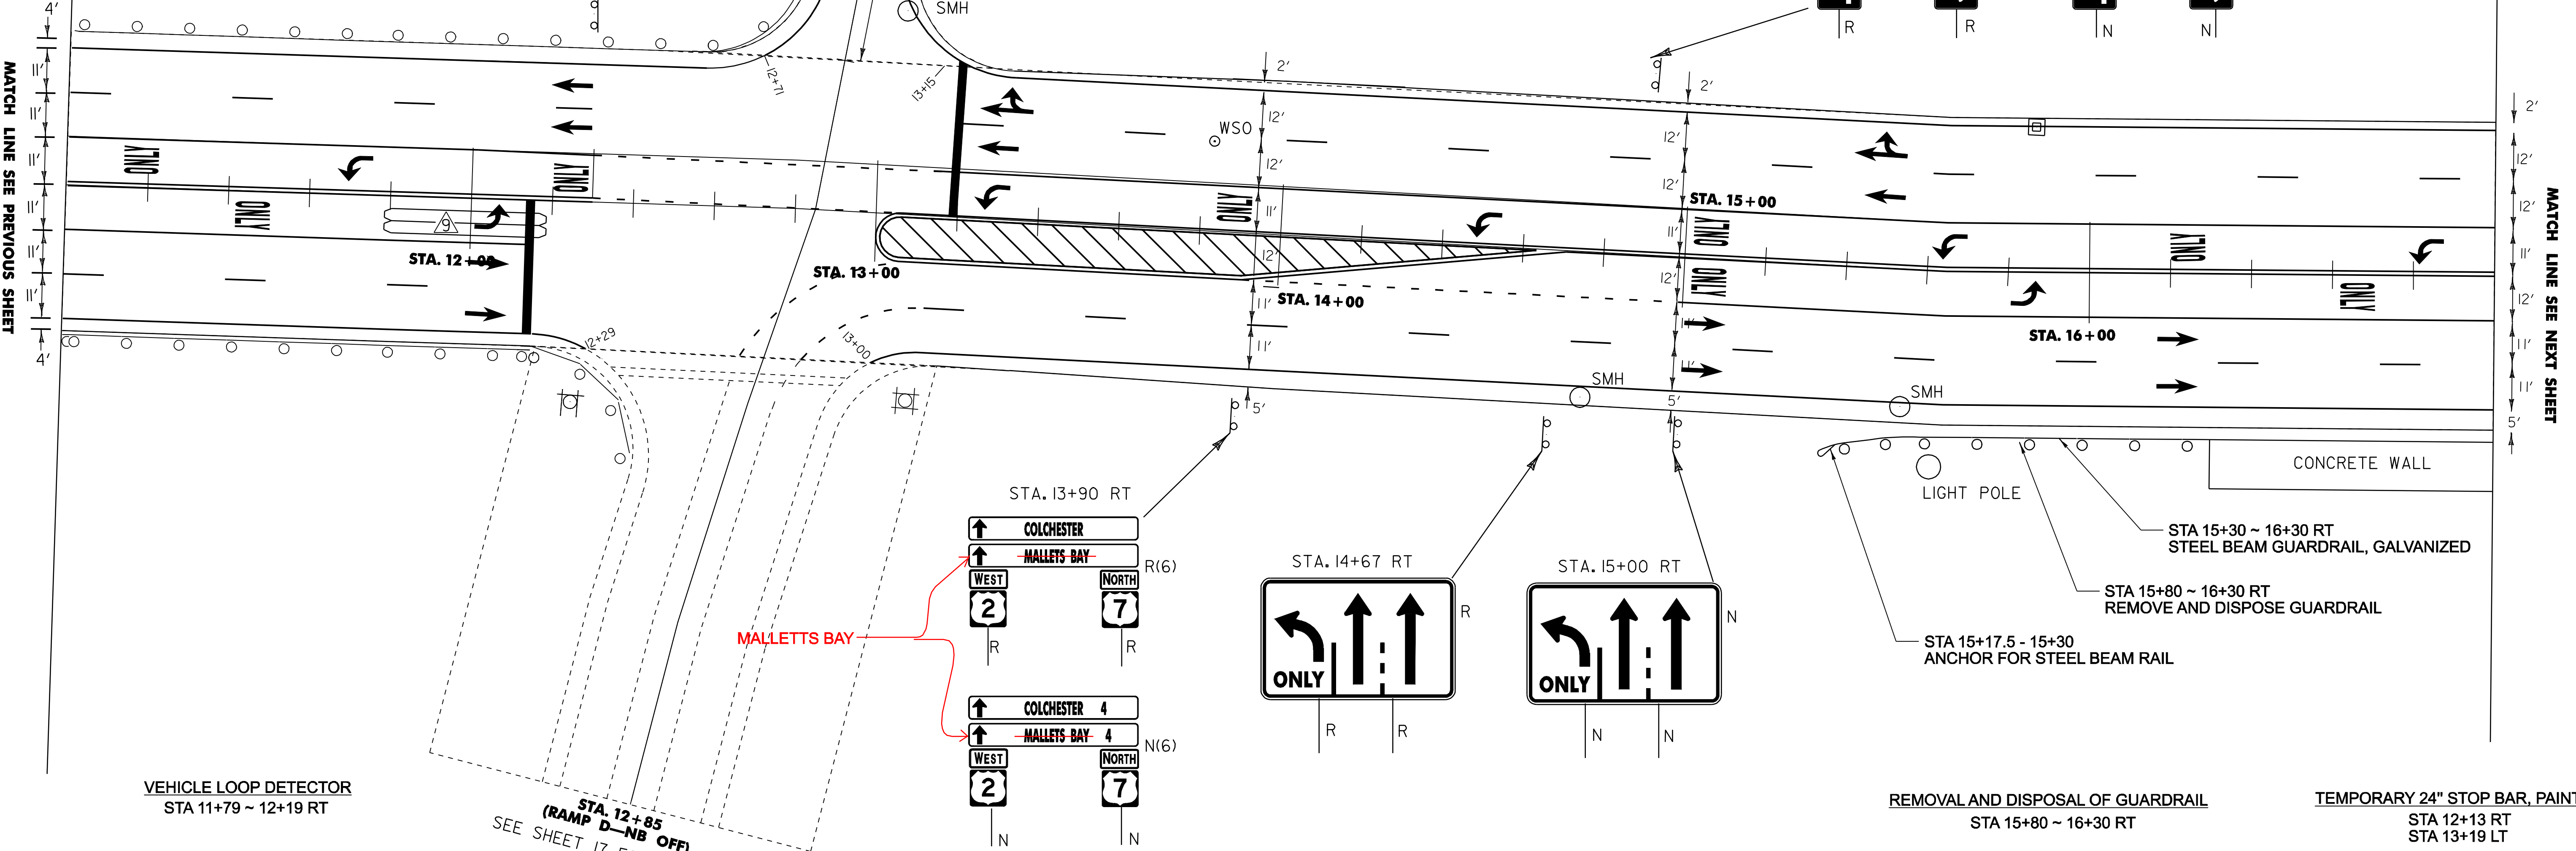


VEHICLE LOOP DETECTOR
STA 11+79 ~ 12+19 RT

REHABING DI. CB. OR MH. CLASS 1
STA 15+85 - 36' LT (DI)

CHANGING ELEV. OF SEWER MANHOLES
STA 13+06 - 50' LT
STA 14+76 - 36' RT
STA 15+55 - 34' RT

REMOVING SIGNS
AS SHOWN--21 EA

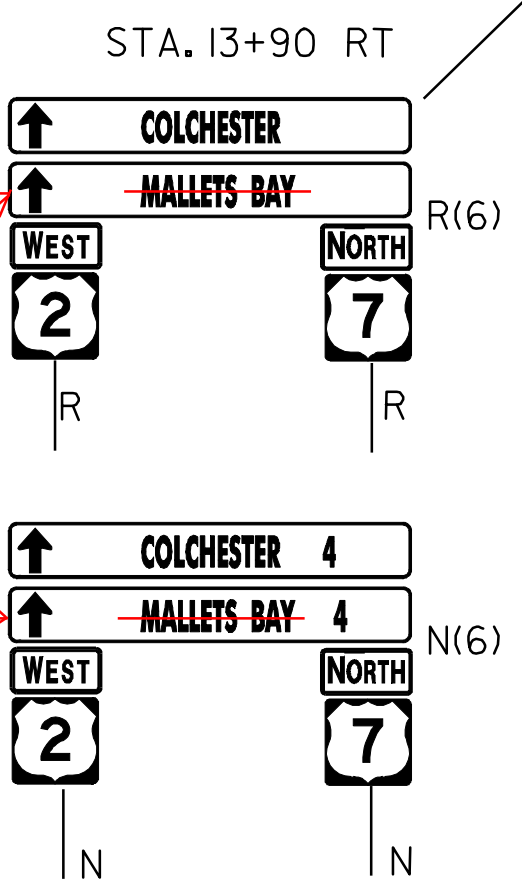

TEMPORARY 4" WHITE LINE, PAINT

- STA 11+00 ~ 17+00 LT (LANE LINE--SOLID)(12' LT)
- STA 11+00 ~ 12+29 LT (LANE LINE--DASHED)(23' LT)
- STA 11+00 ~ 12+71 LT (EDGE LINE--SOLID)
- STA 11+00 ~ 12+15 RT (LANE LINE--SOLID)(11' RT)
- STA 11+00 ~ 12+15 RT (LANE LINE--DASHED)(22' RT)
- STA 11+00 ~ 12+29 RT (EDGE LINE--SOLID)
- STA 13+00 ~ 17+00 RT (EDGE LINE--SOLID)
- STA 13+15 ~ 17+00 LT (EDGE LINE--SOLID)
- STA 13+34 ~ 17+00 RT (LANE LINE--DASHED)(23' RT)
- STA 13+20 ~ 17+00 LT (LANE LINE--DASHED)
- STA 13+90 ~ 15+00 RT (DOTTED LINE)
- STA 15+00 ~ 17+00 RT (LANE LINE--SOLID)

DURABLE 4" WHITE LINE, TYPE I TAPE

- STA 11+00 ~ 17+00 LT (LANE LINE--SOLID)(12' LT)
- STA 11+00 ~ 12+29 LT (LANE LINE--DASHED)(23' LT)
- STA 11+00 ~ 12+71 LT (EDGE LINE--SOLID)
- STA 11+00 ~ 12+15 RT (LANE LINE--SOLID)(11' RT)
- STA 11+00 ~ 12+15 RT (LANE LINE--DASHED)(22' RT)
- STA 11+00 ~ 12+29 RT (EDGE LINE--SOLID)
- STA 13+00 ~ 17+00 RT (EDGE LINE--SOLID)
- STA 13+15 ~ 17+00 LT (EDGE LINE--SOLID)
- STA 13+34 ~ 17+00 RT (LANE LINE--DASHED)(23' RT)
- STA 13+20 ~ 17+00 LT (LANE LINE--DASHED)
- STA 13+90 ~ 15+00 RT (DOTTED LINE)
- STA 15+00 ~ 17+00 RT (LANE LINE--SOLID)

REMOVAL AND DISPOSAL OF GUARDRAIL
STA 15+80 ~ 16+30 RT

ANCHOR FOR STEEL BEAM
STA 15+17.5 ~ 15+30 RT

STEEL BEAM GUARDRAIL, GALVANIZED
STA 15+30 ~ 16+30 RT

TEMPORARY 24" STOP BAR, PAINT
STA 12+13 RT
STA 13+19 LT

DURABLE 24" STOP BAR, TYPE I TAPE
STA 12+13 RT
STA 13+19 LT

LEGEND

- N = NEW
- R = REMOVE
- RET = RETAIN

PROJECT LAYOUT SHEET 3

PROJECT NAME:	COLCHESTER	FILE NAME:	/pave01d044/p01d044.dgn	PLOT DATE:	23-APR-2009 15:3
PROJECT NUMBER:	STP 2307(1)S	PROJECT LEADER:	MW	DRAWN BY:	LSW
		IPARM NAME:	p01d044i03.i	CHECKED BY:	LSW
				SHEET	8 OF 26