

TEMPORARY LETTER OR SYMBOL, PAINT

STA 23+33 ~ 23+41 10' LT (AHEAD)
 STA 23+33 ~ 23+41 22' LT (AHEAD)
 STA 23+73 ~ 23+18 10' LT (SIGNAL)
 STA 23+73 ~ 23+18 22' LT (SIGNAL)

DURABLE LETTER OR SYMBOL, TYPE I TAPE

STA 23+33 ~ 23+41 10' LT (AHEAD)
 STA 23+33 ~ 23+41 22' LT (AHEAD)
 STA 23+73 ~ 23+18 10' LT (SIGNAL)
 STA 23+73 ~ 23+18 22' LT (SIGNAL)

DURABLE 8" YELLOW LINE, TYPE I TAPE

STA 23+00 ~ 26+25 C.L. (DIAG.--PTD. IS.)

TEMPORARY 4" YELLOW LINE, PAINT

STA 23+00 ~ 26+50 LT & RT (DBL.--SOLID--PAINTED IS.)
 STA 26+50 ~ 29+00 C.L. (CTR. LINE--DBL.--SOLID)

DURABLE 4" YELLOW LINE, TYPE 1 TAPE

STA 23+00 ~ 26+50 LT & RT (DBL.--SOLID--PAINTED IS.)
 STA 26+50 ~ 29+00 C.L. (CTR. LINE--DBL.--SOLID)

TEMPORARY 4" WHITE LINE, PAINT

STA 23+00 ~ 29+00 LT (LANE LINE--DASHED)
 STA 23+00 ~ 29+00 RT (LANE LINE--DASHED)
 STA 23+00 ~ 29+00 RT (EDGE LINE--SOLID)
 STA 23+00 ~ 29+00 LT (EDGE LINE--SOLID)


DURABLE 4" WHITE LINE, TYPE 1 TAPE

STA 23+00 ~ 29+00 LT (LANE LINE--DASHED)
 STA 23+00 ~ 29+00 RT (LANE LINE--DASHED)
 STA 23+00 ~ 29+00 RT (EDGE LINE--SOLID)
 STA 23+00 ~ 29+00 LT (EDGE LINE--SOLID)

REHABING DI, CB, OR MH, CLASS 1

STA 23+32 - 31' LT
 STA 26+67 - 29' LT
 STA 28+60 - 28' LT

REMOVING SIGNS
 AS SHOWN--1 EA

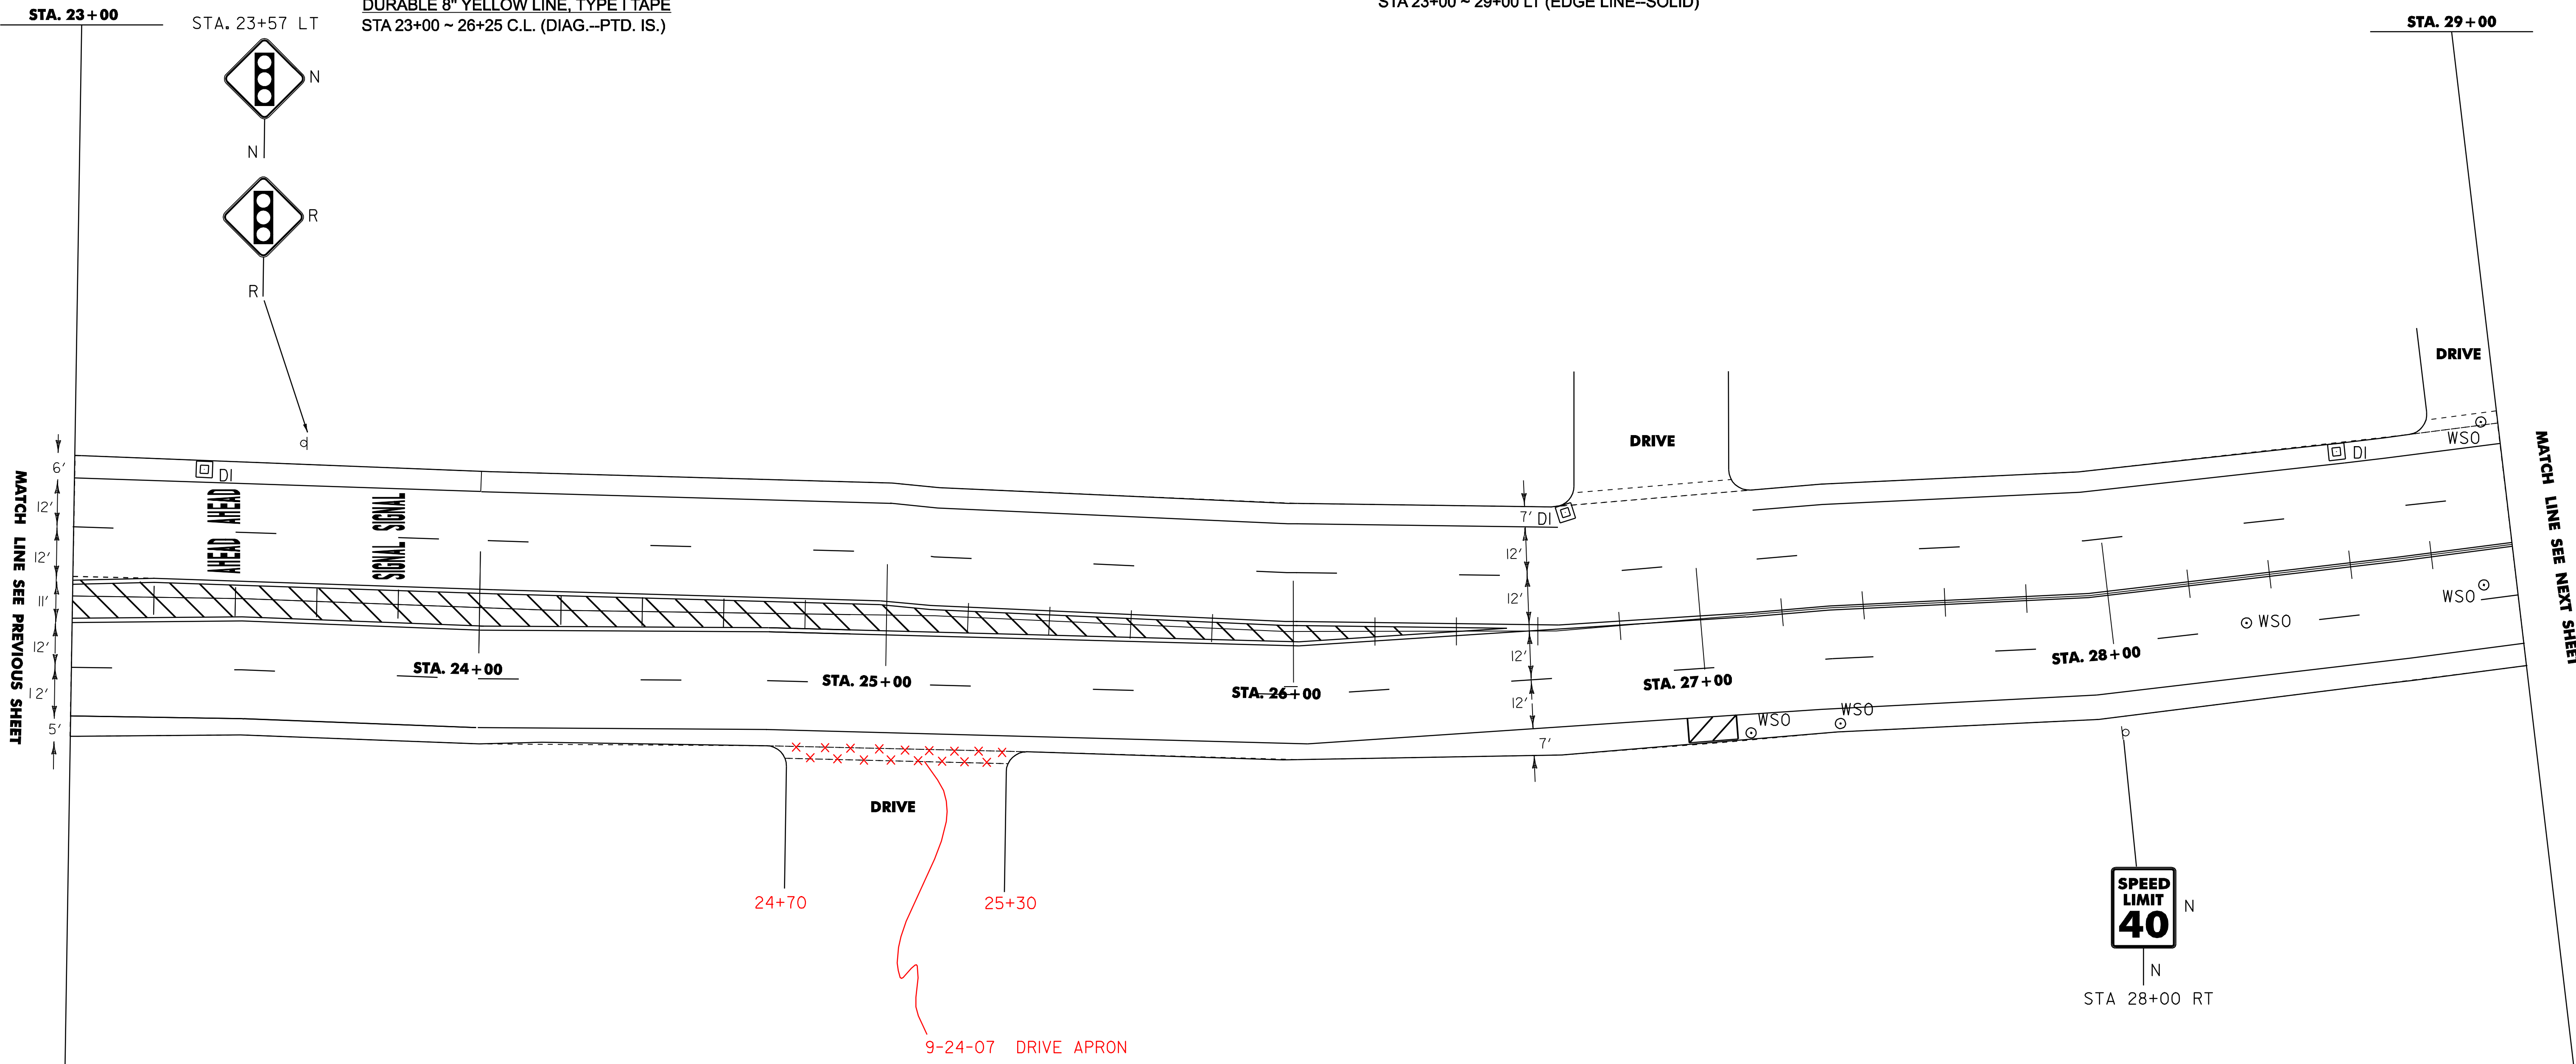

LEGEND

N = NEW
 R = REMOVE
 RET = RETAIN

PROJECT LAYOUT SHEET 5

PROJECT NAME:	COLCHESTER	PLOT DATE:	23-APR-2009 15:3
PROJECT NUMBER:	STP 2307(1)S	DRAWN BY:	LSW
FILE NAME:	/pave01d044/p01d044.dgn	CHECKED BY:	LSW
PROJECT LEADER:	MW	SHEET	10 OF 26
IPARM NAME:	p01d044i05.i		