

TEMPORARY LETTER OR SYMBOL, PAINT

STA 4+62 ~ 4+65 LT (P) (BLUE LINE DINER)
STA 4+74 ~ 4+81 LT (4) (BLUE LINE DINER)
STA 4+82 ~ 4+89 RT (4) (BUS. ACCESS)
STA 4+95 ~ 5+01 RT (P) (BUS. ACCESS)

DURABLE LETTER OR SYMBOL, TYPE I TAPE

STA 4+39 ~ 4+41 LT (ONLY) (BLUE LINE DINER)
STA 4+62 ~ 4+65 LT (P) (BLUE LINE DINER)
STA 4+74 ~ 4+81 LT (4) (BLUE LINE DINER)
STA 4+82 ~ 4+89 RT (4) (BUS. ACCESS)
STA 4+95 ~ 5+01 RT (P) (BUS. ACCESS)
STA 4+93 ~ 5+00 RT (ONLY) (BUS. ACCESS)

TEMPORARY 24" STOP BAR, PAINT

STA 4+55 ~ 4+85 LT (BLUE LINE DINER)
STA 4+80 ~ 5+08 RT (BUS. ACCESS)

DURABLE 24" STOP BAR, TYPE I TAPE

STA 4+55 ~ 4+85 LT (BLUE LINE DINER)
STA 4+80 ~ 5+08 RT (BUS. ACCESS)

TEMPORARY 4" WHITE LINE, PAINT

STA 4+18 ~ 4+54 RT (EDGE LINE--SOLID)(BUS. ACCESS)
STA 4+91 RT (LANE LINE--SOLID)(BUS. ACCESS)
STA 5+02 ~ 5+33 RT (EDGE LINE--SOLID)(BUS. ACCESS)
STA 4+34 ~ 4+44 LT (EDGE LINE--SOLID)(BLUE LINE DINER)
STA 4+40 ~ 4+73 LT (LANE LINE--SOLID)(BLUE LINE DINER)
STA 4+62 ~ 5+35 LT (EDGE LINE--SOLID)(BLUE LINE DINER)

DURABLE 4" WHITE LINE, TYPE I TAPE

STA 4+18 ~ 4+54 RT (EDGE LINE--SOLID)(BUS. ACCESS)
STA 4+91 RT (LANE LINE--SOLID)(BUS. ACCESS)
STA 5+02 ~ 5+33 RT (EDGE LINE--SOLID)(BUS. ACCESS)
STA 4+34 ~ 4+44 LT (EDGE LINE--SOLID)(BLUE LINE DINER)
STA 4+40 ~ 4+73 LT (LANE LINE--SOLID)(BLUE LINE DINER)
STA 4+62 ~ 5+35 LT (EDGE LINE--SOLID)(BLUE LINE DINER)

DURABLE 4" YELLOW LINE, TYPE I TAPE

STA 4+83 LT (EDGE LINE--SOLID)(BLUE LINE DINER)
STA 5+00 LT (LANE LINE--SOLID)(BLUE LINE DINER)
(DIAGONALS)(SOLID)(BLUE LINE DINER)


TEMPORARY 4" YELLOW LINE, PAINT

STA 4+83 LT (EDGE LINE--SOLID)(BLUE LINE DINER)
STA 5+00 LT (LANE LINE--SOLID)(BLUE LINE DINER)

VEHICLE LOOP DETECTOR

STA 4+47 ~ 4+68 LT (BLUE LINE DINER)
STA 4+62 ~ 4+82 LT (BLUE LINE DINER)
STA 4+83 ~ 4+89 RT (BUS. ACCESS)
STA 4+94 ~ 5+00 RT (BUS. ACCESS)

**BLUE LINE
DINER**

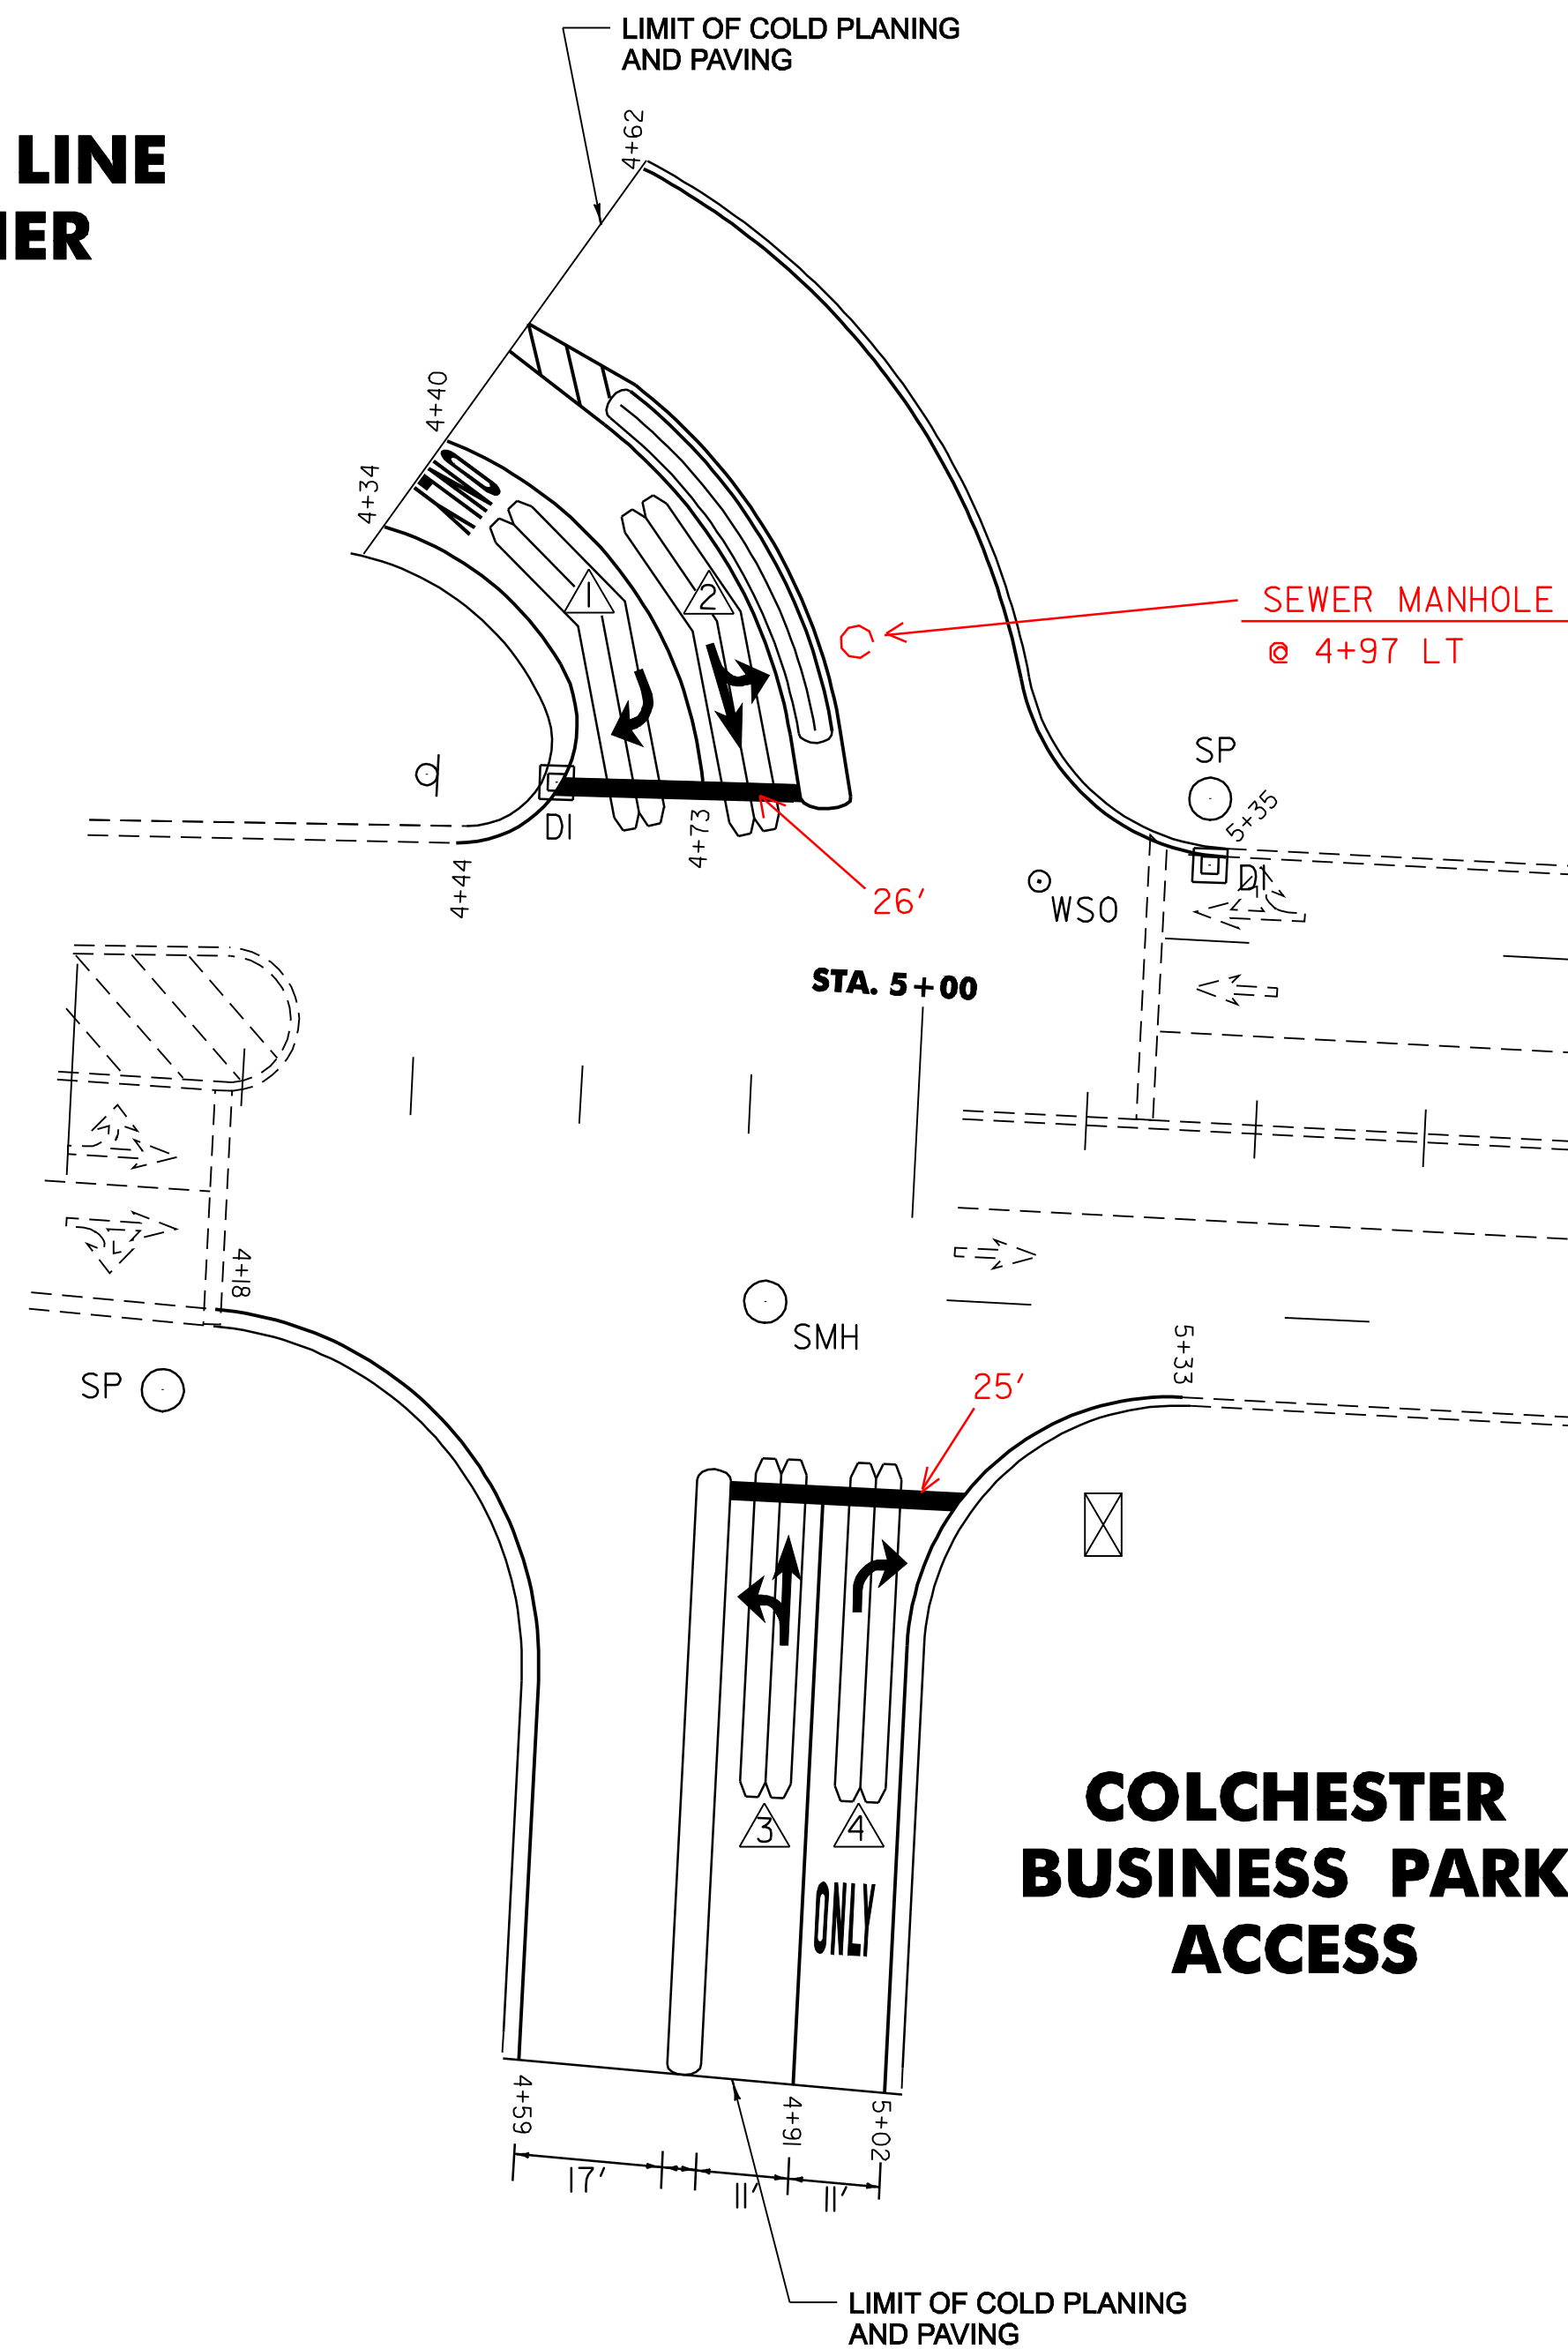

**COLCHESTER
BUSINESS PARK
ACCESS**

**INTERSECTION
DETAIL
SHEET**

PROJECT NAME: COLCHESTER	-----
PROJECT NUMBER: STP 2307(1)S	-----
FILE NAME: /pave01d044p01d044.dgn	PLOT DATE: 23-APR-2009 15:3
PROJECT LEADER: MW	DRAWN BY: LSW
IPARM NAME: p01d044d03.i	CHECKED BY: LSW
-----	SHEET 15 OF 26