

REPLACE EXISTING
BITUM. CONCRETE GUTTER
- 2-1" LIFTS
TYPE IVS
- REMOVAL OF EXISTING
PAVED GUTTER PAID AS
ITEM 608.25

**BITUMINOUS CONCRETE
GUTTER DETAIL**
COLCHESTER
STA 0+00 TO 0+36 RT
RAMP "A"

DURABLE LETTER OR SYMBOL, TYPE I TAPE

- STA 0+17 ~ 0+25 RT (↔)
- STA 0+17 ~ 0+25 LT (↔)
- STA 0+65 ~ 0+75 LT (ONLY)
- STA 1+13 ~ 1+23 LT (↔)
- STA 1+61 ~ 1+71 LT (ONLY)
- STA 2+35 ~ 2+62 C.L. (→)

TEMPORARY LETTER OR SYMBOL, PAINT

- STA 0+17 ~ 0+25 RT (↔)
- STA 0+17 ~ 0+25 LT (↔)
- STA 1+13 ~ 1+23 LT (↔)
- STA 2+35 ~ 2+62 C.L. (→)

TEMPORARY 6" YELLOW LINE, PAINT

STA 0+00 ~ 2+86 RT (EDGE LINE--SOLID)

DURABLE 6" YELLOW LINE, TYPE I TAPE

STA 0+00 ~ 2+86 RT (EDGE LINE--SOLID)

TEMPORARY 6" WHITE LINE, PAINT

STA 0+00 ~ 2+86 LT (EDGE LINE--SOLID)

DURABLE 6" WHITE LINE, TYPE I TAPE

STA 0+00 ~ 2+86 LT (EDGE LINE--SOLID)
STA 0+05 ~ 1+67 C.L. (LANE LINE--SOLID)

TEMPORARY 24" STOP BAR, PAINT

STA 0+00 ~ 0+08 LT-RT











DURABLE 24" STOP BAR, TYPE I TAPE

STA 0+00 ~ 0+08 LT-RT

REMOVING SIGNS
AS SHOWN--9 EA

BITUMINOUS CONC. GUTTERS
AND TRAFFIC ISLANDS
STA 0+00 ~ 0+36 RT

VEHICLE LOOP DETECTOR
STA 0+00 ~ 0+40 RT
STA 0+00 ~ 0+40 LT

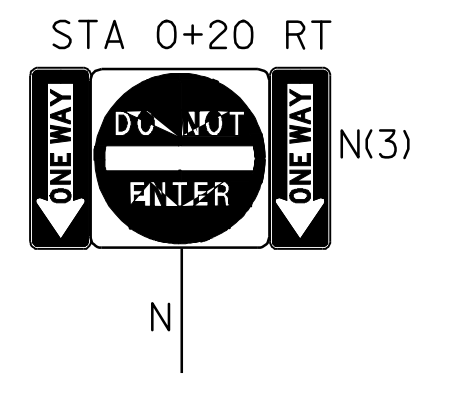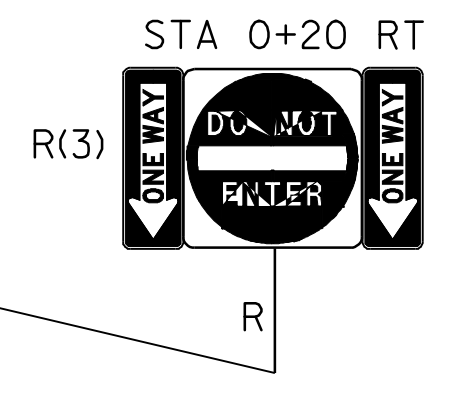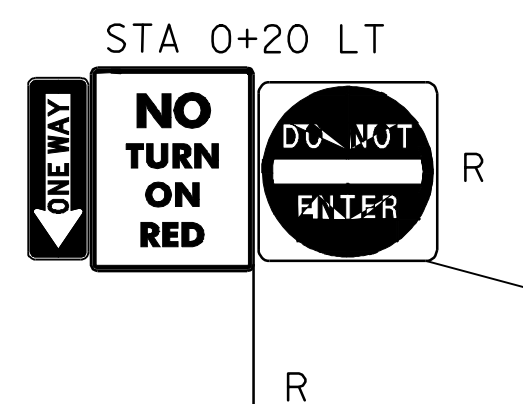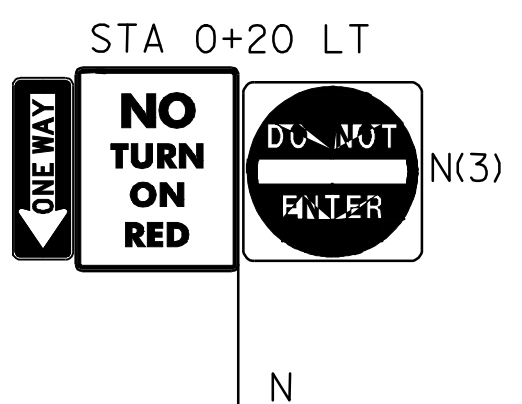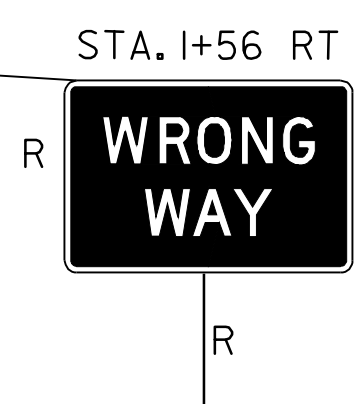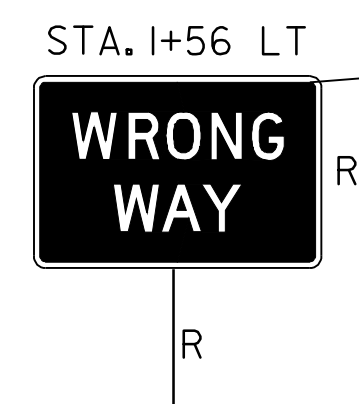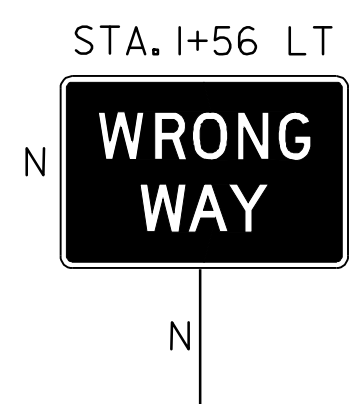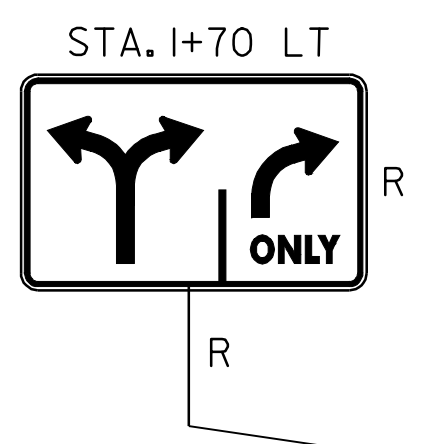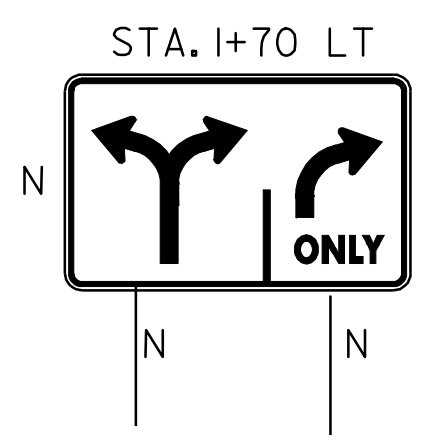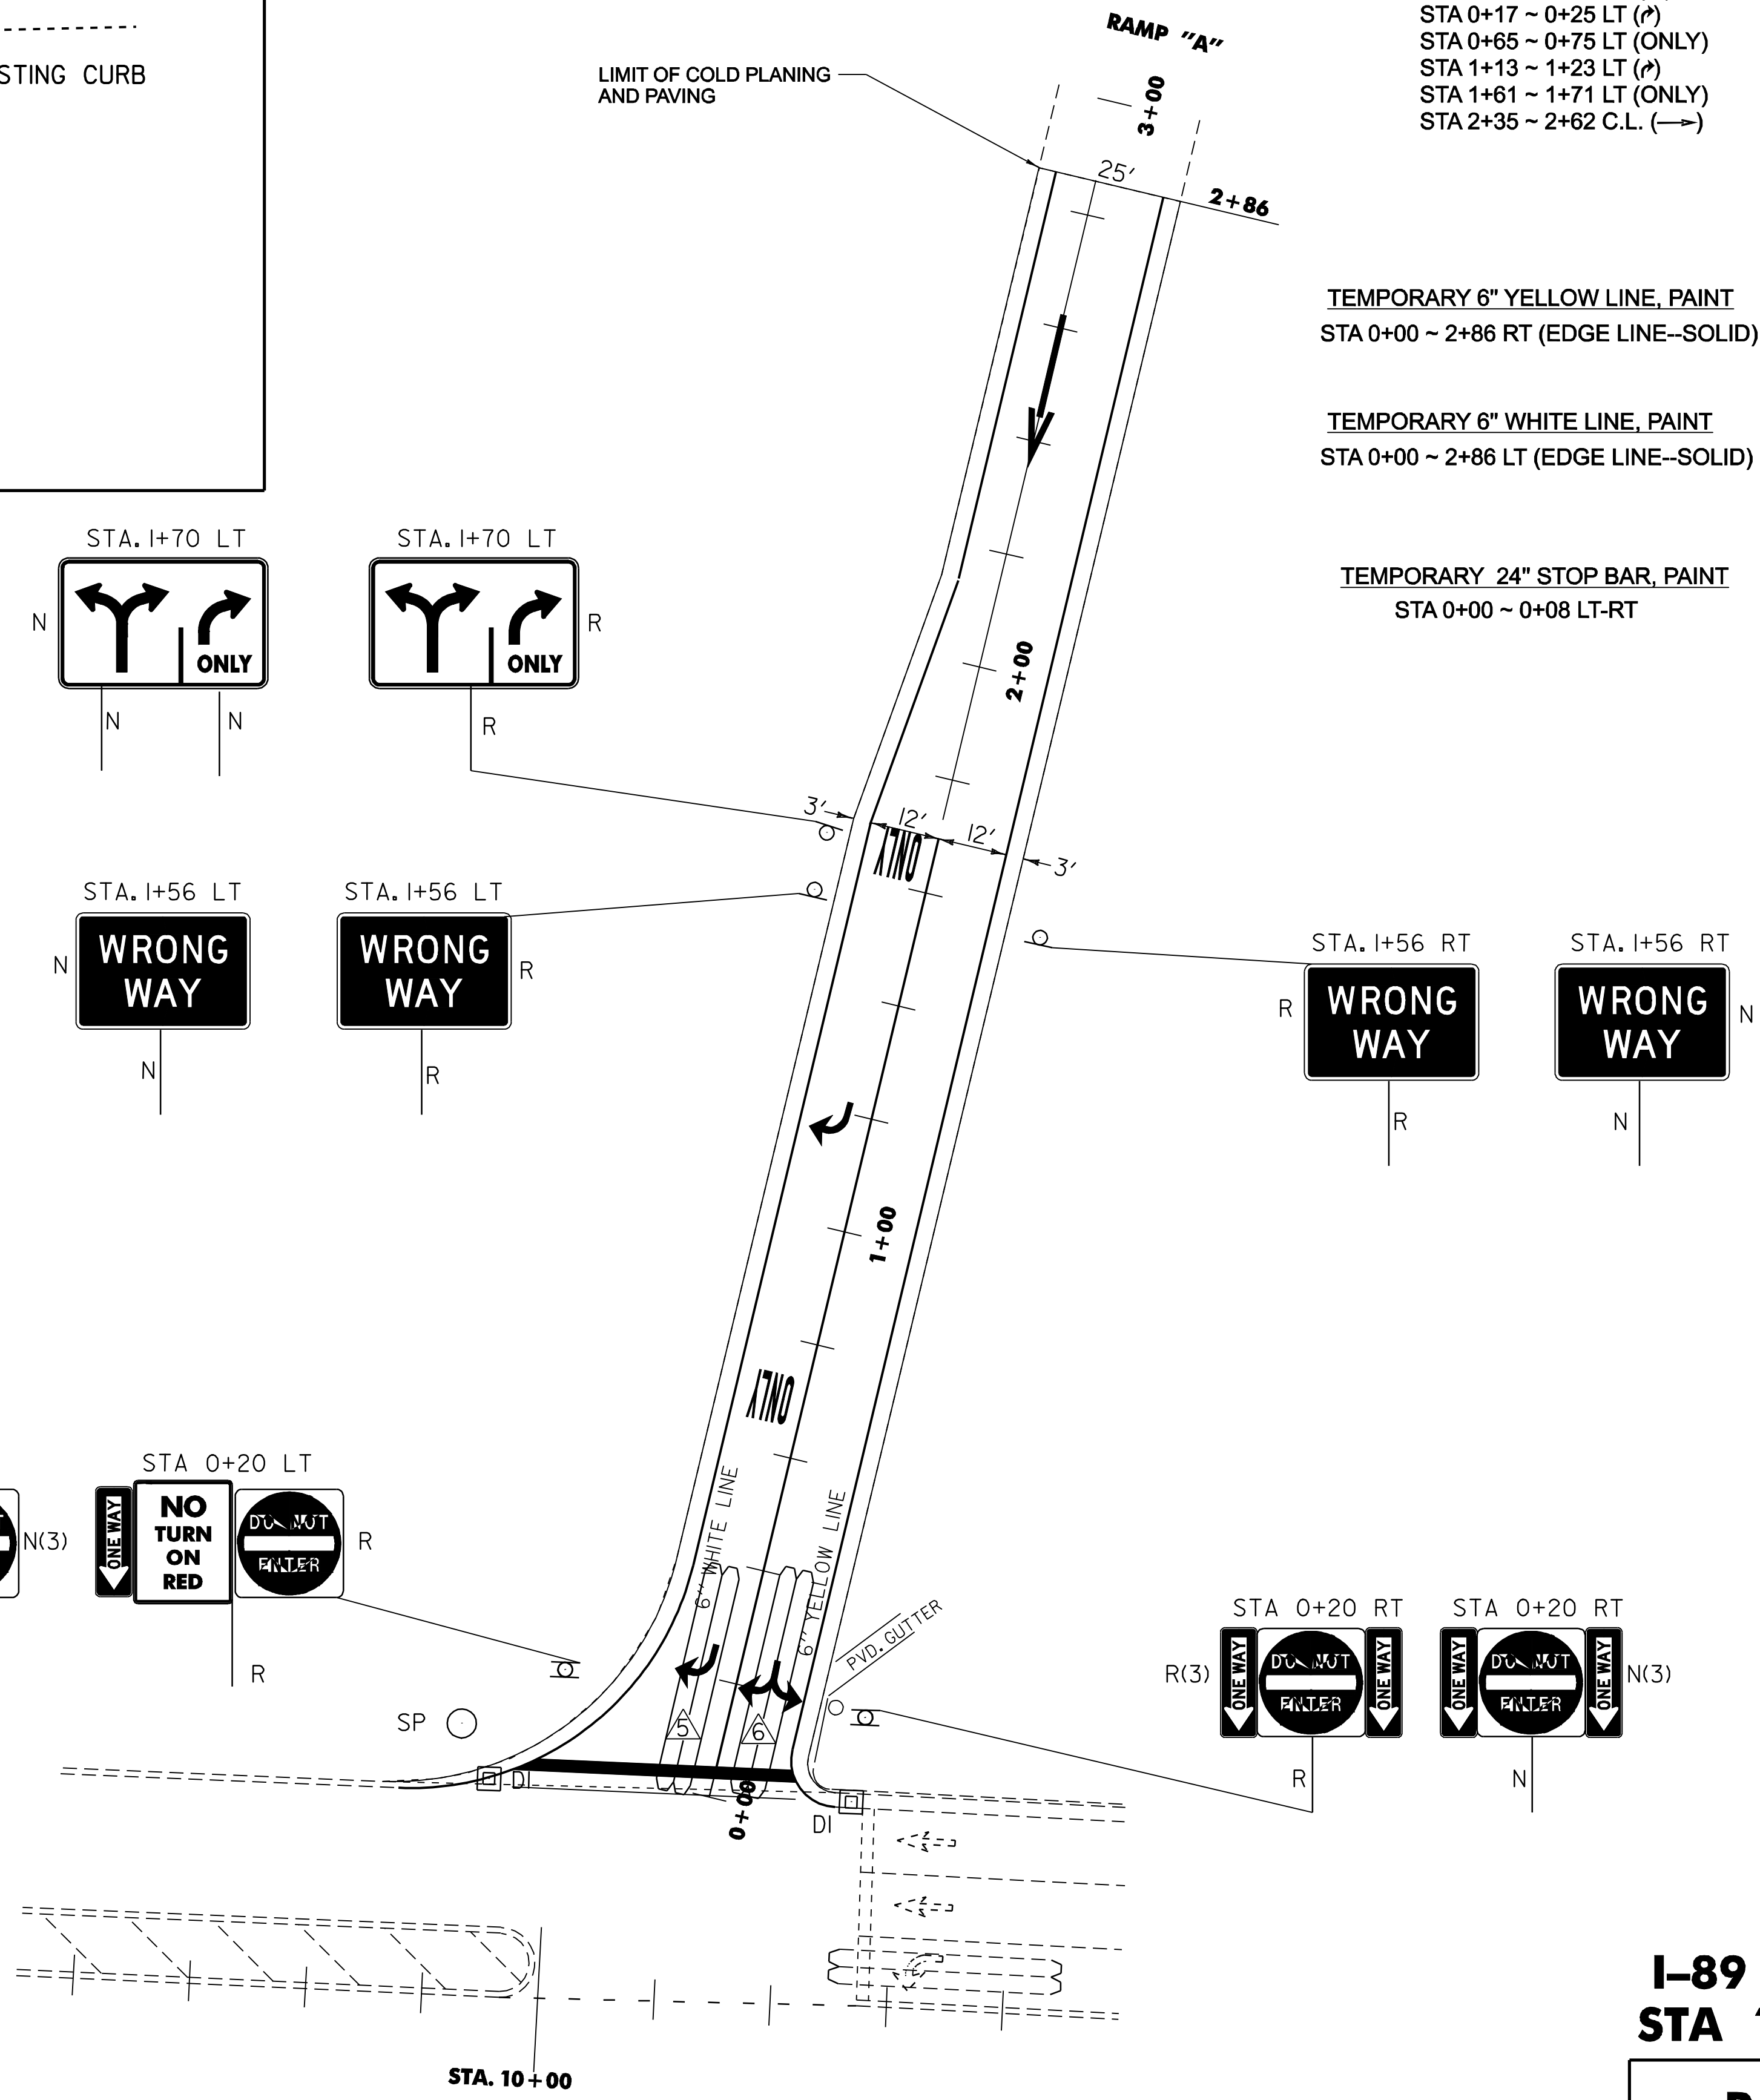

**I-89 RAMP A
STA 10+28 LT**

**RAMP
DETAIL
SHEET 1**

PROJECT NAME:	COLCHESTER	PLOT DATE:	23-APR-2009 15:3
PROJECT NUMBER:	STP 2307(1)s	DRAWN BY:	LSW
FILE NAME:	/pave01d044/p01d044.dgn	CHECKED BY:	LSW
IPARM NAME:	p01d044d01.i	SHEET	16 OF 26