

TEMPORARY LETTER OR SYMBOL, PAINT

- STA 0+54 ~ 0+62 LT-RT (S) (P) (P)
- STA 1+34 ~ 1+42 LT-RT (S) (P) (P)
- STA 2+14 ~ 2+22 LT-RT (S) (P) (P)
- STA 2+97 ~ 3+24 CL (→)

DURABLE LETTER OR SYMBOL, TYPE I TAPE

- STA 0+54 ~ 0+62 LT-RT (S) (P) (P)
- STA 0+94 ~ 1+02 LT-RT (ONLY)(3 EA)
- STA 1+34 ~ 1+42 LT-RT (S) (P) (P)
- STA 1+74 ~ 1+82 LT-RT (ONLY)(3 EA)
- STA 2+14 ~ 2+22 LT-RT (S) (P) (P)
- STA 2+54 ~ 2+62 LT-RT (ONLY)(3 EA)
- STA 2+97 ~ 3+24 CL (→)

TEMPORARY 24" STOP BAR, PAINT

- STA 12+36 ~ 13+05 RT

DURABLE 24" STOP BAR, TYPE I TAPE

- STA 12+36 ~ 13+05 RT

TEMPORARY 6" WHITE LINE, PAINT

- STA 0+03 ~ 2+62 RT (LANE LINE--SOLID)
- STA 0+09 ~ 2+62 LT (LANE LINE--SOLID)
- STA 0+00 ~ 3+75 LT (EDGE LINE--SOLID)

DURABLE 6" WHITE LINE, TYPE I TAPE

- STA 0+03 ~ 2+62 RT (LANE LINE--SOLID)
- STA 0+09 ~ 2+62 LT (LANE LINE--SOLID)
- STA 0+00 ~ 3+75 LT (EDGE LINE--SOLID)

TEMPORARY 6" YELLOW LINE, PAINT

- STA 0+00 ~ 3+75 RT (EDGE LINE--SOLID)


DURABLE 6" YELLOW LINE, TYPE I TAPE

- STA 0+00 ~ 3+75 RT (EDGE LINE--SOLID)

REMOVING SIGNS
AS SHOWN--17 EA.

VEHICLE LOOP DETECTOR

- STA 0+00 ~ 0+40 C.L.
- STA 0+00 ~ 0+40 RT
- STA 0+00 ~ 0+40 LT

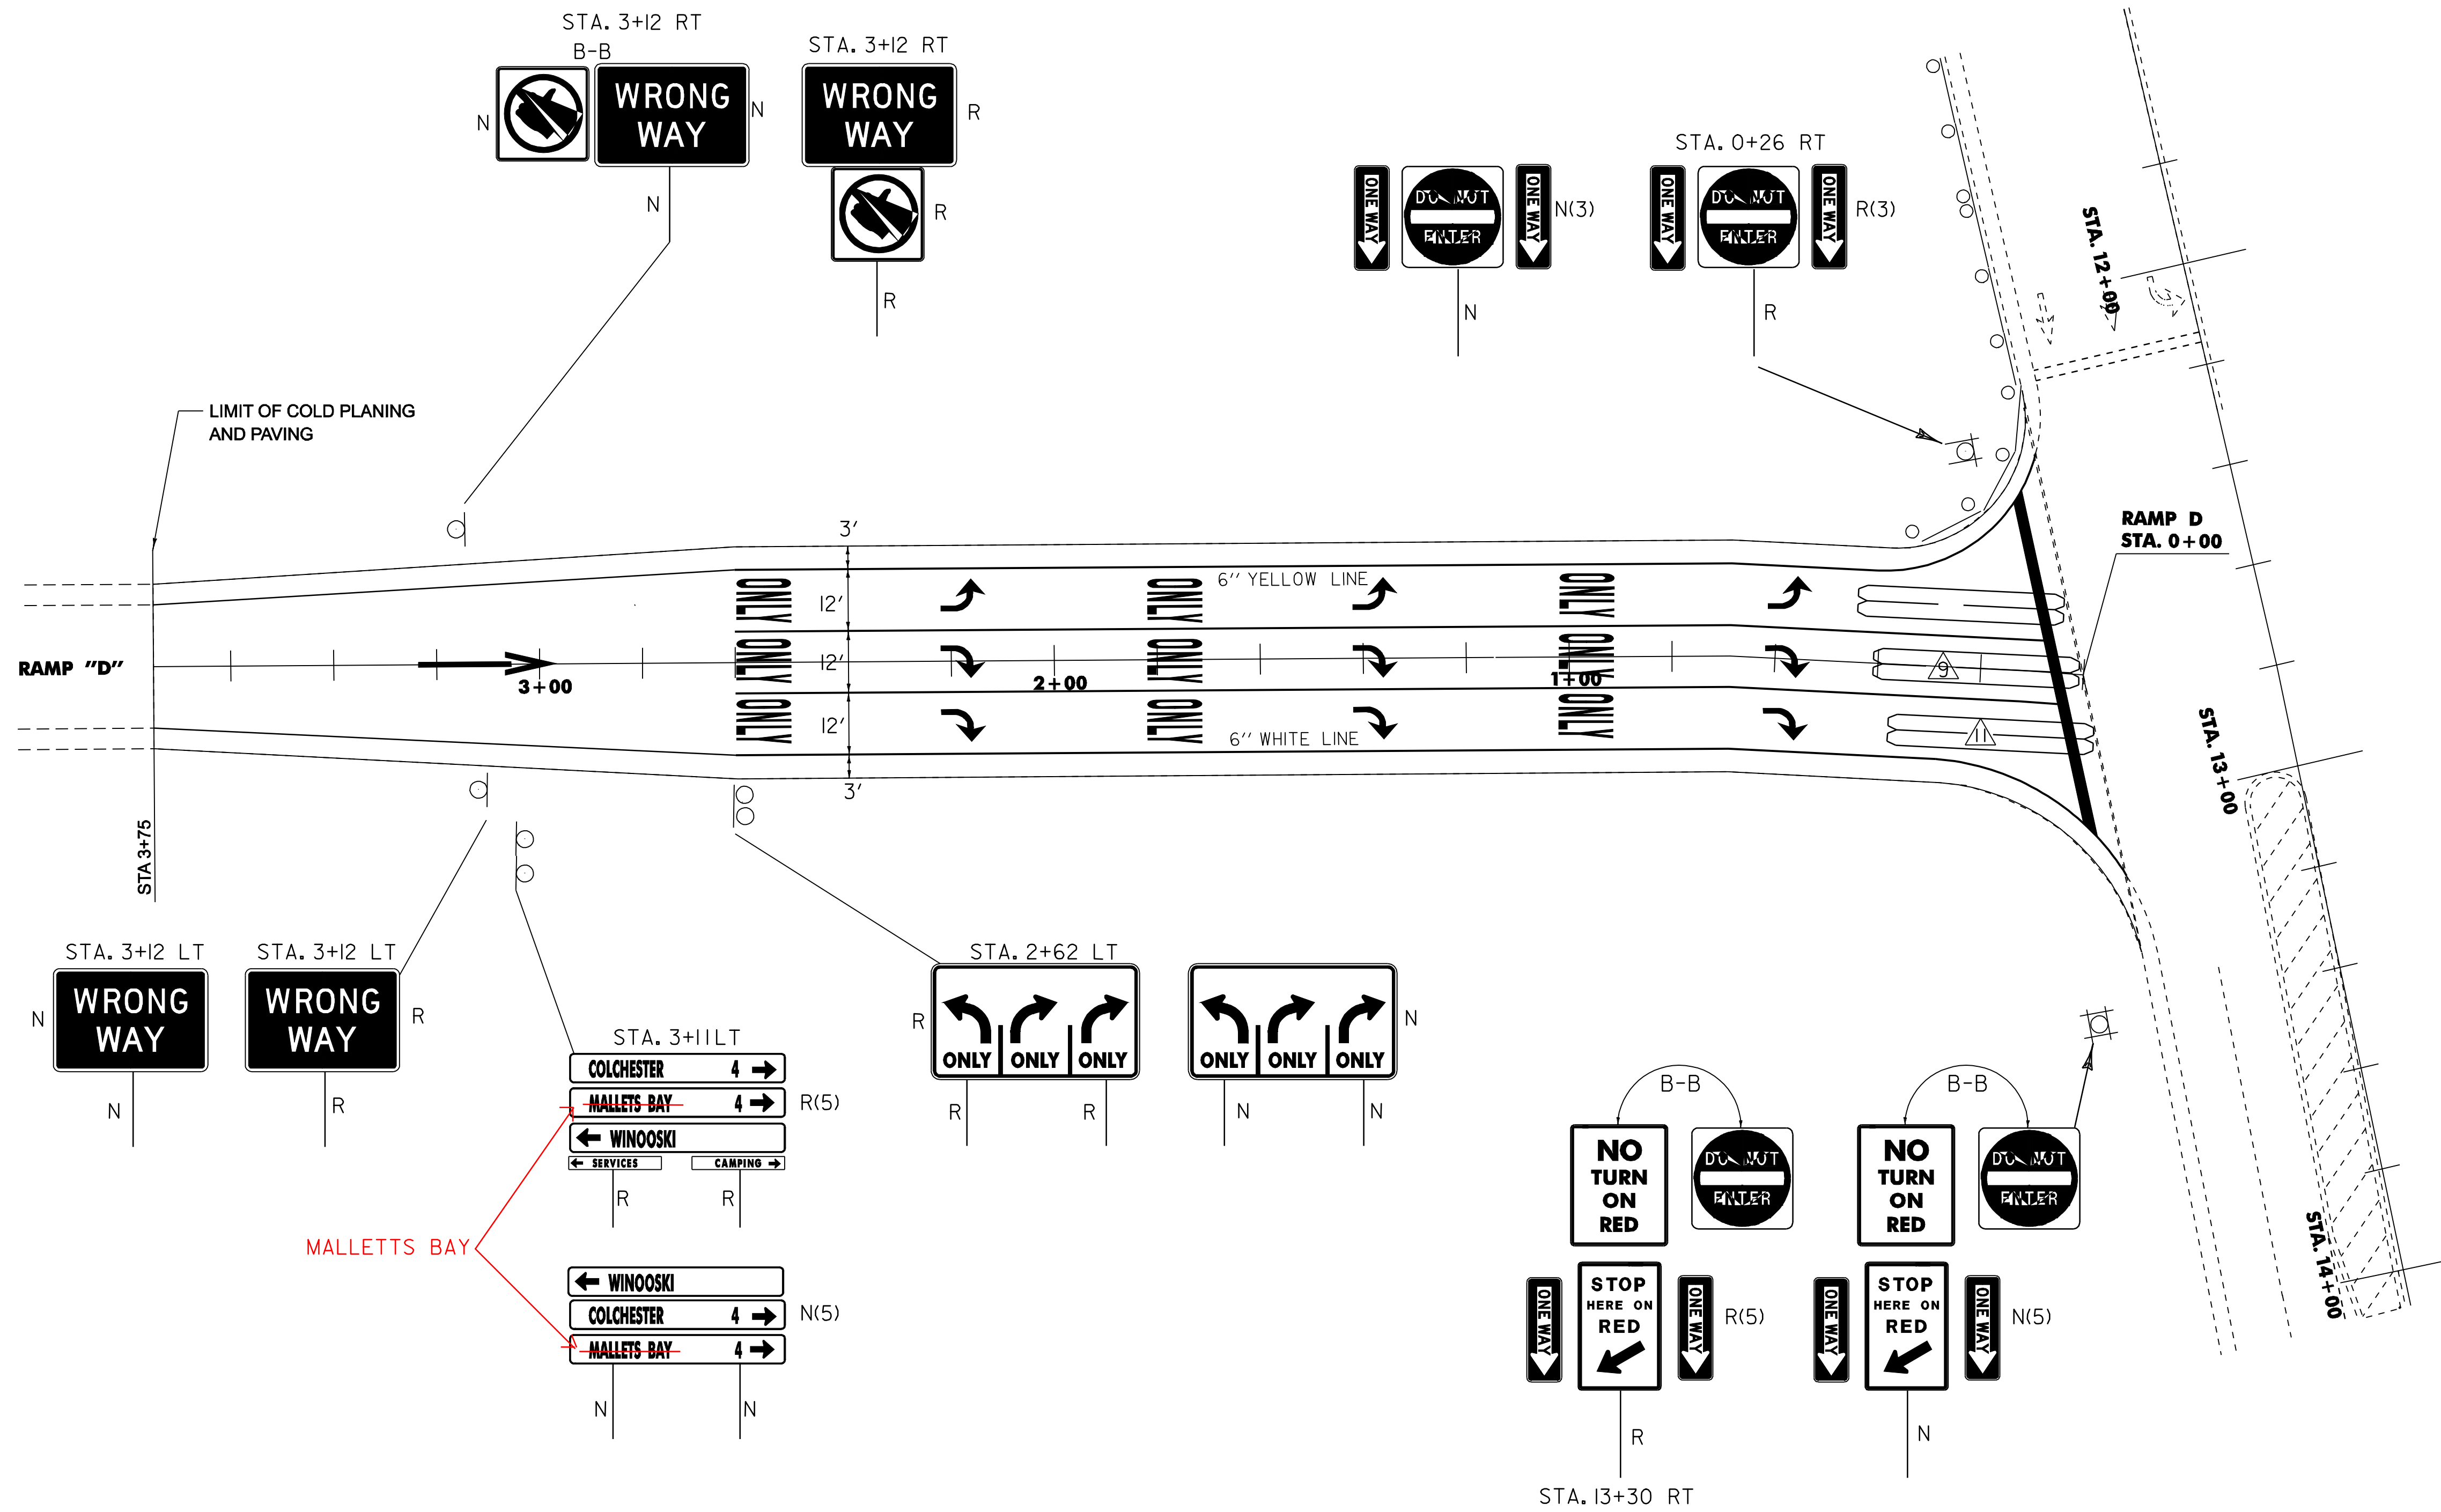

**I-89 RAMP D
STA 12+85 RT**

**RAMP
DETAIL
SHEET 2**

PROJECT NAME: COLCHESTER	PLOT DATE: 23-APR-2009 15:3
PROJECT NUMBER: STP 2307(1)S	DRAWN BY: LSW
FILE NAME: /pave01d044/p01d044.dgn	CHECKED BY: LSW
PROJECT LEADER: MW	SHEET 17 OF 26
IPARM NAME: p01d044d02.i	