

**INDEX OF SHEETS**  
FOR INDEX, SEE SHEET 2

STATE OF VERMONT  
AGENCY OF TRANSPORTATION



**RECORD PLANS**

CONTRACTOR: FW WHITCOMB CONSTRUCTION CORP. - WALPOLE, NH

RESIDENT ENGINEER: DAVID HOSKING

CONSTRUCTION BEGAN: AUGUST 7, 2006


CONSTRUCTION COMPLETE: NOVEMBER 13, 2007

RECORD PLANS BY: D. HOSKING & MIKE BOOTH

I HEREBY CERTIFY THAT ALL THE CONSTRUCTION REQUIRED BY THIS SET OF DRAWINGS HAS BEEN ACCOMPLISHED AS INDICATED HEREIN.

BY: *David Hosking* RESIDENT ENGINEER  
DATE: 01/07/09

NOTE: Any further information concerning final quantities, amounts or other details relative to this project may be found at Central Files in the electronic archives.

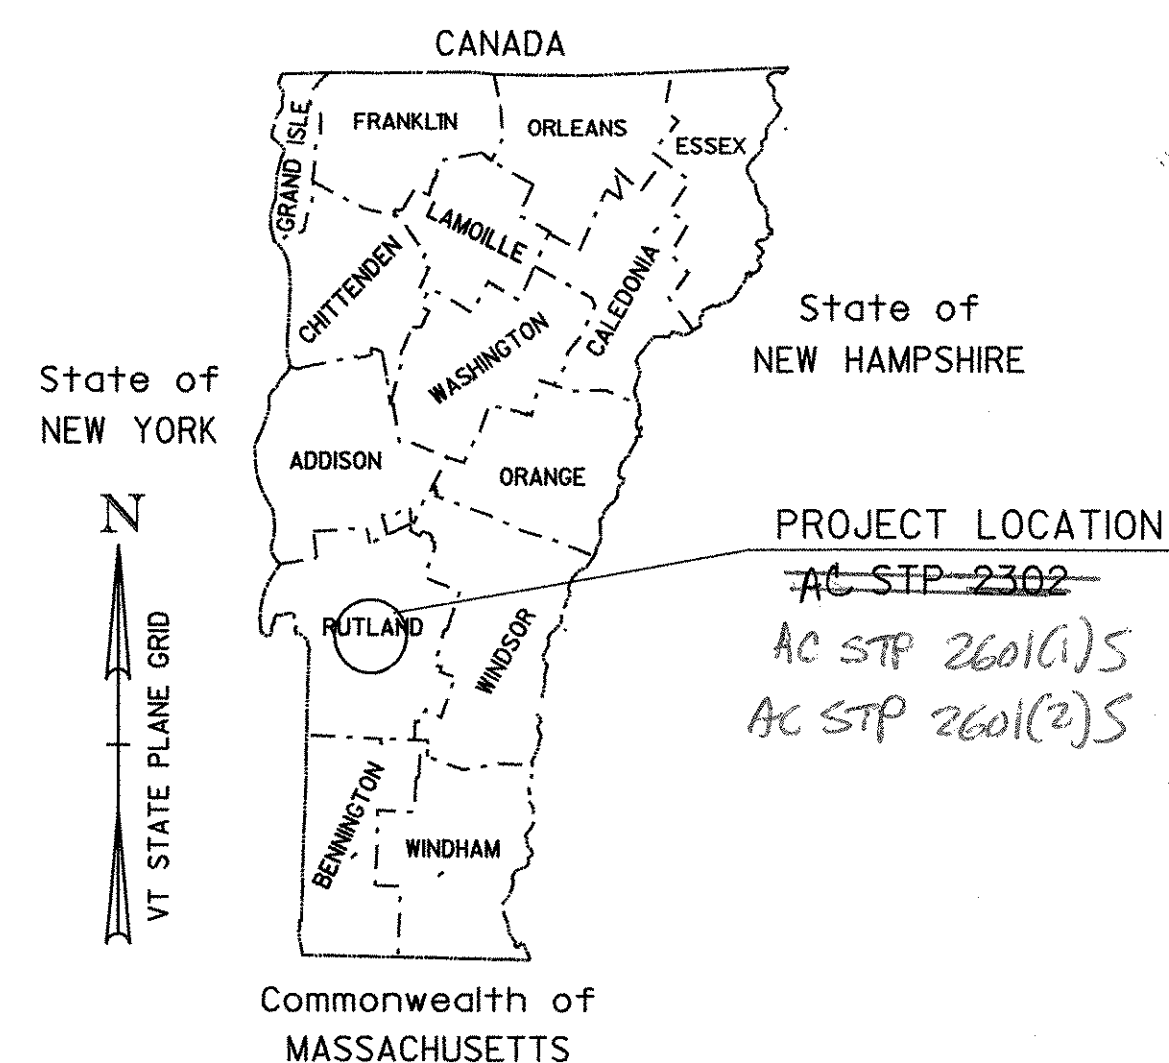

PROPOSED IMPROVEMENT  
TOWN OF WEST RUTLAND  
COUNTY OF RUTLAND  
ROUTES VT 4A & USBR 4

AC  
WEST RUTLAND STP 2601(1)S  
VT. ROUTE 4A (CLASS 1)

BEGINNING IN WEST RUTLAND ON VT ROUTE 4A AT STATION 94+21.00 (MM 1.784) AND EXTENDING EASTERLY ALONG VT ROUTE 4A A DISTANCE OF 4 662.00 FEET (0.883 MILES) TO STATION 140+83.00 (MM 2.667) IN WEST RUTLAND.

PROJECT DATA	
FROM	TO
VT ROUTE 4A STA 94+21.00 (MM 1.784)	STA 140+83.00 (MM 2.667)

LENGTH OF PROJECT = 4 662.00 FEET (0.883 MILES)  
LENGTH OF ROADWAY = 4 662.00 FEET (0.883 MILES)

WORK TO BE PERFORMED UNDER THIS PROJECT INCLUDES COLD PLANING AND RESURFACING OF THE EXISTING HIGHWAY WITH A LEVELING COURSE, WEARING COURSE, NEW PAVEMENT MARKINGS, GUARDRAIL, SIGNS AND INCIDENTAL ITEMS AS SHOWN IN THE PROJECT QUANTITIES.

AC  
WEST RUTLAND STP 2601(2)S  
US BR 4

BEGINNING IN WEST RUTLAND ON US BR 4 FROM STATION 0+00.00 (MM 0.000) AND EXTENDING EASTERLY ALONG US BR 4 A DISTANCE OF 3 147.00 FEET (0.596 MILES) TO STATION 150+50.00 (MM 0.596) IN WEST RUTLAND.

PROJECT DATA	
FROM	TO
US ROUTE BR 4 STA 0+00.00 (MM 0.000)	STA 21+80.00 (MM 0.413)
US ROUTE BR 4 STA 140+83.00 (MM 0.413)	STA 150+50.00 (MM 0.596)
JUG HANDLE STA 0+68.00	STA 10+29.00

LENGTH OF PROJECT = 4 176.00 FEET (0.791 MILES)  
LENGTH OF ROADWAY = 4 176.00 FEET (0.791 MILES)

WORK TO BE PERFORMED UNDER THIS PROJECT INCLUDES COLD PLANING AND RESURFACING OF THE EXISTING HIGHWAY WITH A LEVELING COURSE, WEARING COURSE, NEW PAVEMENT MARKINGS, GUARDRAIL, SIGNS AND INCIDENTAL ITEMS AS SHOWN IN THE PROJECT QUANTITIES.

**TRAFFIC DATA**

VT RTE. 4A	US BR 4
START (1.784) TO MARBLE AVE. (2.33)	START (0.00) TO US 4 RAMPS A/B (0.01)
2005 ADT 3100	2005 ADT 190
2005 DHV 310	2005 DHV 20
2015 ADT 3300	2015 ADT 210
2015 DHV 340	2015 DHV 20
2005 ~ 2015 ESALS 237 000	2005 ~ 2015 ESALS 18 000
MARBLE AVE. TO VT. 133 (2.46)	US 4 RAMPS A/B TO US 4 RAMP C (0.23)
2005 ADT 7200	2005 ADT 5400
2005 DHV 740	2005 DHV 550
2015 ADT 7700	2015 ADT 5800
2015 DHV 790	2015 DHV 590
2005 ~ 2015 ESALS 664 000	2005 ~ 2015 ESALS 608 000
VT 133 TO USBR 4 (2.667)	US 4 RAMP C TO VT 4A (0.43)
2005 ADT 12300	2005 ADT 10300
2005 DHV 1300	2005 DHV 1100
2001 ~ 2015 ESALS 1 600 000	2015 ADT 11000
	2015 DHV 1100
	2005 ~ 2015 ESALS 1 173 000
	JUG HANDLE TO END OF PROJECT
	2005 ADT 15000
	2005 DHV 1600
	2015 ADT 16200
	2015 DHV 1700
	2005 ~ 2015 ESALS 2 381 000
	JUG HANDLE VOLUMES
	2005 ADT 3100
	2005 DHV 310
	2015 ADT 3300
	2015 DHV 330
	2005 ~ 2015 ESALS 621 000


**CONVENTIONAL SYMBOLS**

COUNTY LINE	
TOWN LINE	
LIMITS OF ACCESS	
POINT OF ACCESS	
FENCE LINE	
STONE WALL	
TRAVELED WAY	
GUARD RAIL	
RAILROAD	
SURVEY LINE	
CULVERT	
POWER POLE	
TELEPHONE POLE	
TREES	
CONTROL OF ACCESS	
PROPERTY LINE	
R.O.W. TAKING LINE	
SLOPE RIGHTS	
TOP OF CUT	
TOE OF SLOPE	

UNLESS OTHERWISE INDICATED, THE DRAWINGS AND DETAILS OF THESE PLANS ARE NOT TO SCALE.

SURVEYED BY :  
SURVEYED DATE :

DATUM  
VERTICAL N/A  
HORIZONTAL N/A

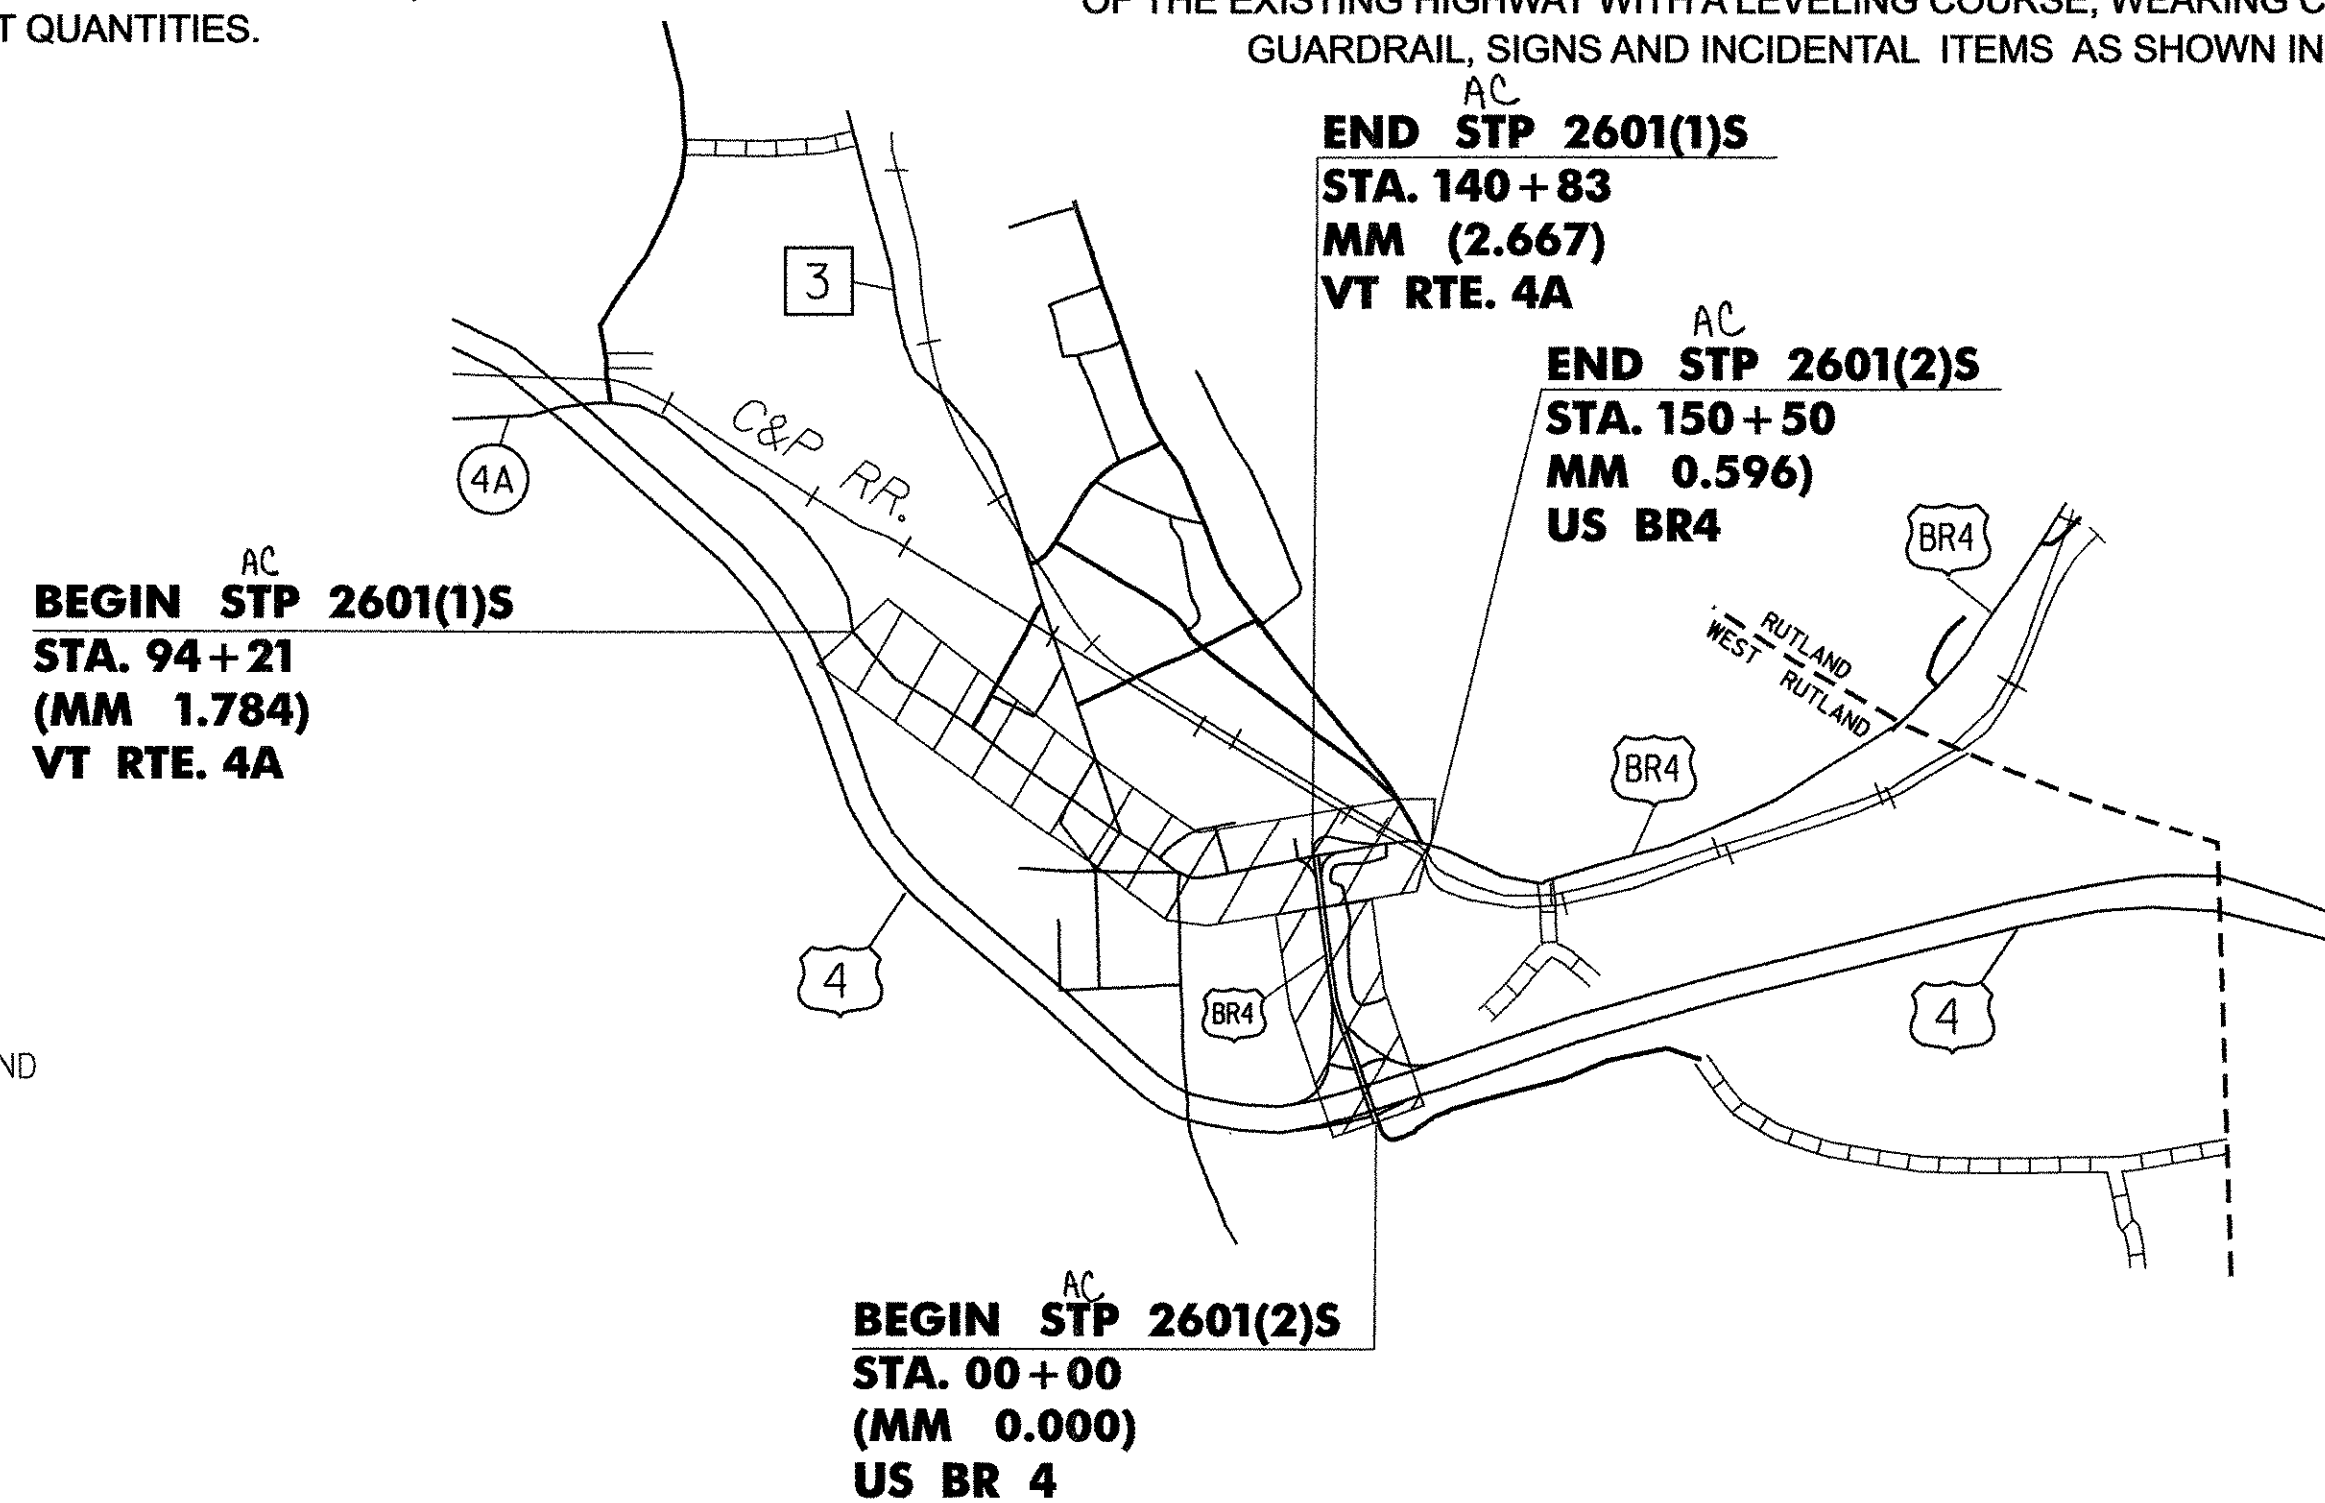

THESE PLANS ARE SUBJECT TO SUCH ENGINEERING CHANGES AS MAY BE REQUIRED BY THE FEDERAL HIGHWAY ADMINISTRATION OR THE DIRECTOR OF PROGRAM DEVELOPMENT.

CONSTRUCTION IS TO BE CARRIED ON IN ACCORDANCE WITH THESE PLANS AND THE STANDARD SPECIFICATIONS FOR CONSTRUCTION DATED 2001. AS APPROVED BY THE FEDERAL HIGHWAY ADMINISTRATION ON JANUARY 4, 2001 FOR USE ON THIS PROJECT, INCLUDING ALL SUBSEQUENT REVISIONS AND SUCH REVISED SPECIFICATIONS AND SPECIAL PROVISIONS AS ARE INCORPORATED IN THESE PLANS.

DIRECTOR OF PROGRAM DEVELOPMENT  
APPROVED: *[Signature]* DATE: 5-7-2006  
PROJECT MANAGER :  
PROJECT NAME : AC WEST RUTLAND  
PROJECT NUMBER : STP 2601(1)S & STP 2601(2)S  
SHEET 1 OF 45 SHEETS