

REHABILITATING DI, CB OR MH, CLI
STA 112+12 LT-DI

DURABLE 4" YELLOW LINE
STA 111+00 ~ 113+68 (DBL. CTR.-SOLID)
STA 113+76 ~ 117+00 (DBL. CTR.-SOLID)

DURABLE X WALK
W/ DIAGONAL LINES (MOD.)
STA 113+72 LT ~ RT
STA 113+75 ~ 114+05 RT

DURABLE 4" WHITE LINE
STA 111+00 ~ 113+68 LT (EDGE-SOLID)
STA 113+76 ~ 117+00 RT (EDGE-SOLID)
STA 111+00 ~ 113+68 RT (EDGE-SOLID)
STA 113+76 ~ 117+00 RT (EDGE-SOLID)

DURABLE LETTER OR SYMBOL
STA 116+25 LT (SCHOOL)

REMOVING SIGNS
AS SHOWN-9 EA.


TEMPORARY 4" YELLOW LINE
STA 111+00 ~ 113+68 (DBL. CTR.-SOLID)
STA 113+76 ~ 117+00 (DBL. CTR.-SOLID)

TEMPORARY X WALK
W/ DIAGONAL LINES
STA 113+72 LT ~ RT

TEMPORARY 4" WHITE LINE
STA 111+00 ~ 113+68 LT (EDGE-SOLID)
STA 113+76 ~ 117+00 RT (EDGE-SOLID)
STA 111+00 ~ 113+68 RT (EDGE-SOLID)
STA 113+76 ~ 117+00 RT (EDGE-SOLID)

CONSTRUCT SIDEWALK RAMP
STA 113+60 ~ 113+68 LT-TYPE 1
STA 113+76 ~ 113+84 LT-TYPE 1
STA 113+60 ~ 113+68 RT-TYPE 1
STA 113+68 ~ 113+76 RT-TYPE 1

DETECTABLE WARNING SURFACE
STA 113+68 ~ 113+76 LT
STA 113+68 ~ 113+76 RT

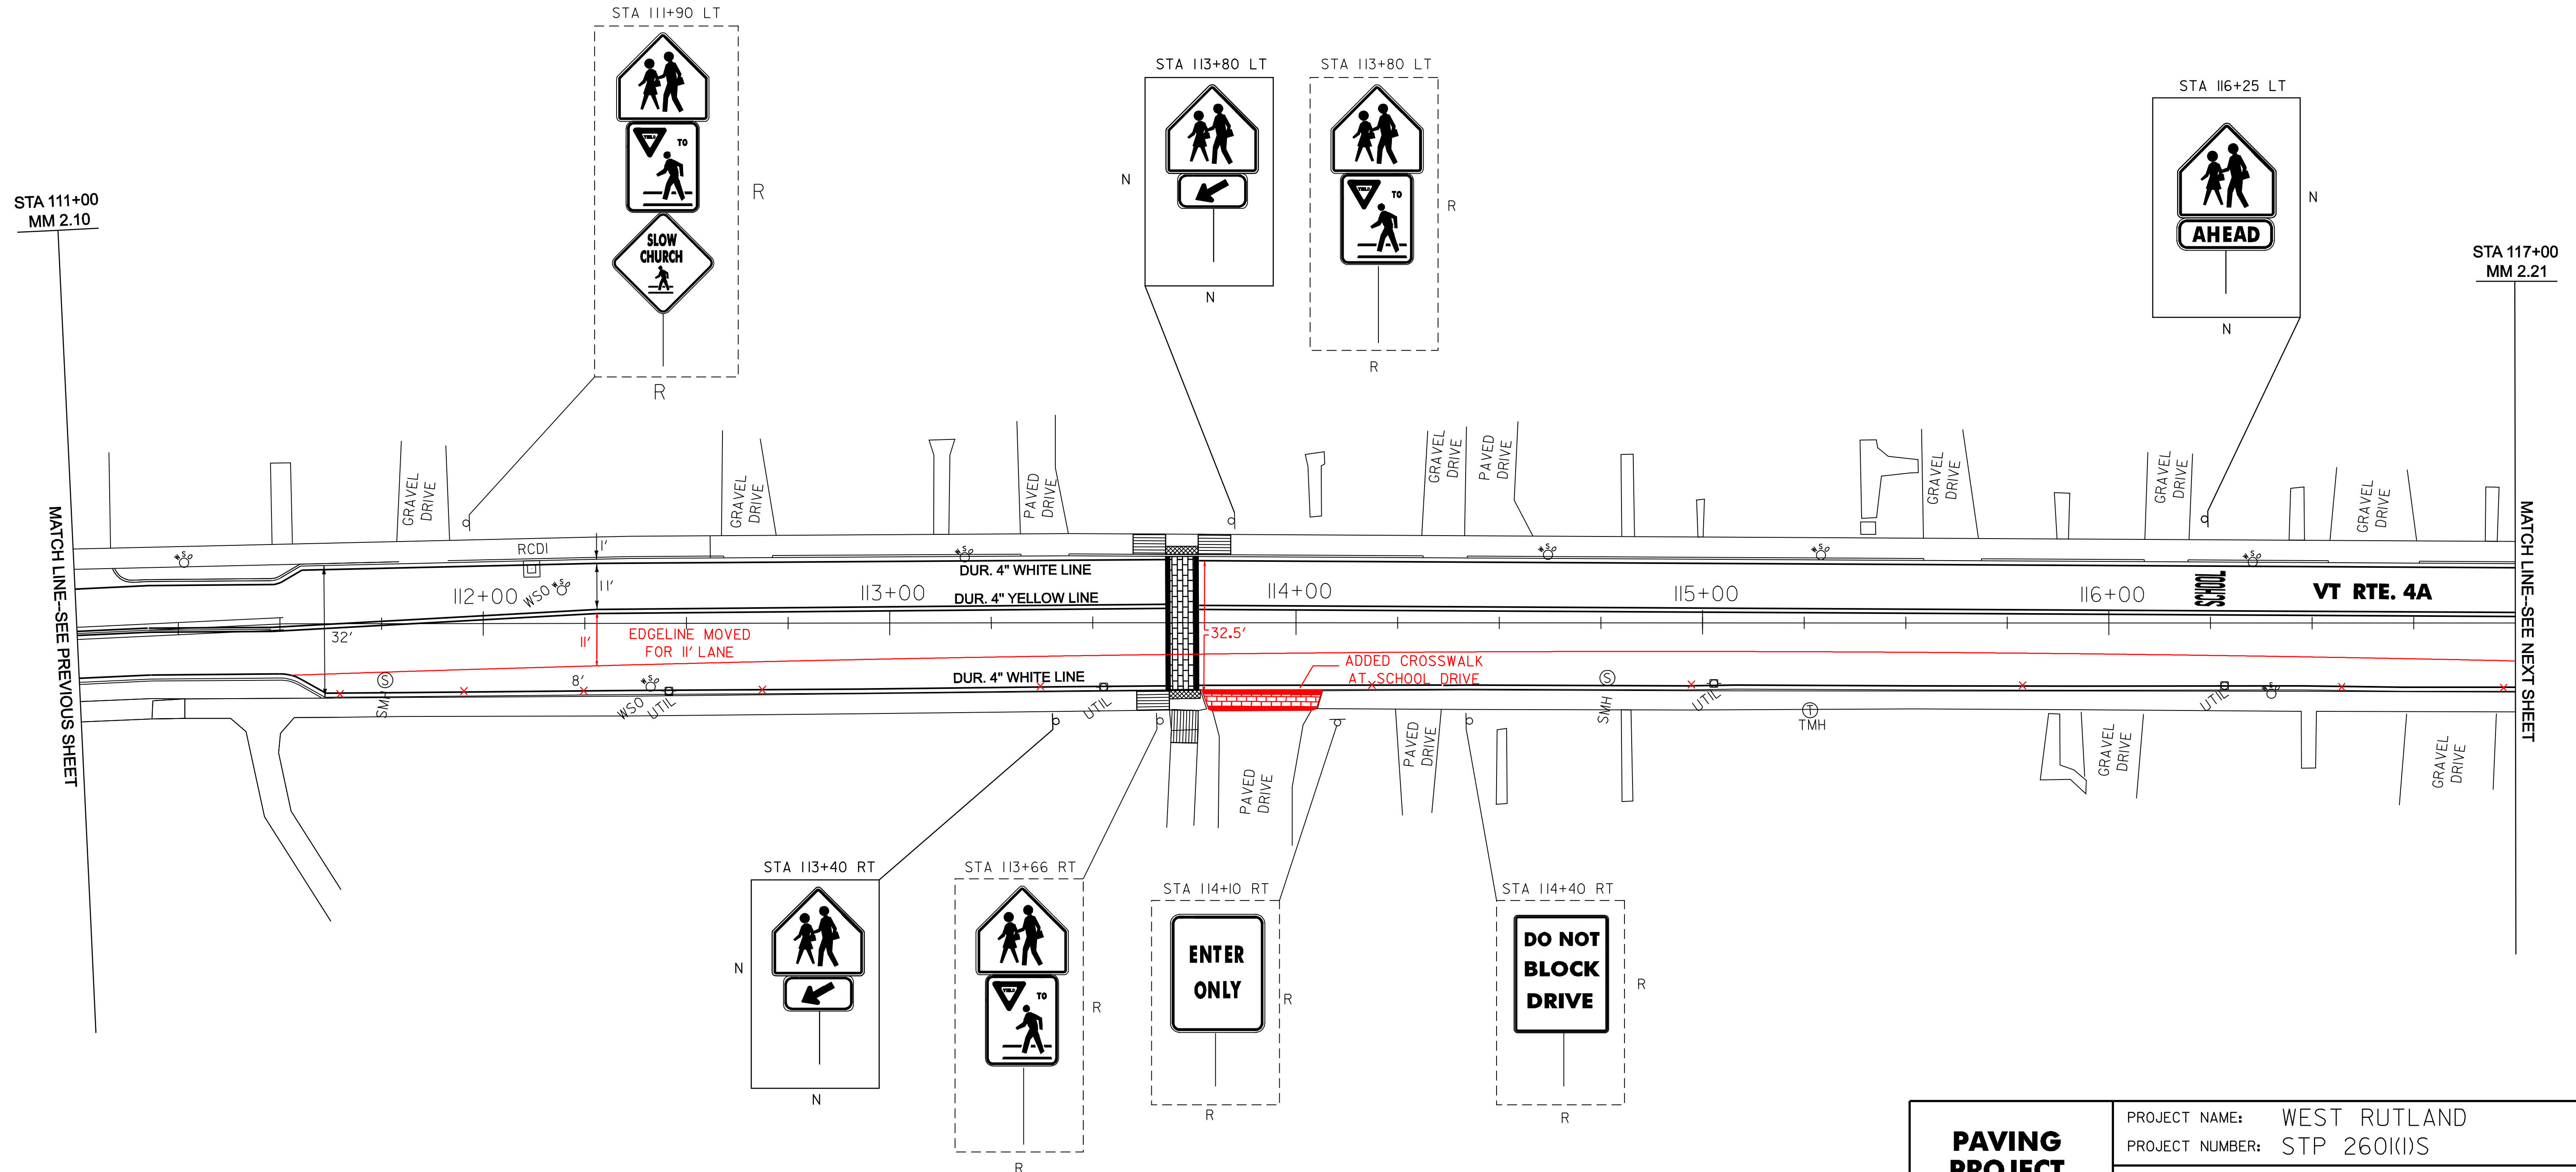

NOT TO SCALE

PAVING PROJECT LAYOUT #4 VT RTE. 4A	PROJECT NAME: WEST RUTLAND	PLOT DATE: 06-FEB-2009 15:2
	PROJECT NUMBER: STP 260(K)S	DRAWN BY: JLR
	FILE NAME: /pave/01d046/pd046.dgn	CHECKED BY: JLR
	DESIGNED BY: JLR	SHEET II OF 45