

DURABLE 4" WHITE LINE
 STA 134+00 ~ 135+87 LT (EDGE--SOLID)
 STA 135+95 ~ 139+62 LT (EDGE--SOLID)
 STA 134+00 ~ 135+67 LT (DASHED)
 STA 135+67 ~ 136+50 LT (LANE--SOLID)
 STA 136+50 ~ 140+00 LT (DASHED)
 STA 134+00 ~ 135+18 RT (EDGE--SOLID)
 STA 134+00 ~ 134+47 RT (DASHED)
 STA 134+47 ~ 135+18 RT (LANE--SOLID)
 STA 135+95 ~ 140+00 RT (DASHED)
 STA 135+95 ~ 140+00 RT (EDGE--SOLID)
 STA 137+12 ~ 138+46 RT (DOTTED LINE)
 STA 138+46 ~ 140+00 RT (LANE--SOLID)
 STA 139+70 ~ 139+76 LT (EDGE--SOLID)(GILMORE ST.)
 STA 139+93 LT (EDGE--SOLID)(GILMORE ST.)
 STA 139+98 ~ 140+00 LT (EDGE--SOLID)

TEMPORARY 4" WHITE LINE
 STA 134+00 ~ 135+87 LT (EDGE--SOLID)
 STA 135+95 ~ 139+62 LT (EDGE--SOLID)
 STA 134+00 ~ 135+67 LT (DASHED)
 STA 135+67 ~ 136+50 LT (LANE--SOLID)
 STA 136+50 ~ 140+00 LT (DASHED)
 STA 134+00 ~ 135+18 RT (EDGE--SOLID)
 STA 134+00 ~ 134+47 RT (DASHED)
 STA 134+47 ~ 135+18 RT (LANE--SOLID)
 STA 135+95 ~ 140+00 RT (DASHED)
 STA 135+95 ~ 140+00 RT (EDGE--SOLID)
 STA 137+12 ~ 138+46 RT (DOTTED LINE)
 STA 138+46 ~ 140+00 RT (LANE--SOLID)
 STA 139+70 ~ 139+76 LT (EDGE--SOLID)(GILMORE ST.)
 STA 139+93 LT (EDGE--SOLID)(GILMORE ST.)
 STA 139+98 ~ 140+00 LT (EDGE--SOLID)

DURABLE 4" YELLOW LINE
 STA 134+00 ~ 135+05 C.L. (PAINTED TAPER)
 STA 135+05 ~ 135+19 C.L. (EDGE--ISLAND--SOLID)
 STA 135+64 ~ 136+14 C.L. (EDGE--ISLAND--SOLID)
 STA 136+14 ~ 137+14 C.L. (PAINTED TAPER)
 STA 137+14 ~ 139+56 C.L. (DBL. CTR.--SOLID)
 STA 139+83 LT (DBL. CTR.--SOLID)(GILMORE ST.)

TEMPORARY 4" YELLOW LINE
 STA 134+00 ~ 135+05 C.L. (PAINTED TAPER)
 STA 135+05 ~ 135+19 C.L. (EDGE--ISLAND--SOLID)
 STA 135+64 ~ 136+14 C.L. (EDGE--ISLAND--SOLID)
 STA 136+14 ~ 137+14 C.L. (PAINTED TAPER)
 STA 137+14 ~ 139+56 C.L. (DBL. CTR.--SOLID)
 STA 139+83 LT (DBL. CTR.--SOLID)(GILMORE ST.)

DURABLE XWALK W/ DIAGONAL LINES (MOD.)
 STA 135+18 ~ 135+82 RT (MALL) 134+60 ~ 135+82 RT
 STA 135+92 LT ~ RT (VT. 4A)
 STA 139+70 ~ 139+93 LT (GILMORE ST.)


TEMPORARY XWALK W/ DIAGONAL LINES
 STA 135+18 ~ 135+82 RT (MALL)
 STA 135+92 LT ~ RT (VT. 4A)
 STA 139+70 ~ 139+93 LT (GILMORE ST.)

DURABLE LETTER OR SYMBOL
 STA 134+47 RT (ARROW--4)
 STA 135+06 RT (ARROW--4)
 STA 135+66 LT (ARROW--4)
 STA 136+36 LT (ARROW--4)
 STA 138+46 RT (ARROW--1)
 STA 139+17 RT (ONLY)
 STA 139+79 LT (STOP)(GILMORE ST.)
 STA 139+85 RT (ARROW--1)

TEMPORARY LETTER OR SYMBOL
 STA 134+47 RT (ARROW--4)
 STA 135+06 RT (ARROW--4)
 STA 135+66 LT (ARROW--4)
 STA 136+36 LT (ARROW--4)
 STA 138+46 RT (ARROW--1)
 STA 139+79 LT (STOP)(GILMORE ST.)
 STA 139+85 RT (ARROW--1)

REMOVING SIGNS AS SHOWN--10 EA.

DURABLE 24" STOP BAR
 STA 139+72 ~ 139+83 LT (GILMORE ST.)
 STA 135+50 ~ 135+75 RT (MALL)
TEMPORARY 24" STOP BAR
 STA 139+72 ~ 139+83 LT (GILMORE ST.)

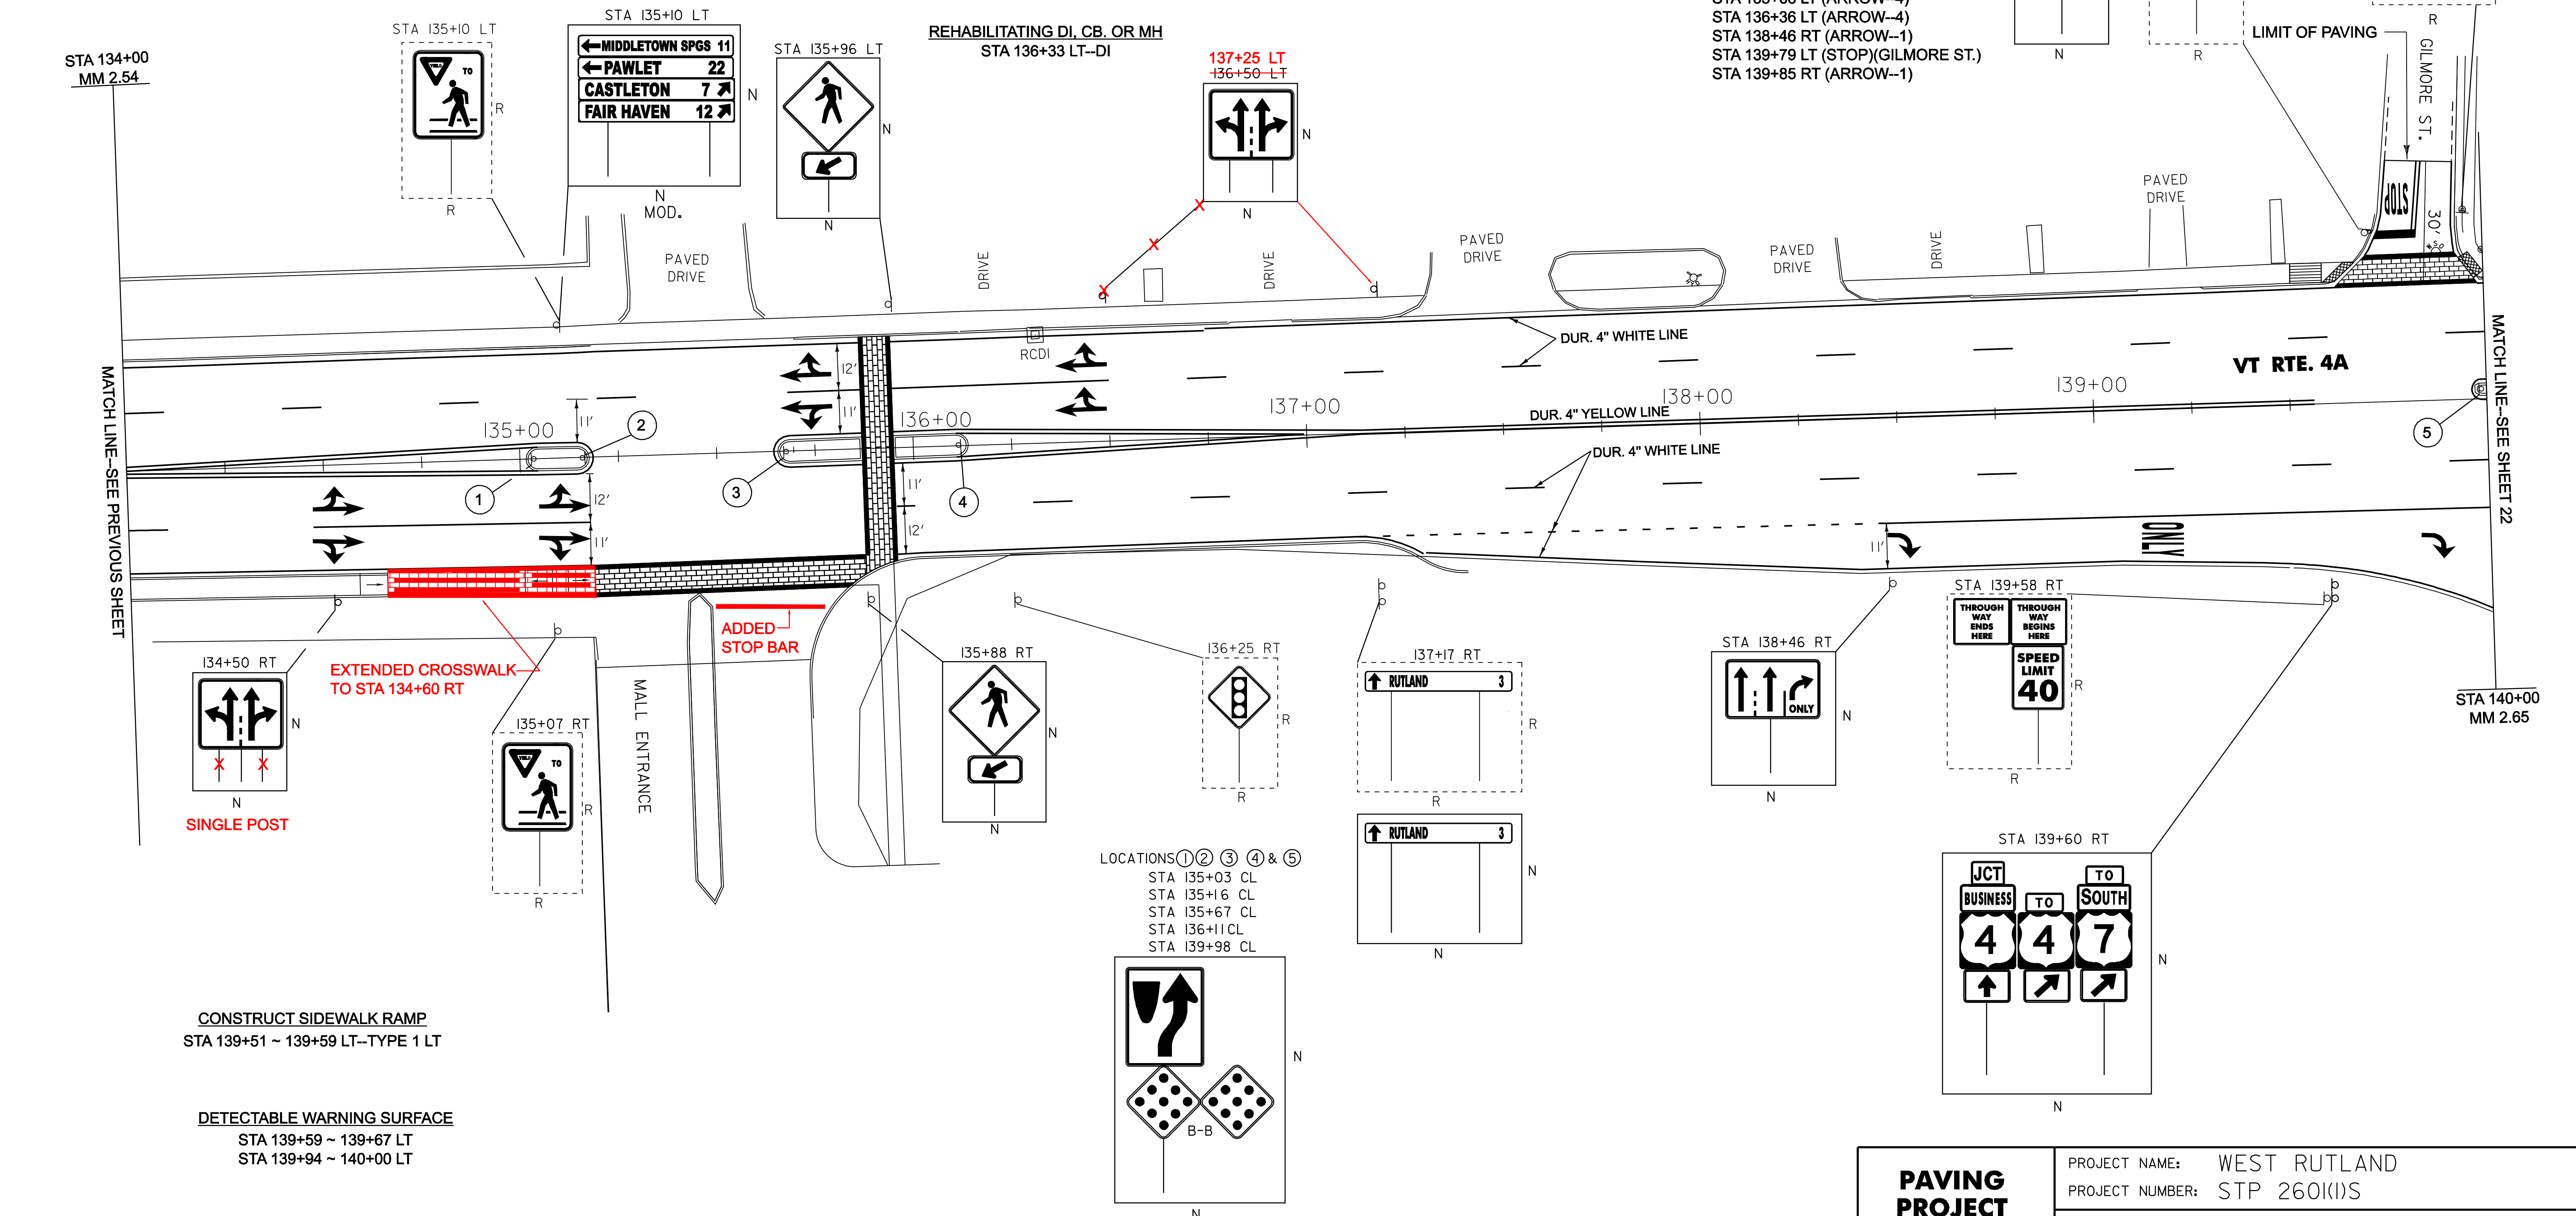

CONSTRUCT SIDEWALK RAMP
 STA 139+51 ~ 139+59 LT--TYPE 1 LT

DETECTABLE WARNING SURFACE
 STA 139+59 ~ 139+67 LT
 STA 139+94 ~ 140+00 LT

LOCATIONS ① ② ③ ④ & ⑤
 STA 135+03 CL
 STA 135+16 CL
 STA 135+67 CL
 STA 136+11 CL
 STA 139+98 CL

PAVING PROJECT LAYOUT #8 VT RTE. 4A	PROJECT NAME: WEST RUTLAND	PLOT DATE: 06-FEB-2009 15:2
	PROJECT NUMBER: STP 2601(I)S	DRAWN BY: JLR
	FILE NAME: /pave/01d046/pd046.dgn	CHECKED BY: JLR
	DESIGNED BY: JLR	SHEET 17 OF 45

NOT TO SCALE