

DURABLE 6" YELLOW LINE  
 STA 10+00 ~ 16+00 LT (EDGE--SOLID--ISLAND)

DURABLE 6" WHITE LINE  
 STA 10+00 ~ 16+00 RT (EDGE--SOLID)  
 STA 10+00 ~ 16+00 LT (EDGE--SOLID)  
 STA 10+00 ~ 16+00 LT (SINGLE--DASHED)  
 STA 11+35 ~ 16+00 LT (SINGLE--DASHED)

DURABLE 12" WHITE LINE  
 STA 10+00 ~ 11+35 LT (GORE--SOLID)

TEMPORARY 6" YELLOW LINE  
 STA 10+00 ~ 16+00 LT (EDGE--SOLID--ISLAND)

TEMPORARY 6" WHITE LINE  
 STA 10+00 ~ 16+00 RT (EDGE--SOLID)  
 STA 10+00 ~ 16+00 LT (EDGE--SOLID)  
 STA 10+00 ~ 16+00 LT (SINGLE--DASHED)  
 STA 11+35 ~ 16+00 LT (SINGLE--DASHED)



TEMPORARY 12" WHITE LINE  
 STA 10+00 ~ 11+35 LT (GORE--SOLID)

STA 10+00  
 MM 0.19

MATCH LINE--SEE PREVIOUS SHEET

STA 16+00  
 MM 0.30

MATCH LINE--SEE NEXT SHEET

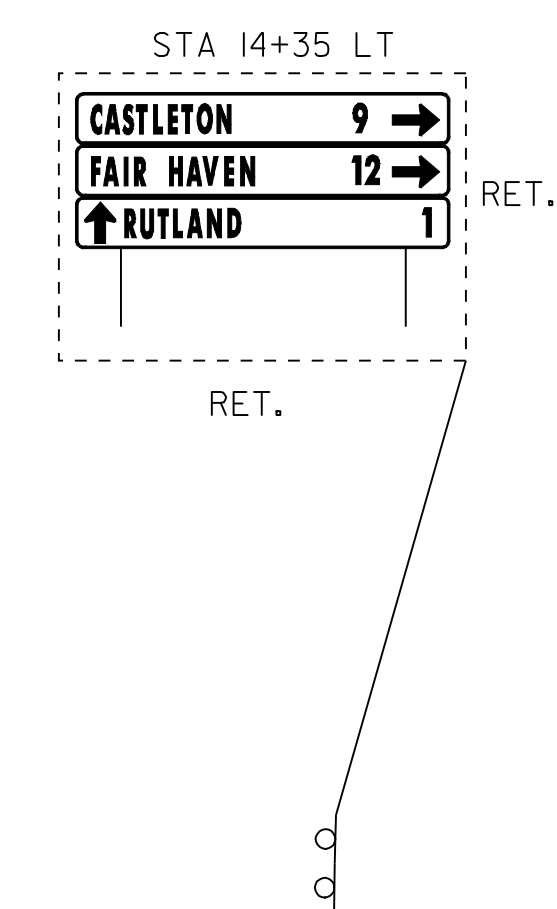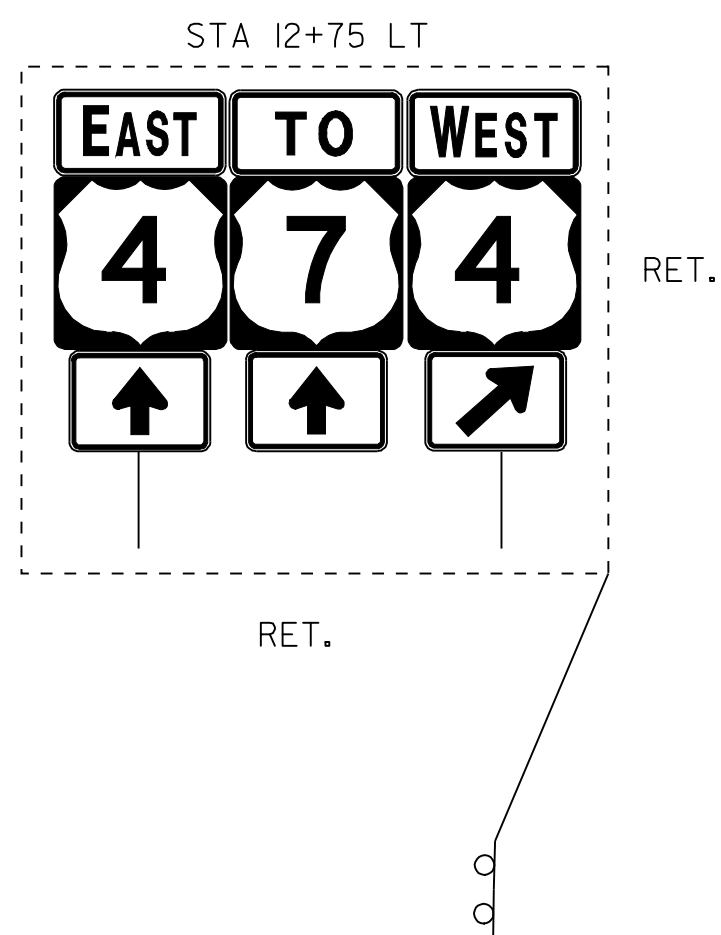

DUR. 12" WHITE LINE

8'  
 14'  
 12'

DUR. 6" WHITE LINE **US BR4**

DUR. 6" YELLOW LINE

DUR. 6" YELLOW LINE

DUR. 6" WHITE LINE



11+00

12+00

13+00

14+00

15+00

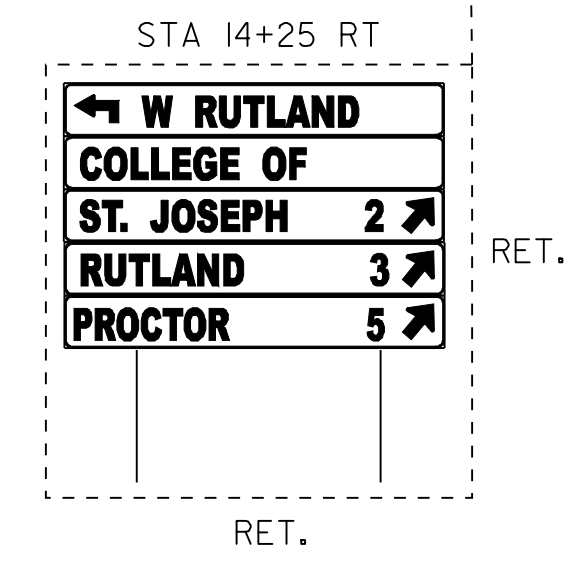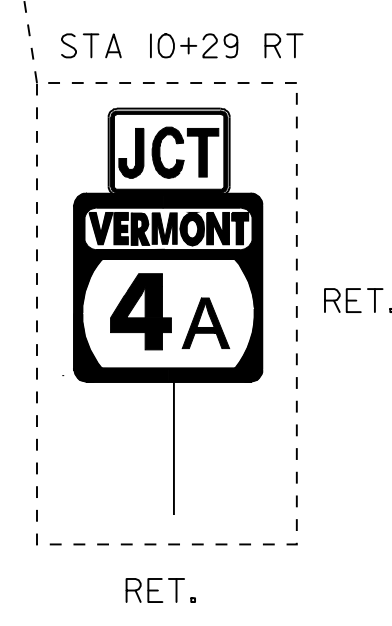

**PAVING  
 PROJECT  
 LAYOUT #11  
 BR 4**

NOT TO SCALE

PROJECT NAME: WEST RUTLAND	PLOT DATE: 06-FEB-2009 15:2
PROJECT NUMBER: 2601(2)S	DRAWN BY: JLR
FILE NAME: /pave/01d046/pd046.dgn	CHECKED BY: JLR
PROJECT LEADER: WOOLAVER	SHEET 20 OF 45
DESIGNED BY: JLR	
pd046III.I	