

**TEMPORARY & DURABLE 4" WHITE LINE**  
 STA 140+00 ~ 140+83 LT (EDGE--SOLID)  
 STA 141+17 ~ 146+00 LT (EDGE--SOLID)  
 STA 140+00 ~ 140+83 LT (DASHED)  
 STA 141+32 ~ 146+00 LT (DASHED)  
 STA 140+27 ~ 140+83 RT (EDGE--SOLID)  
 STA 141+43 ~ 142+82 RT (EDGE--SOLID)  
 STA 143+66 ~ 146+00 RT (EDGE--SOLID)  
 STA 140+00 RT ~ 21+12 LT (EDGE--SOLID)(RAMP)  
 STA 140+27 RT ~ 21+25 LT (EDGE--SOLID)(RAMP)  
 STA 140+00 ~ 140+03 RT (EDGE--SOLID)  
 STA 141+30 ~ 146+00 RT (DASHED)  
 STA 21+00 RT ~ 143+66 RT (EDGE--SOLID)(RAMP)  
 JUG STA 0+78 ~ 2+10 RT (LANE LINE--SOLID)(17' RT)  
 JUG STA 2+10 ~ 5+12 RT (DASHED)  
 JUG STA 0+78 ~ 7+48 RT (EDGE--SOLID)  
 JUG STA 0+78 ~ 7+45 LT (EDGE--SOLID)  
 JUG STA 7+53 ~ 7+72 LT (EDGE--SOLID)  
 JUG STA 7+56 ~ 7+72 RT (EDGE--SOLID)

**TEMPORARY & DURABLE 12" WHITE LINE**  
 STA 121+17 ~ 21+27 LT (GORE)

**REHABILITATING DI. CB. OR MH**  
 STA 141+17 LT-DI

**TEMPORARY & DURABLE 8" WHITE LINE**  
 STA 140+03 ~ 140+27 RT (GORE)  
 STA 142+82 ~ 143+20 RT (GORE)

**DURABLE XWALK W/ DIAGONAL LINES (MOD.)**  
 STA 140+83 ~ 141+17 LT  
 JUG STA 7+49 RT

**TEMPORARY & DURABLE LETTER OR SYMBOL**  
 STA 21+18 ~ 21+28 LT (▼)(5 EA.)  
 STA 143+08 ~ 143+17 RT (▼)(5 EA.)  
 STA 0+88 RT (ARROW-3)  
 STA 2+00 RT (ARROW-3)  
 STA 5+92 RT (AHEAD)  
 STA 6+33 RT (SIGNAL)  
 STA 21+43 LT (LT ARROW)  
 STA 4+75 RT (ARROW-3)

**TEMPORARY & DURABLE 24" STOP BAR**  
 STA 21+76 LT  
 STA 140+83 RT  
 STA 141+32 LT  
 STA 0+78 LT-RT

**TEMPORARY & DURABLE RAILROAD CROSSING SYMBOL**  
 STA 144+00 RT (3 EA.)

**CONSTRUCT SIDEWALK RAMP**  
 STA 140+02 ~ 140+10 LT--TYPE 1  
 STA 140+70 ~ 140+78 LT--TYPE 1  
 STA 141+22 ~ 140+30 LT--TYPE 1  
 STA 145+74 ~ 145+80 LT--TYPE 4  
 JUG STA 7+51 ~ 7+59 LT-RT--TYPE 6

**DETECTABLE WARNING SURFACE**  
 STA 140+81 ~ 140+83 LT  
 STA 141+17 ~ 141+90 LT  
 STA 145+74 ~ 145+80 LT  
 JUG STA 7+46 ~ 7+51 RT

**VT. RTE. 4A  
 STA 140+83  
 (MM 2.667)  
 END PROJECT  
 STP 2601(1)S**

**DURABLE 4" YELLOW LINE**  
 STA 140+00 ~ 140+83 LT & RT (EDGE--SOLID--ISLAND)  
 STA 141+26 ~ 145+12 LT & RT (EDGE--SOLID--ISLAND)  
 STA 145+12 ~ 146+00 LT & RT (IS. APPR. MKGS.)  
 STA 21+00 RT ~ 142+82 RT (EDGE--SOLID)(RAMP)  
 JUG STA 0+78 7+72 RT (EDGE--SOLID)(37' RT)

**TEMPORARY 4" YELLOW LINE**  
 STA 140+00 ~ 140+83 LT & RT (EDGE--SOLID--ISLAND)  
 STA 141+26 ~ 145+12 LT & RT (EDGE--SOLID--ISLAND)  
 STA 145+12 ~ 146+00 LT & RT (IS. APPR. MKGS.)  
 STA 21+00 RT ~ 142+82 RT (EDGE--SOLID)(RAMP)  
 JUG STA 0+78 7+72 RT (EDGE--SOLID)(37' RT)

**PAINTED CURB**  
 STA 140+00 ~ 140+23 C.L. (MEDIAN IS.)  
 STA 140+27 ~ 140+82 RT (CORNER IS.)  
 STA 140+53 ~ 140+83 C.L. (MEDIAN IS.)  
 STA 141+27 ~ 141+57 C.L. (MEDIAN IS.)  
 STA 141+40 ~ 141+70 RT (CORNER IS.)  
 STA 142+52 ~ 142+82 RT (CORNER IS.)  
 STA 144+82 ~ 145+12 C.L. (MEDIAN IS.)  
 STA 21+24 ~ 21+82 LT (CORNER IS.)  
 STA 21+24 LT ~ 140+27 RT (CORNER IS.)  
 STA 21+49 ~ 21+79 RT (CORNER IS.)  
 STA 21+49 ~ 21+79 C.L. (MEDIAN IS.)

**TEMPORARY & DURABLE 6" WHITE LINE**  
 STA 21+17 ~ 21+12 LT (EDGE--SOLID)(RAMP)  
 STA 21+00 LT ~ 141+34 RT (EDGE--SOLID)  
 STA 21+27 LT ~ 140+84 RT (EDGE--SOLID)  
 STA 21+00 ~ 21+80 LT (DASHED)

**TEMPORARY & DURABLE 6" YELLOW LINE**  
 STA 21+00 ~ 21+80 LT (EDGE--ISLAND)

**ADDED DURABLE SYMBOLS  
 STA 4+75 RT**

**LOOP DETECTORS  
 ADDED  
 SEE COD/SA #1**

**LOOP DETECTORS  
 ADDED  
 SEE COD/SA #1**

**POSSIBLE BURIED CABLE**

**MANUFACTURED TERMINAL SECTION (FLARED)**  
 STA 145+25 ~ 145+62 RT  
 STA 20+97 ~ 21+34 LT

**STEEL BEAM GUARDRAIL**  
 STA 145+62 ~ 146+00 RT

**REMOVE & DISPOSE GUARDRAIL**  
 STA 145+25 ~ 146+00 RT  
 STA 21+00 ~ 21+43 LT

**US BR4**


**STA 145+25 ~ 145+62 RT  
 NEW MTS (FLARED)**

**STA 145+62 ~ 146+00 RT  
 NEW STEEL BEAM GUARDRAIL**

**STA 145+25 ~ 146+00 RT  
 REMOVE & DISPOSE GUARDRAIL**

<b>PAVING          PROJECT          LAYOUT #13          BR 4</b>	PROJECT NAME: WEST RUTLAND	PLOT DATE: 06-FEB-2009 15:2
	PROJECT NUMBER: STP 2601(1) STP 2601(2)S	DRAWN BY: JLR
	FILE NAME: /pave/0ld046/pd046.dgn	CHECKED BY: JLR
	PROJECT LEADER: WOOLAVER	SHEET 22 OF 45

NOT TO SCALE

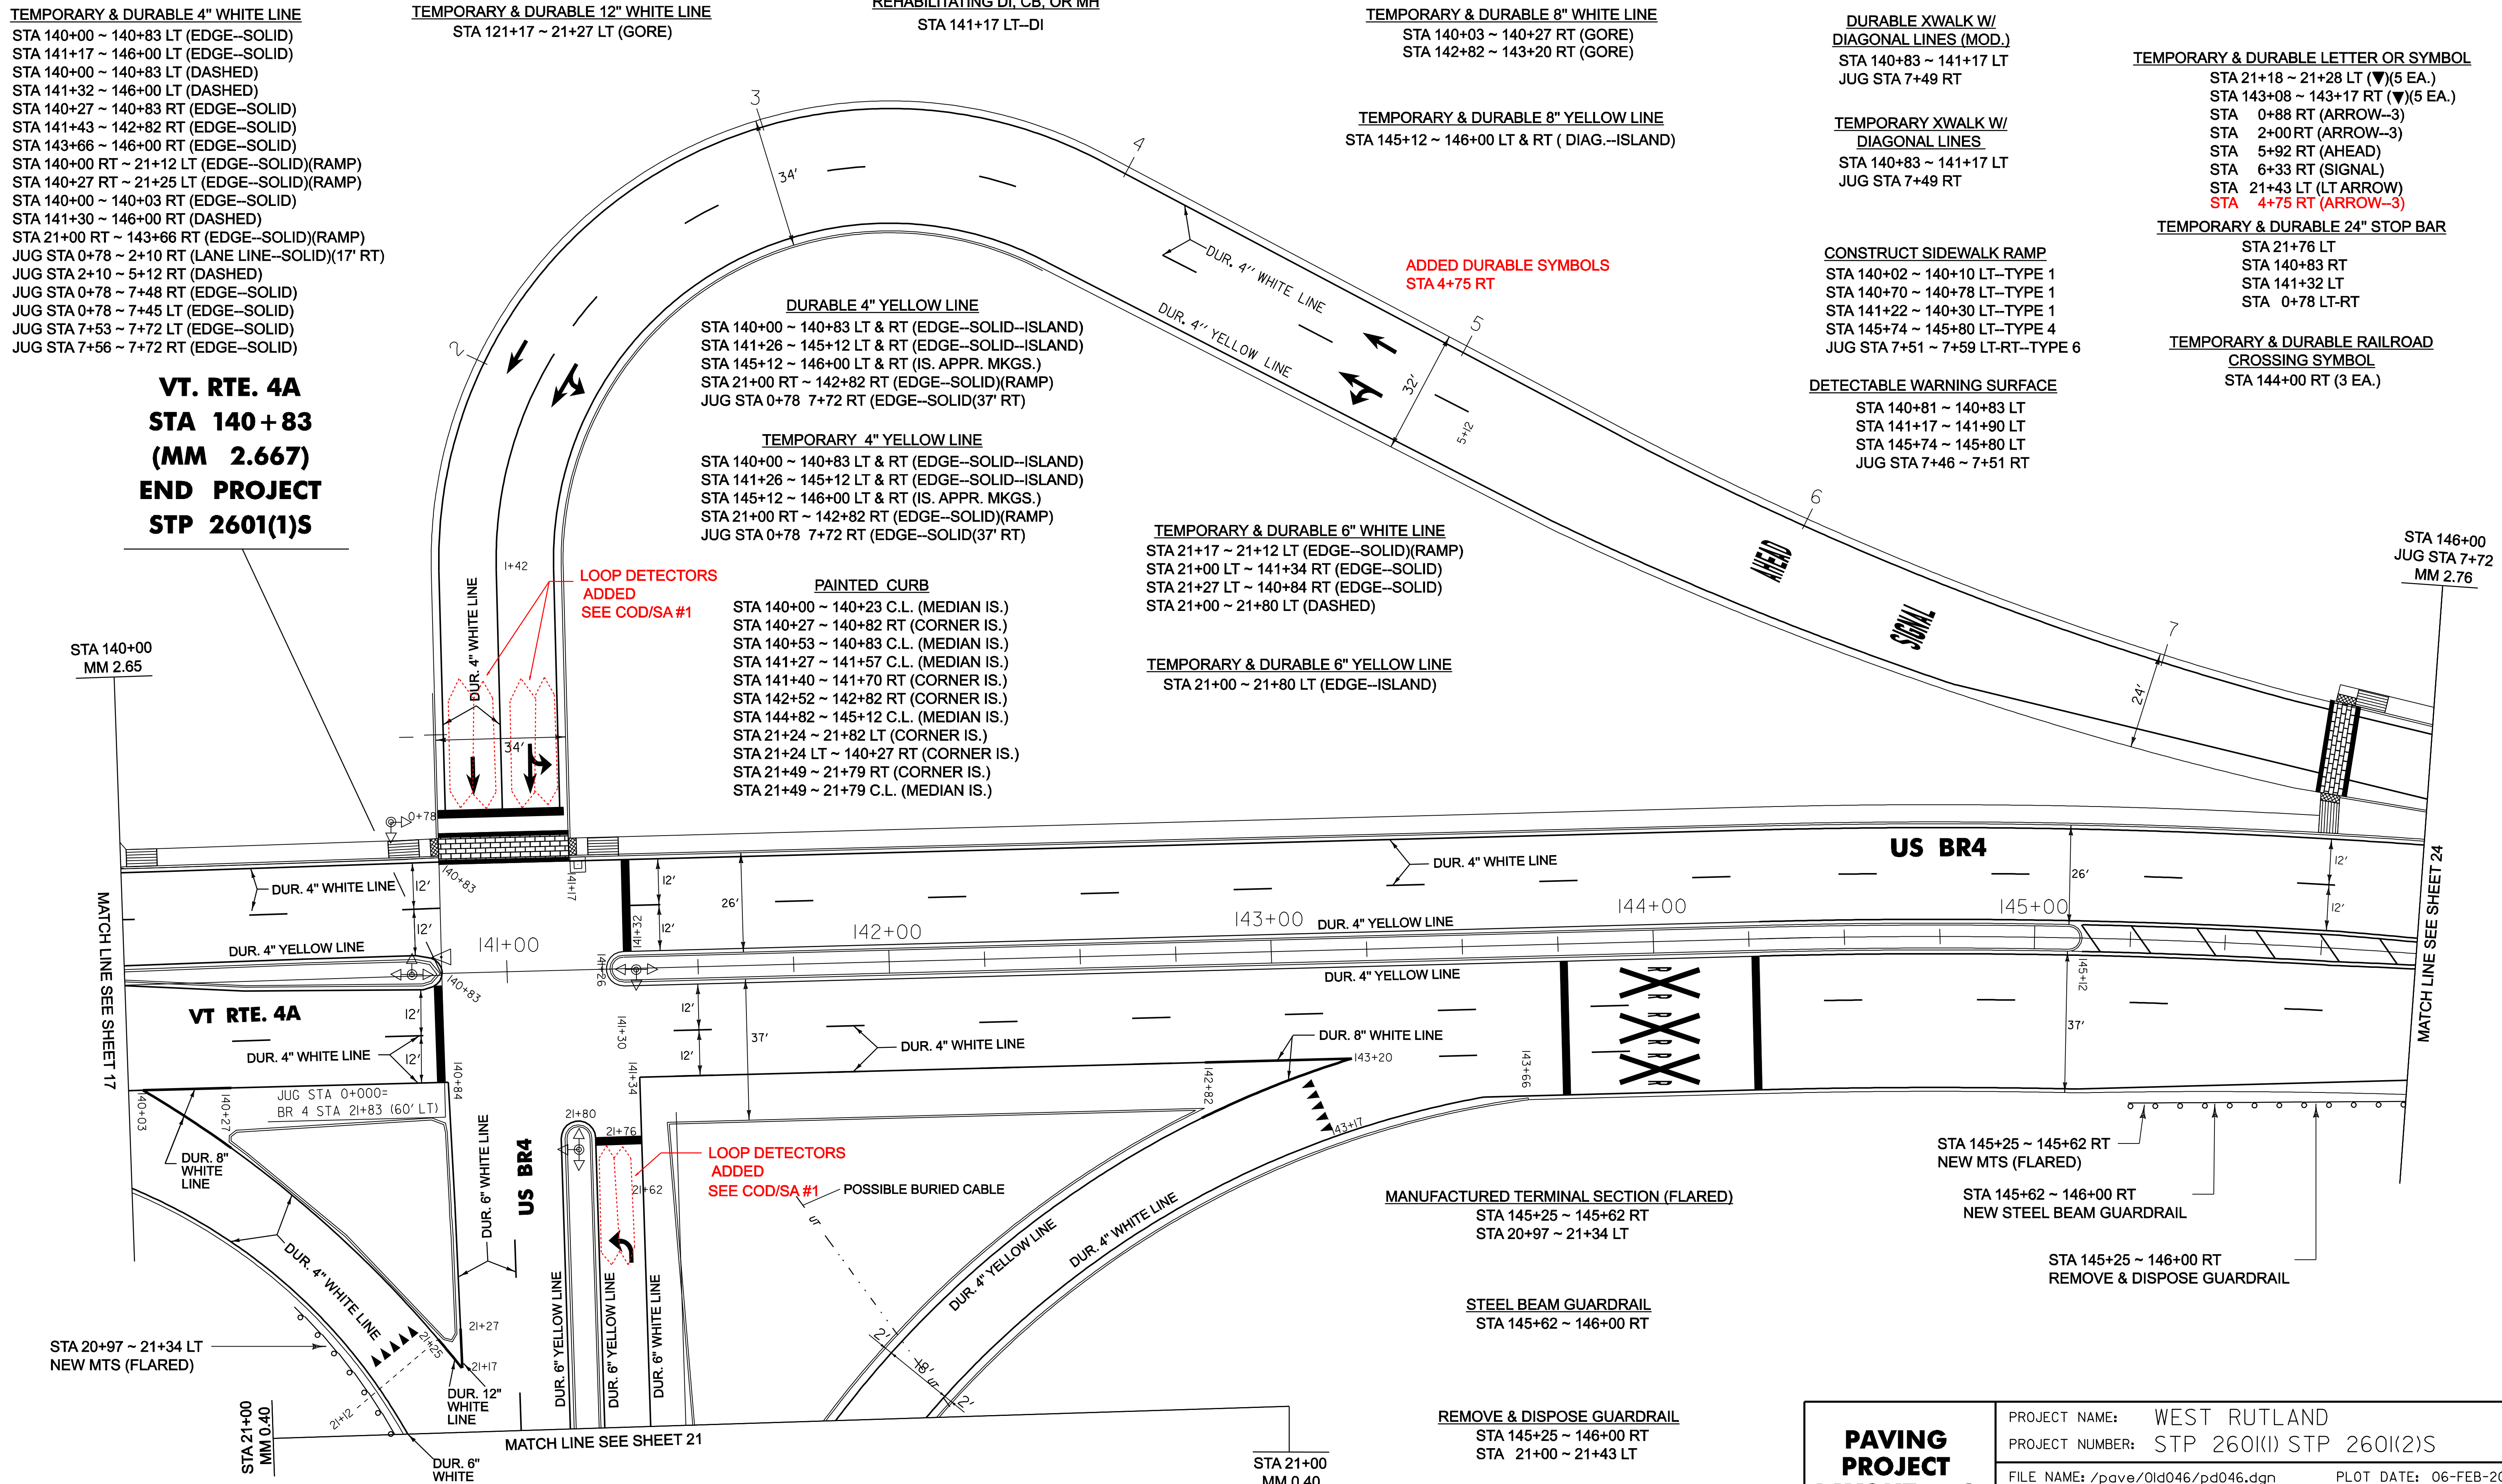

MATCH LINE SEE SHEET 17

MATCH LINE SEE SHEET 24

MATCH LINE SEE SHEET 21