
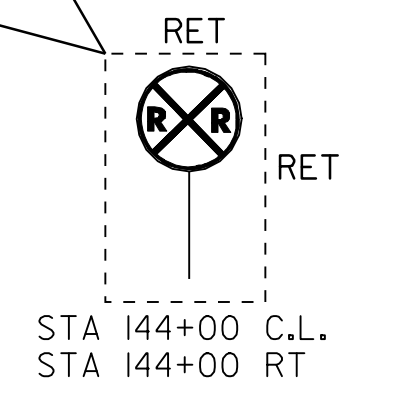
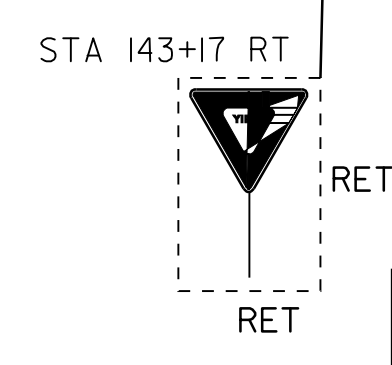
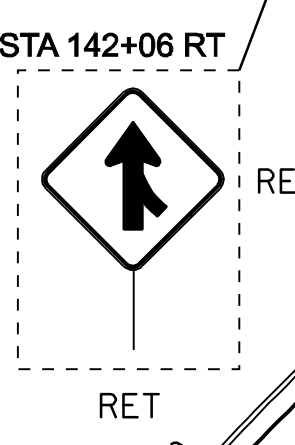
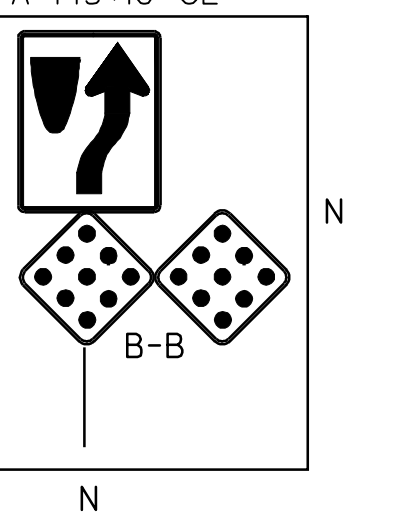
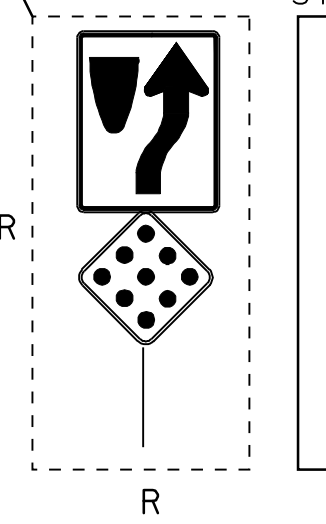
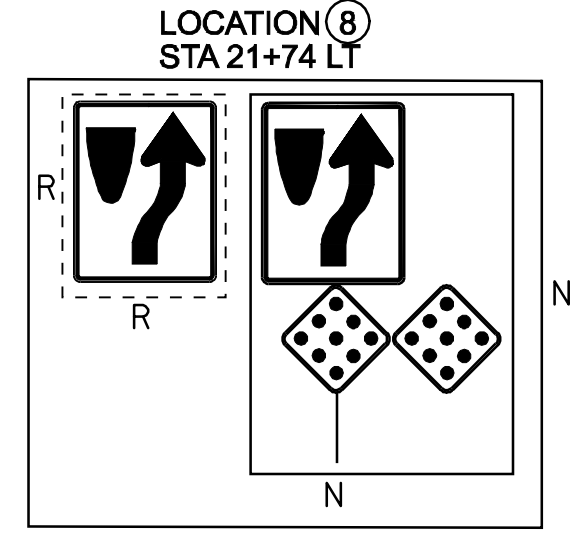
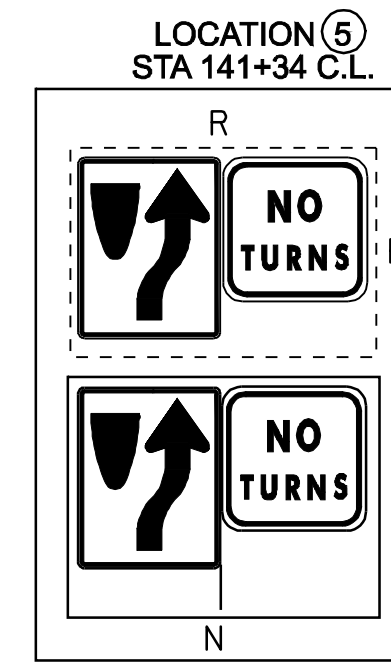
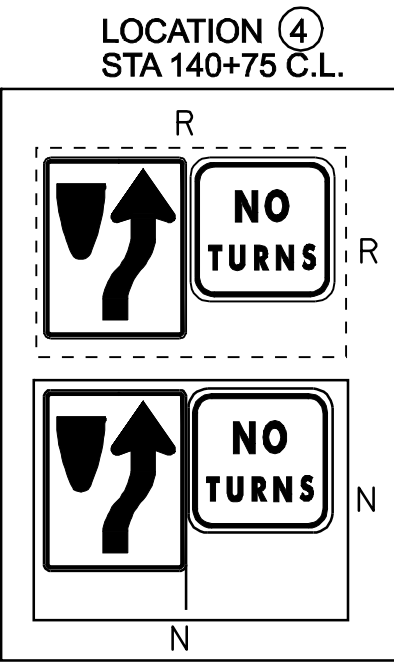
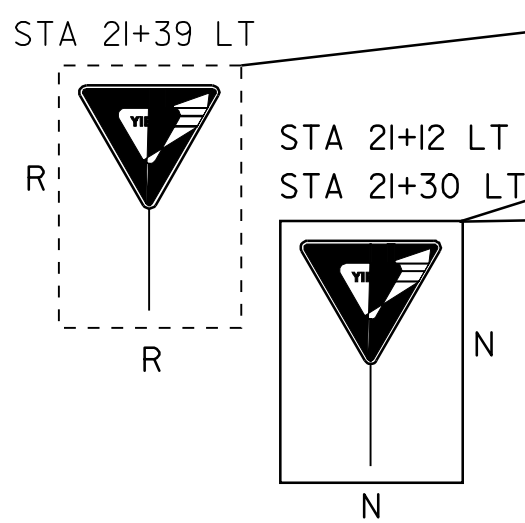
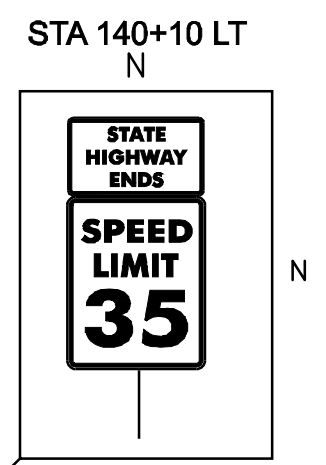
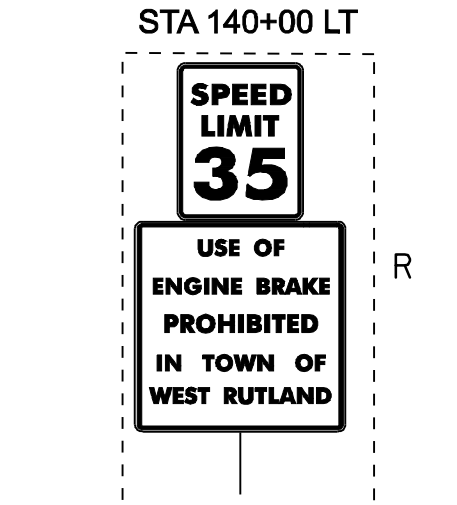
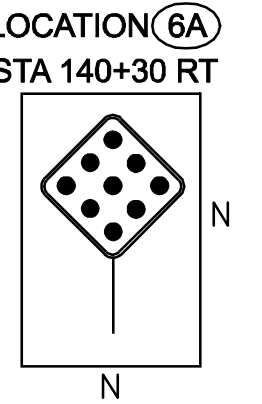
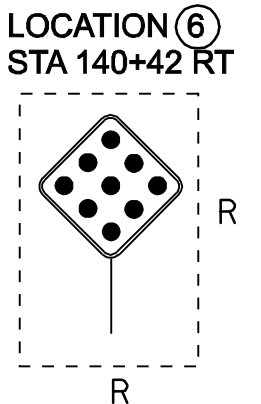
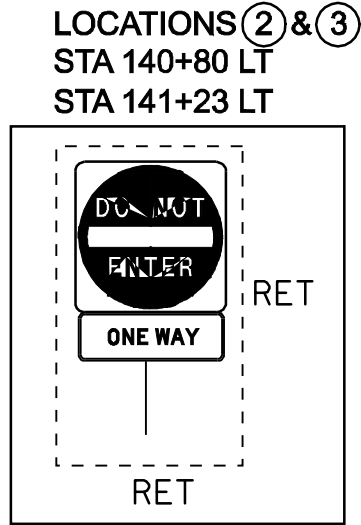
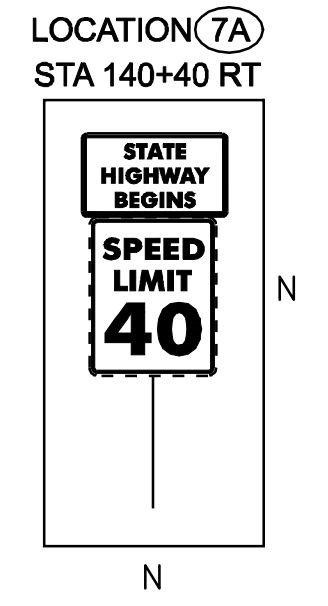
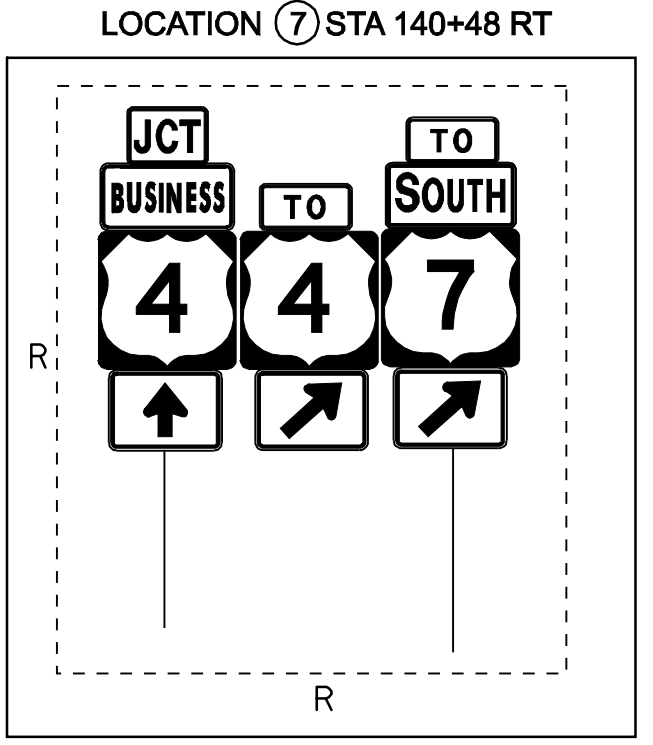
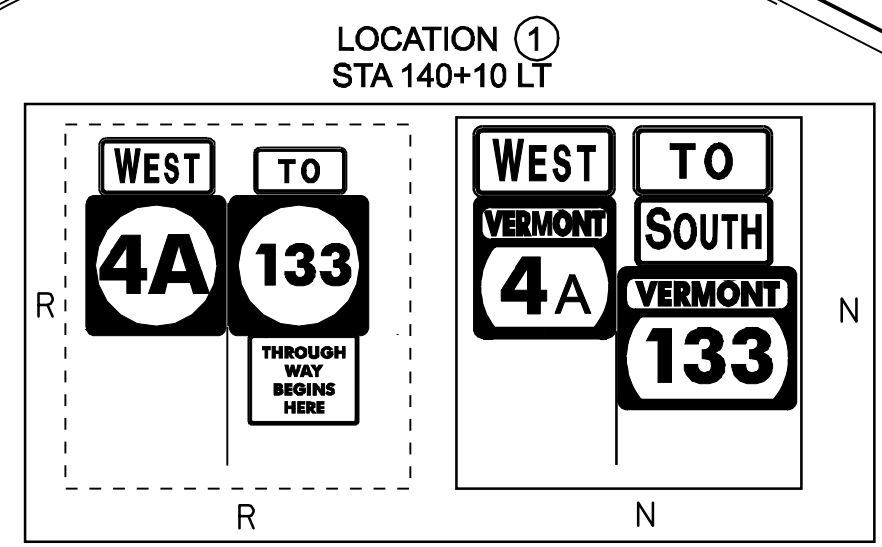
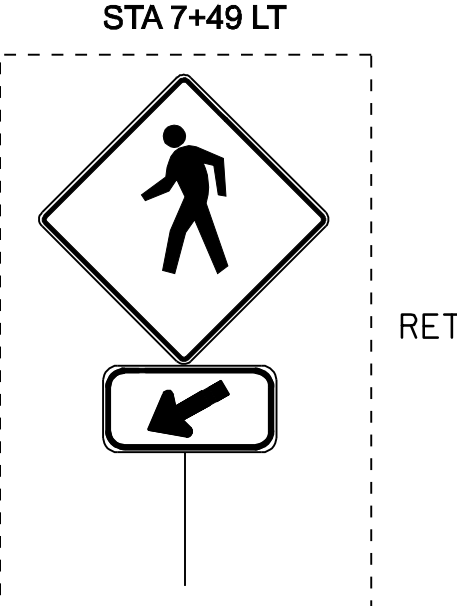
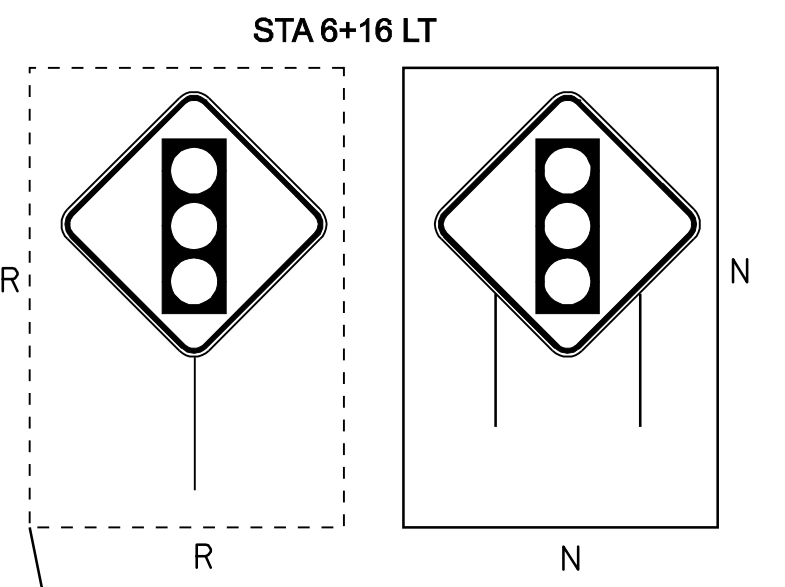
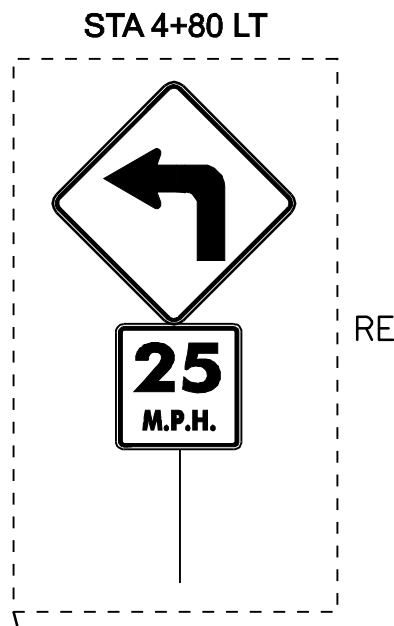


REMOVING SIGNS
AS SHOWN--28 EA

NOT TO SCALE

**PAVING
PROJECT
SIGN
LAYOUT #13A
BR 4**

PROJECT NAME: WEST RUTLAND	PLOT DATE: 06-FEB-2009 15:2
PROJECT NUMBER: STP 260(1)S STP 260(2)S	DRAWN BY: JLR
FILE NAME: /pave/0ld046/pd046.dgn	CHECKED BY: JLR
PROJECT LEADER: WOOLAVER	SHEET 23 OF 45
DESIGNED BY: JLR	
pd046113A.1	

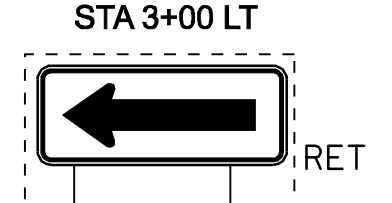

JUG STA 0+000= BR 4 STA 21+83 (60' LT)

MATCH LINE SEE SHEET 21

MATCH LINE SEE SHEET 17

MATCH LINE SEE SHEET 25

STA 21+00 MM 0.40

STA 21+00 MM 0.40

STA 146+00 JUG STA 7+72 MM 2.76