

DURABLE 4" WHITE LINE
 STA 7+73 RT ~ 148+22 LT (EDGE--SOLID)(CONNECTOR)
 STA 146+00 ~ 146+36 LT (EDGE--SOLID)(USBR4)
 STA 148+45 ~ 149+62 LT (EDGE--SOLID)
 STA 149+79 ~ 150+50 LT (EDGE--SOLID)
 STA 146+00 ~ 148+46 LT (DASHED)
 STA 148+80 ~ 150+50 LT (DASHED)
 STA 146+00 ~ 147+ 62 RT (EDGE--SOLID)
 STA 147+86 ~ 150+50 RT (EDGE--SOLID)
 STA 146+00 ~ 148+91 RT (DASHED)
 STA 146+69 ~ 148+22 LT (DOTTED LINE)
 STA 149+27~ 150+50 RT (DASHED)

TEMPORARY 4" WHITE LINE
 STA 7+73 RT ~ 148+22 LT (EDGE--SOLID)(CONNECTOR)
 STA 146+00 ~ 146+36 LT (EDGE--SOLID)(USBR4)
 STA 148+45 ~ 149+62 LT (EDGE--SOLID)
 STA 149+79 ~ 150+50 LT (EDGE--SOLID)
 STA 146+00 ~ 148+46 LT (DASHED)
 STA 148+80 ~ 150+50 LT (DASHED)
 STA 146+00 ~ 147+ 62 RT (EDGE--SOLID)
 STA 147+86 ~ 150+50 RT (EDGE--SOLID)
 STA 146+00 ~ 148+91 RT (DASHED)
 STA 146+69 ~ 148+22 LT (DOTTED LINE)
 STA 149+27~ 150+50 RT (DASHED)

DURABLE 4" YELLOW LINE
 STA 146+00 ~ 146+36 LT (CONNECTOR)
 STA 146+00 ~ 147+58 C.L. (IS. APPR. MKGS.)
 STA 147+98 ~ 150+50 C.L. (DBL. CTR.--SOLID)
 STA 147+74 RT (DBL. CTR.)(TH 55)
 STA 150+09 LT (DBL. CTR.--SOLID)(TH 4)

DURABLE LETTER OR SYMBOL
 STA 147+80 RT (STOP)(TH 55)
 STA 150+02 LT (STOP)(TH 4)

DURABLE 24" STOP BAR
 STA 147+74 ~ 147+87 RT (TH 55)
 STA 149+96 ~ 150+11 LT (PLEASANT ST.)
 STA 148+70 RT (RR XING)
 STA 149+35 LT (RR XING)
 STA 152+65 LT
 STA 153+15 LT

TEMPORARY LETTER OR SYMBOL
 STA 147+80 RT (STOP)(TH 55)
 STA 150+02 LT (STOP)(TH 4)

DURABLE 8" WHITE LINE
 STA 146+36 ~ 146+69 LT (GORE)

TEMPORARY 24" STOP BAR
 STA 147+74 ~ 147+87 RT (TH 55)
 STA 149+96 ~ 150+11 LT (PLEASANT ST.)
 STA 148+70 RT (RR XING)
 STA 149+35 LT (RR XING)
 STA 152+65 LT
 STA 153+15 LT


DURABLE 8" YELLOW LINE
 STA 146+00 ~ 146+79 C.L. (DIAG.--ISLAND)

TEMPORARY 8" YELLOW LINE
 STA 146+00 ~ 146+79 C.L. (IS. APPR. MKGS.)

DURABLE RAILROAD CROSSING SYMBOL
 STA 152+90 LT (2 EA.)

TEMPORARY RAILROAD CROSSING SYMBOL
 STA 152+90 LT (2 EA.)

US BR4
STA 150+50
(MM 0.596)
END PROJECT
STP 2601(2)S

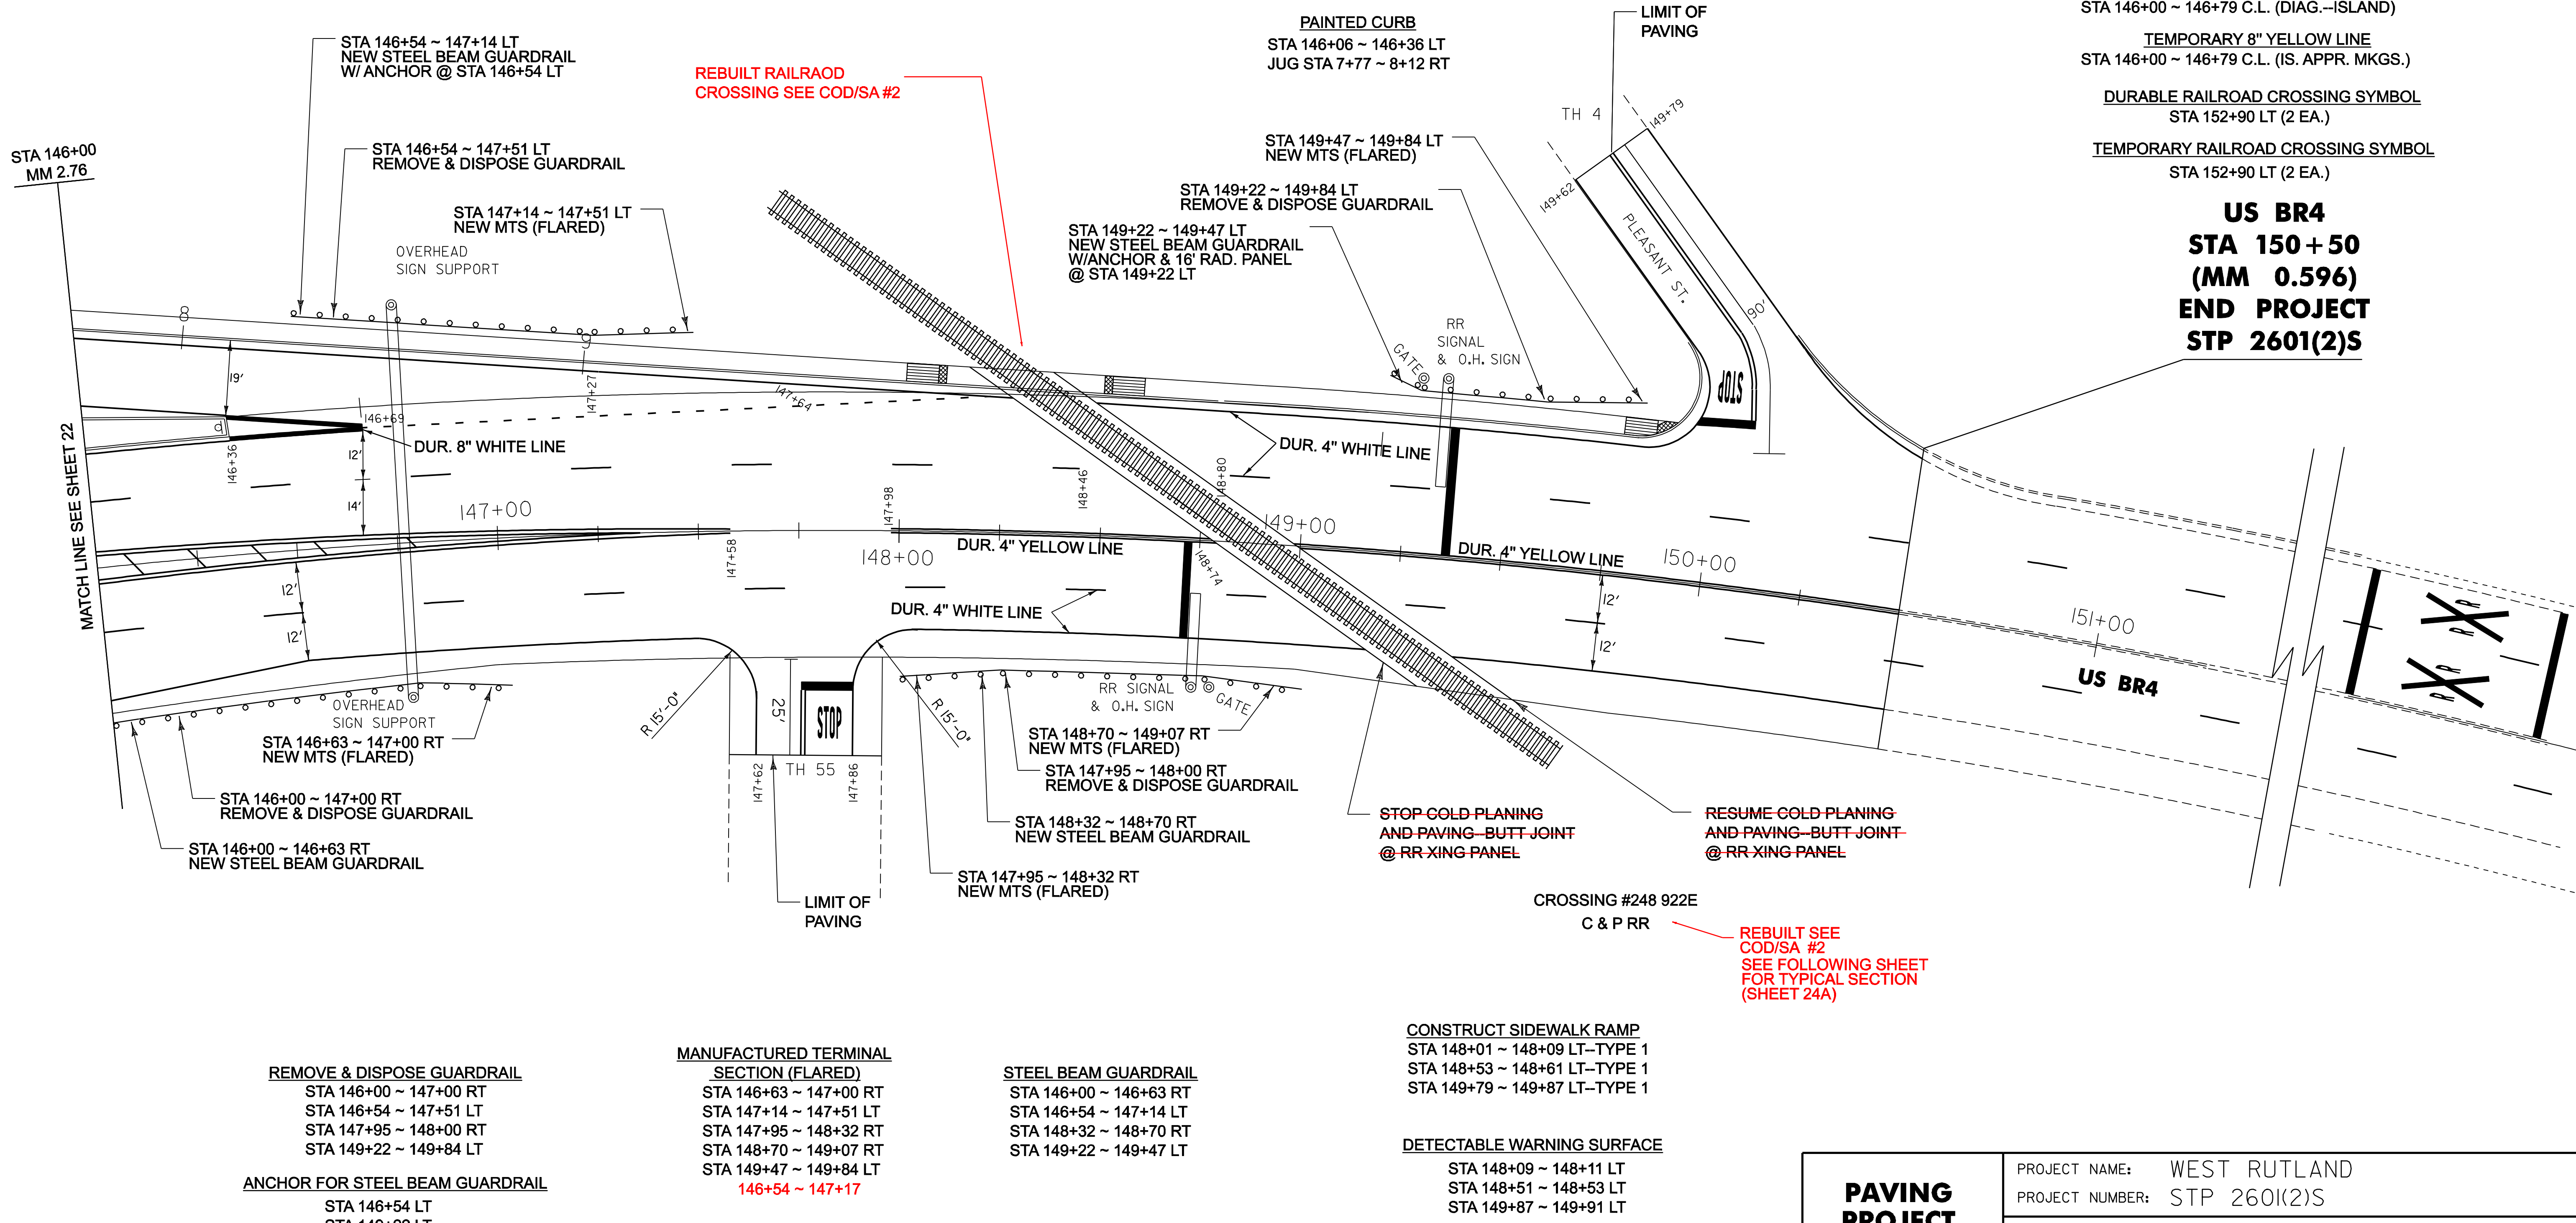

REMOVE & DISPOSE GUARDRAIL
 STA 146+00 ~ 147+00 RT
 STA 146+54 ~ 147+51 LT
 STA 147+95 ~ 148+00 RT
 STA 149+22 ~ 149+84 LT

ANCHOR FOR STEEL BEAM GUARDRAIL
 STA 146+54 LT
 STA 149+22 LT

MANUFACTURED TERMINAL SECTION (FLARED)
 STA 146+63 ~ 147+00 RT
 STA 147+14 ~ 147+51 LT
 STA 147+95 ~ 148+32 RT
 STA 148+70 ~ 149+07 RT
 STA 149+47 ~ 149+84 LT
 146+54 ~ 147+17

STEEL BEAM GUARDRAIL
 STA 146+00 ~ 146+63 RT
 STA 146+54 ~ 147+14 LT
 STA 148+32 ~ 148+70 RT
 STA 149+22 ~ 149+47 LT

CONSTRUCT SIDEWALK RAMP
 STA 148+01 ~ 148+09 LT--TYPE 1
 STA 148+53 ~ 148+61 LT--TYPE 1
 STA 149+79 ~ 149+87 LT--TYPE 1

DETECTABLE WARNING SURFACE
 STA 148+09 ~ 148+11 LT
 STA 148+51 ~ 148+53 LT
 STA 149+87 ~ 149+91 LT

CROSSING #248 922E
 C & P RR

REBUILT SEE COD/SA #2
SEE FOLLOWING SHEET FOR TYPICAL SECTION (SHEET 24A)

PAVING PROJECT LAYOUT #14 BR 4	PROJECT NAME: WEST RUTLAND	PLOT DATE: 06-FEB-2009 15:2
	PROJECT NUMBER: STP 2601(2)S	DRAWN BY: JLR
	FILE NAME: /pave/01d046/pd046.dgn	CHECKED BY: JLR
	PROJECT LEADER: WOOLAVER	SHEET 24 OF 45

NOT TO SCALE