
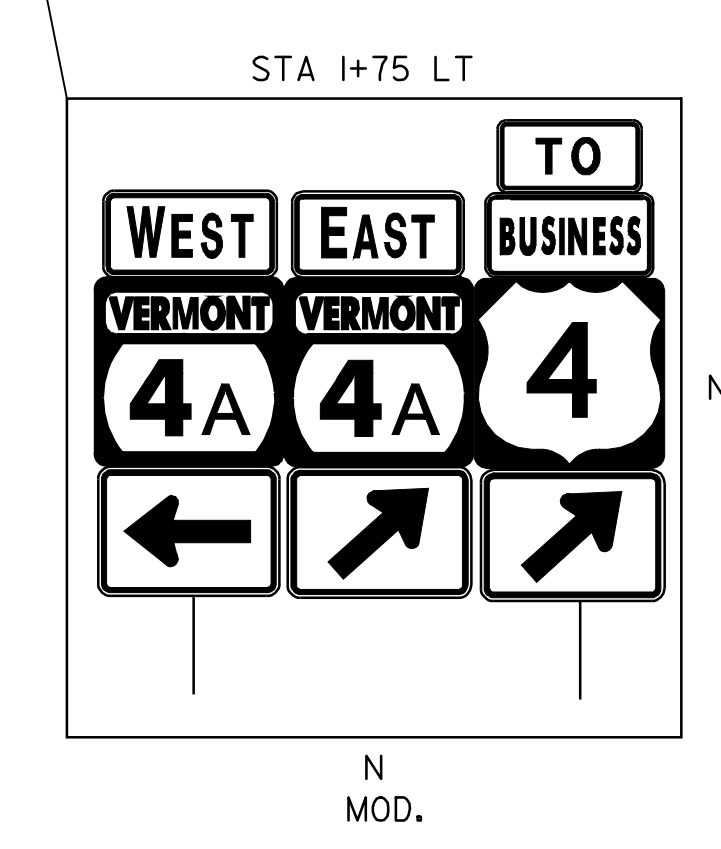
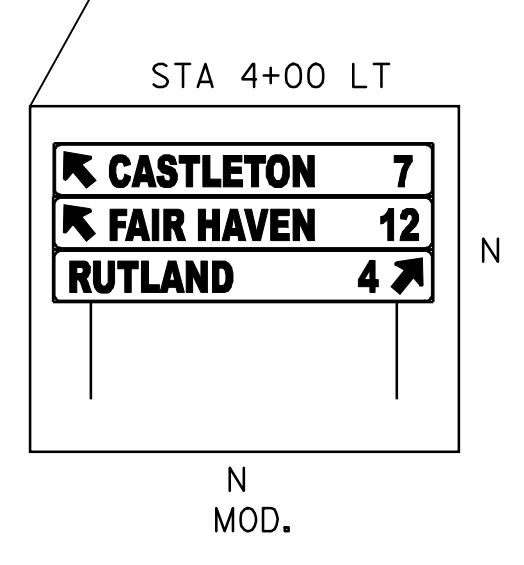
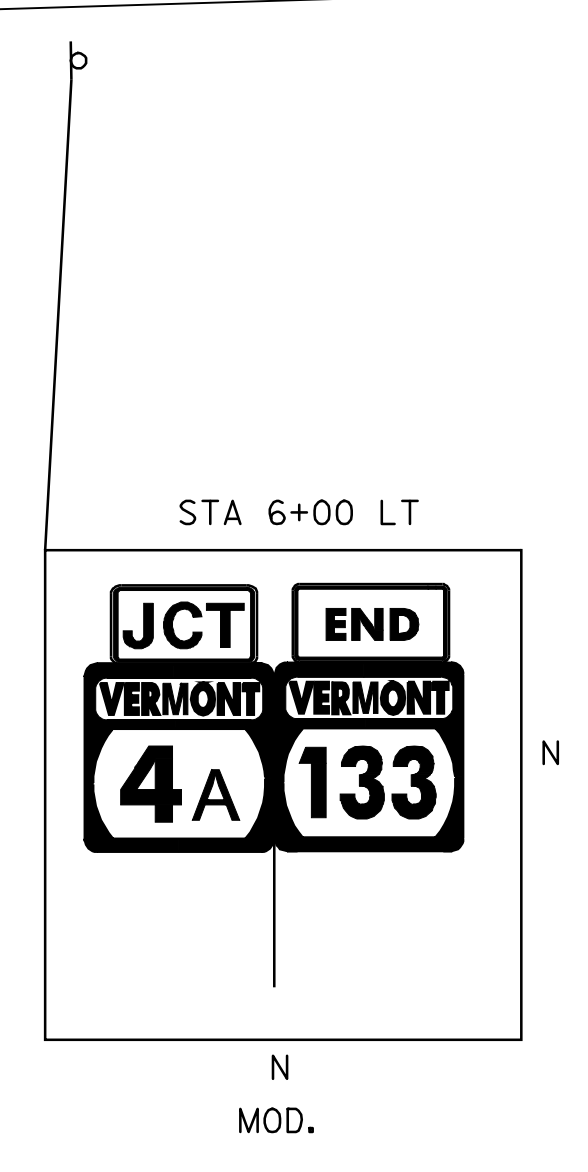


REMOVING SIGNS
AS SHOWN-3

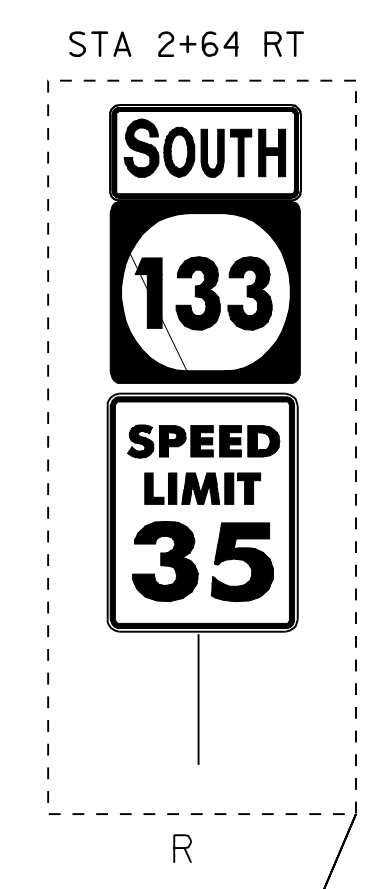

NOT TO SCALE

PAVING PROJECT LAYOUT #15 VT 133 SIGNS	PROJECT NAME: WEST RUTLAND	PLOT DATE: 06-FEB-2009 15:2
	PROJECT NUMBER: STP 260(I)S	DRAWN BY: JLR
	FILE NAME: /pave/01d046/pd046.dgn	CHECKED BY: JLR
	PROJECT LEADER: WOOLAVER	SHEET 26 OF 45