


TEMPORARY 100mm WHITE LINE, PAINT  
 DURABLE 100mm WHITE LINE, THERMOPLASTIC  
 STA 1+420 TO 1+560 SOLID LT & RT

CHANGING ELEVATION OF DROP INLETS,  
 CATCH BASINS, OR MANHOLES  
 STA 1+421 RT (CB)

\* NOTE  
 STA 1+550 TO STA 1+560 RT  
 NO PARKING ALLOWED. LOCATION OF  
 EXISTING "NO PARKING" SIGNS NOT  
 SHOWN ON THESE PLANS.

TEMPORARY 100mm YELLOW LINE, PAINT  
 DURABLE 100mm YELLOW LINE, THERMOPLASTIC  
 STA 1+420 TO 1+560 SOLID LT & RT

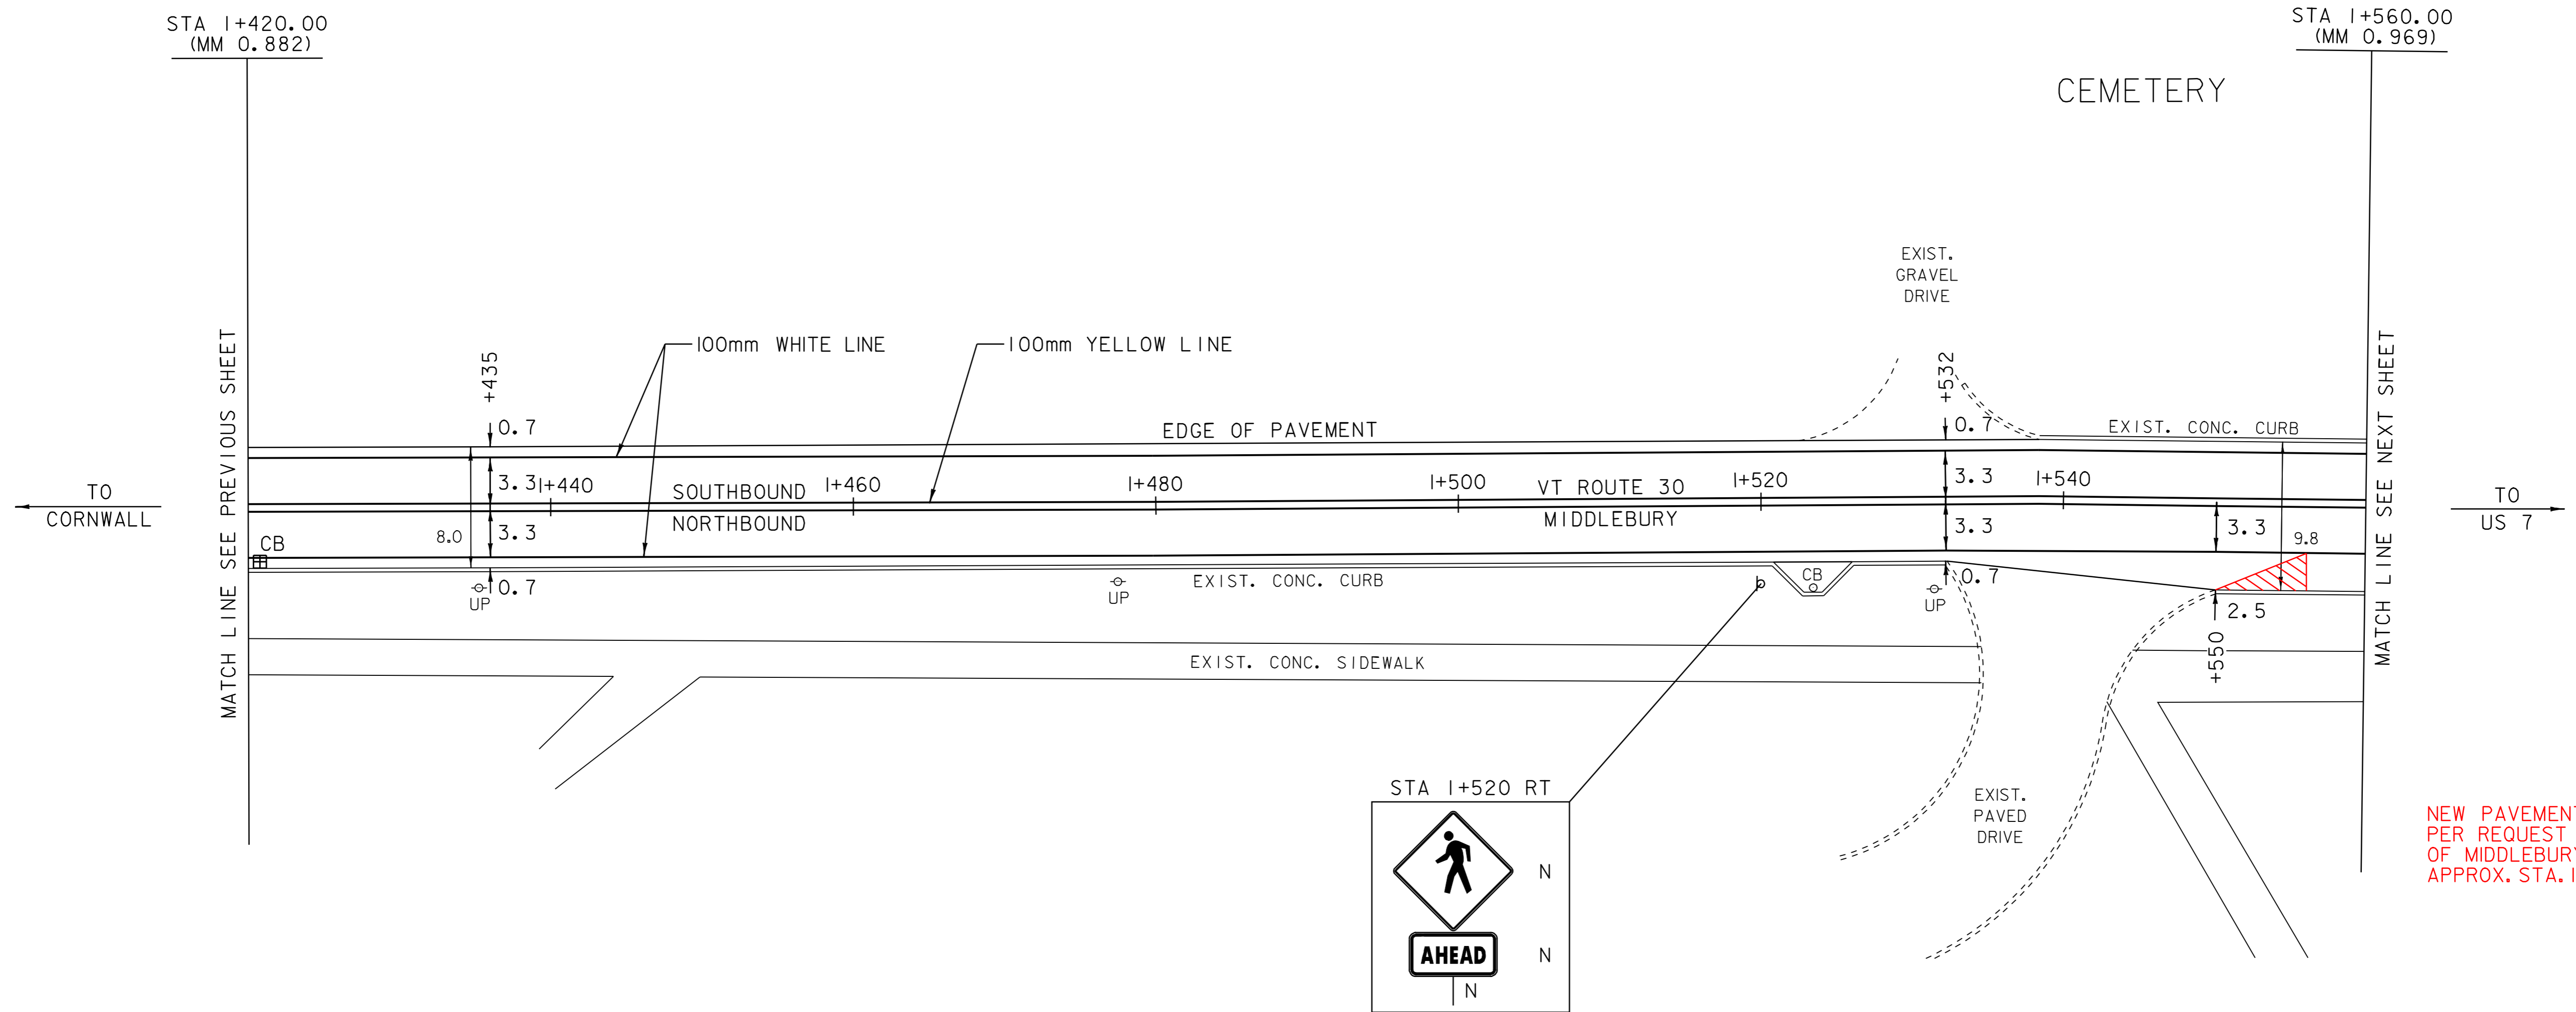

NEW PAVEMENT STALLS  
 PER REQUEST OF THE TOWN  
 OF MIDDLEBURY  
 APPROX. STA. 1+555 RT



- LEGEND**
- R = REMOVE EXISTING
  - S = SALVAGE
  - R&S = REMOVE AND SALVAGE
  - N = NEW
  - RET = RETAIN
  - B-B = BACK TO BACK

|                                   |                              |
|-----------------------------------|------------------------------|
| <b>PAVING LAYOUT 5</b>            |                              |
| PROJECT NAME: MIDDLEBURY          | PROJECT NUMBER: STP 2304(I)S |
| FILE NAME: /pave/0ld048/pd048.dgn | PLOT DATE: 06-OCT-2008 13:00 |
| PROJECT LEADER: PTS               | DRAWN BY: MRS                |
| IPARM FILE NAME: pd048i05.i       | CHECKED BY: NLL              |
|                                   | SHEET 23 OF 103              |

NOT TO SCALE

NOTE: ALL DIMENSIONS IN METERS EXCEPT AS INDICATED