

TEMPORARY 100mm WHITE LINE, PAINT  
 DURABLE 100mm WHITE LINE, THERMOPLASTIC  
 STA 1+560 TO 1+649 SOLID LT  
 STA 1+560 TO 1+649 SOLID RT  
 STA 1+651 TO 1+700 SOLID RT  
 STA 1+651 TO 1+700 SOLID LT


TEMPORARY CROSSWALK MARKING, PAINT  
 STA 1+650 LT TO RT  
 SPECIAL PROVISION (DURABLE  
 CROSSWALK MARKING, IMPRINTED/COLORIZED)  
 STA 1+650 LT TO RT

CONSTRUCT SIDEWALK RAMP W/DETECTABLE  
 WARNING SURFACE (YELLOW)  
 STA 1+650 LT (TYPE 6)  
 STA 1+650 RT (TYPE 2)

CHANGING ELEVATION OF DROP INLET,  
 CATCH BASINS, OR MANHOLES  
 STA 1+654 RT (CB)

TEMPORARY 100mm YELLOW LINE, PAINT  
 DURABLE 100mm YELLOW LINE, THERMOPLASTIC  
 STA 1+560 TO 1+649 SOLID LT & RT  
 STA 1+651 TO 1+700 SOLID LT & RT

\* NOTE  
 STA 1+560 TO STA 1+700 RT  
 NO PARKING ALLOWED. LOCATION OF  
 EXISTING "NO PARKING" SIGNS NOT  
 SHOWN ON THESE PLANS.

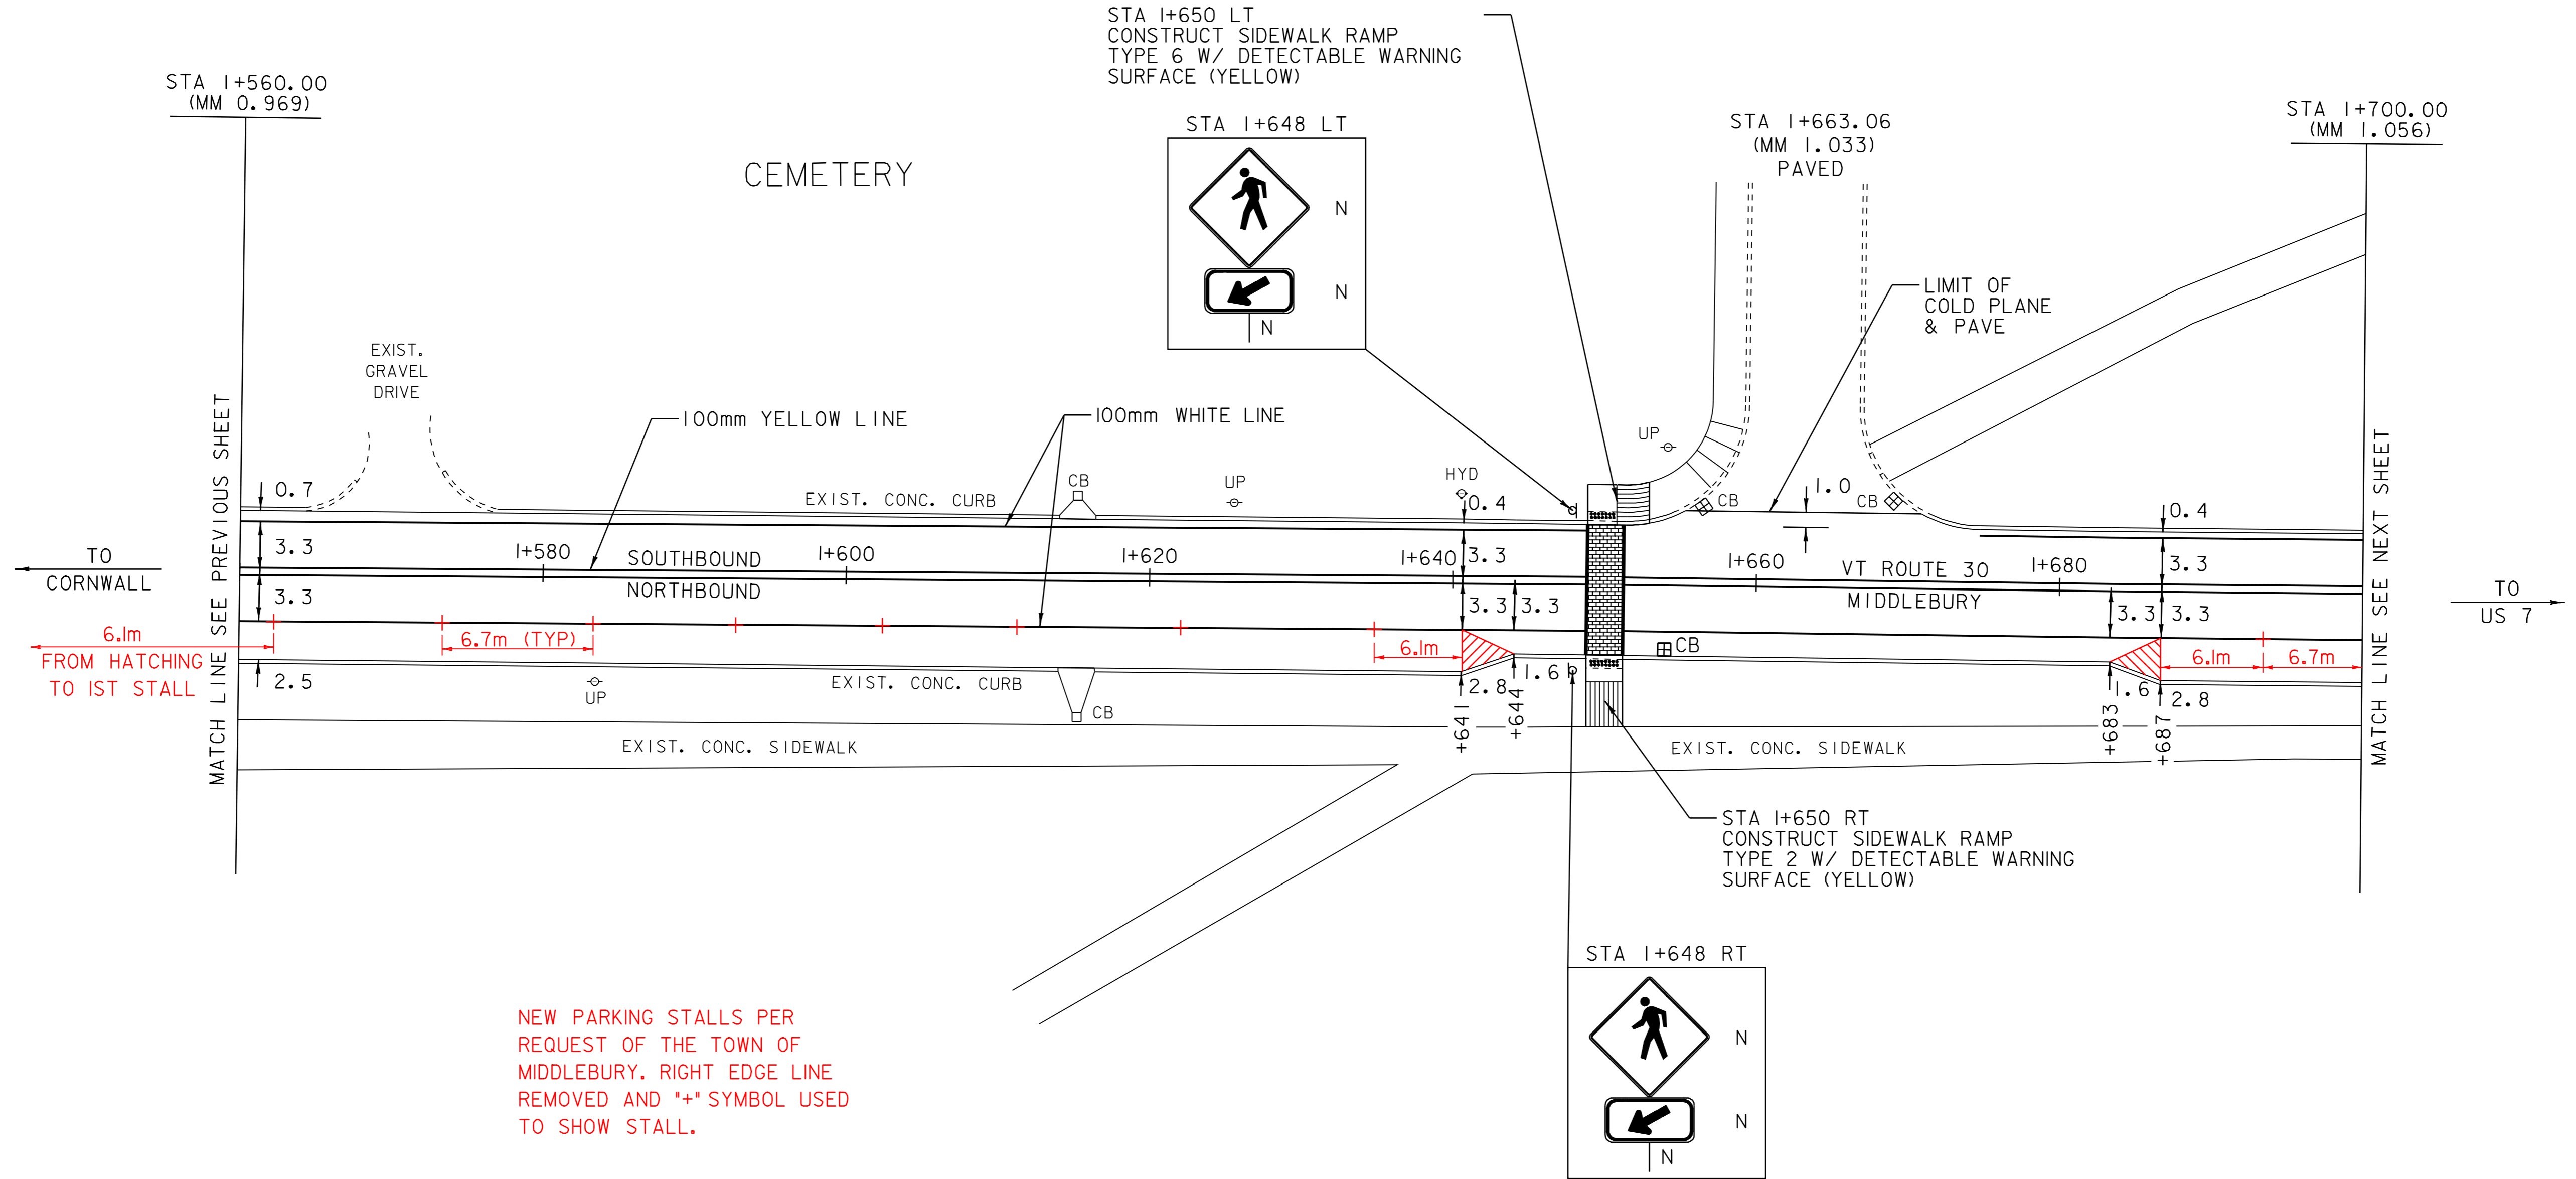

NEW PARKING STALLS PER  
 REQUEST OF THE TOWN OF  
 MIDDLEBURY. RIGHT EDGE LINE  
 REMOVED AND "\*" SYMBOL USED  
 TO SHOW STALL.

LEGEND

R	=	REMOVE EXISTING
S	=	SALVAGE
R&S	=	REMOVE AND SALVAGE
N	=	NEW
RET	=	RETAIN
B-B	=	BACK TO BACK

PAVING LAYOUT 6

PROJECT NAME:	MIDDLEBURY
PROJECT NUMBER:	STP 2304(I)S
FILE NAME:	/pave/01d048/pd048.dgn
PROJECT LEADER:	PTS
IPARM FILE NAME:	pd048i06.1
PLOT DATE:	06-OCT-2008 13:00
DRAWN BY:	MRS
CHECKED BY:	NLL
SHEET	24 OF 103

NOT TO SCALE

NOTE: ALL DIMENSIONS IN METERS EXCEPT AS INDICATED