

TEMPORARY 100mm WHITE LINE, PAINT
 DURABLE 100mm WHITE LINE, THERMOPLASTIC
 STA 1+700 TO 1+801 SOLID LT
 STA 1+700 TO 1+804 SOLID RT
 STA 1+824 TO 1+840 SOLID LT & RT


TEMPORARY 100mm YELLOW LINE, PAINT
 DURABLE 100mm YELLOW LINE, THERMOPLASTIC
 STA 1+700 TO 1+821 SOLID LT & RT
 STA 1+824 TO 1+840 SOLID LT & RT

TEMPORARY CROSSWALK MARKING, PAINT
 STA 1+810 TO 1+819 RT
 STA 1+823 LT TO RT
 SPECIAL PROVISION (DURABLE
 CROSSWALK MARKING, IMPRINTED/COLORIZED)
 STA 1+810 TO 1+819 RT
 STA 1+823 LT TO RT

CONSTRUCT SIDEWALK RAMP W/DETECTABLE
 WARNING SURFACE (YELLOW)
 STA 1+810 RT (TYPE 6)
 STA 1+819 RT (TYPE 1)
 STA 1+823 LT (TYPE 1)
 STA 1+823 RT (TYPE 1)

CHANGING ELEVATION OF DROP INLETS,
 CATCH BASINS, OR MANHOLES
 STA 1+804 LT (CB)
 STA 1+809 RT (CB)
 STA 1+827 LT (CB)
 CHANGING ELEVATION OF SEWER MANHOLES
 STA 1+773 RT

* NOTE
 STA 1+700 TO STA 1+840 RT
 NO PARKING ALLOWED. LOCATION OF
 EXISTING "NO PARKING" SIGNS NOT
 SHOWN ON THESE PLANS.

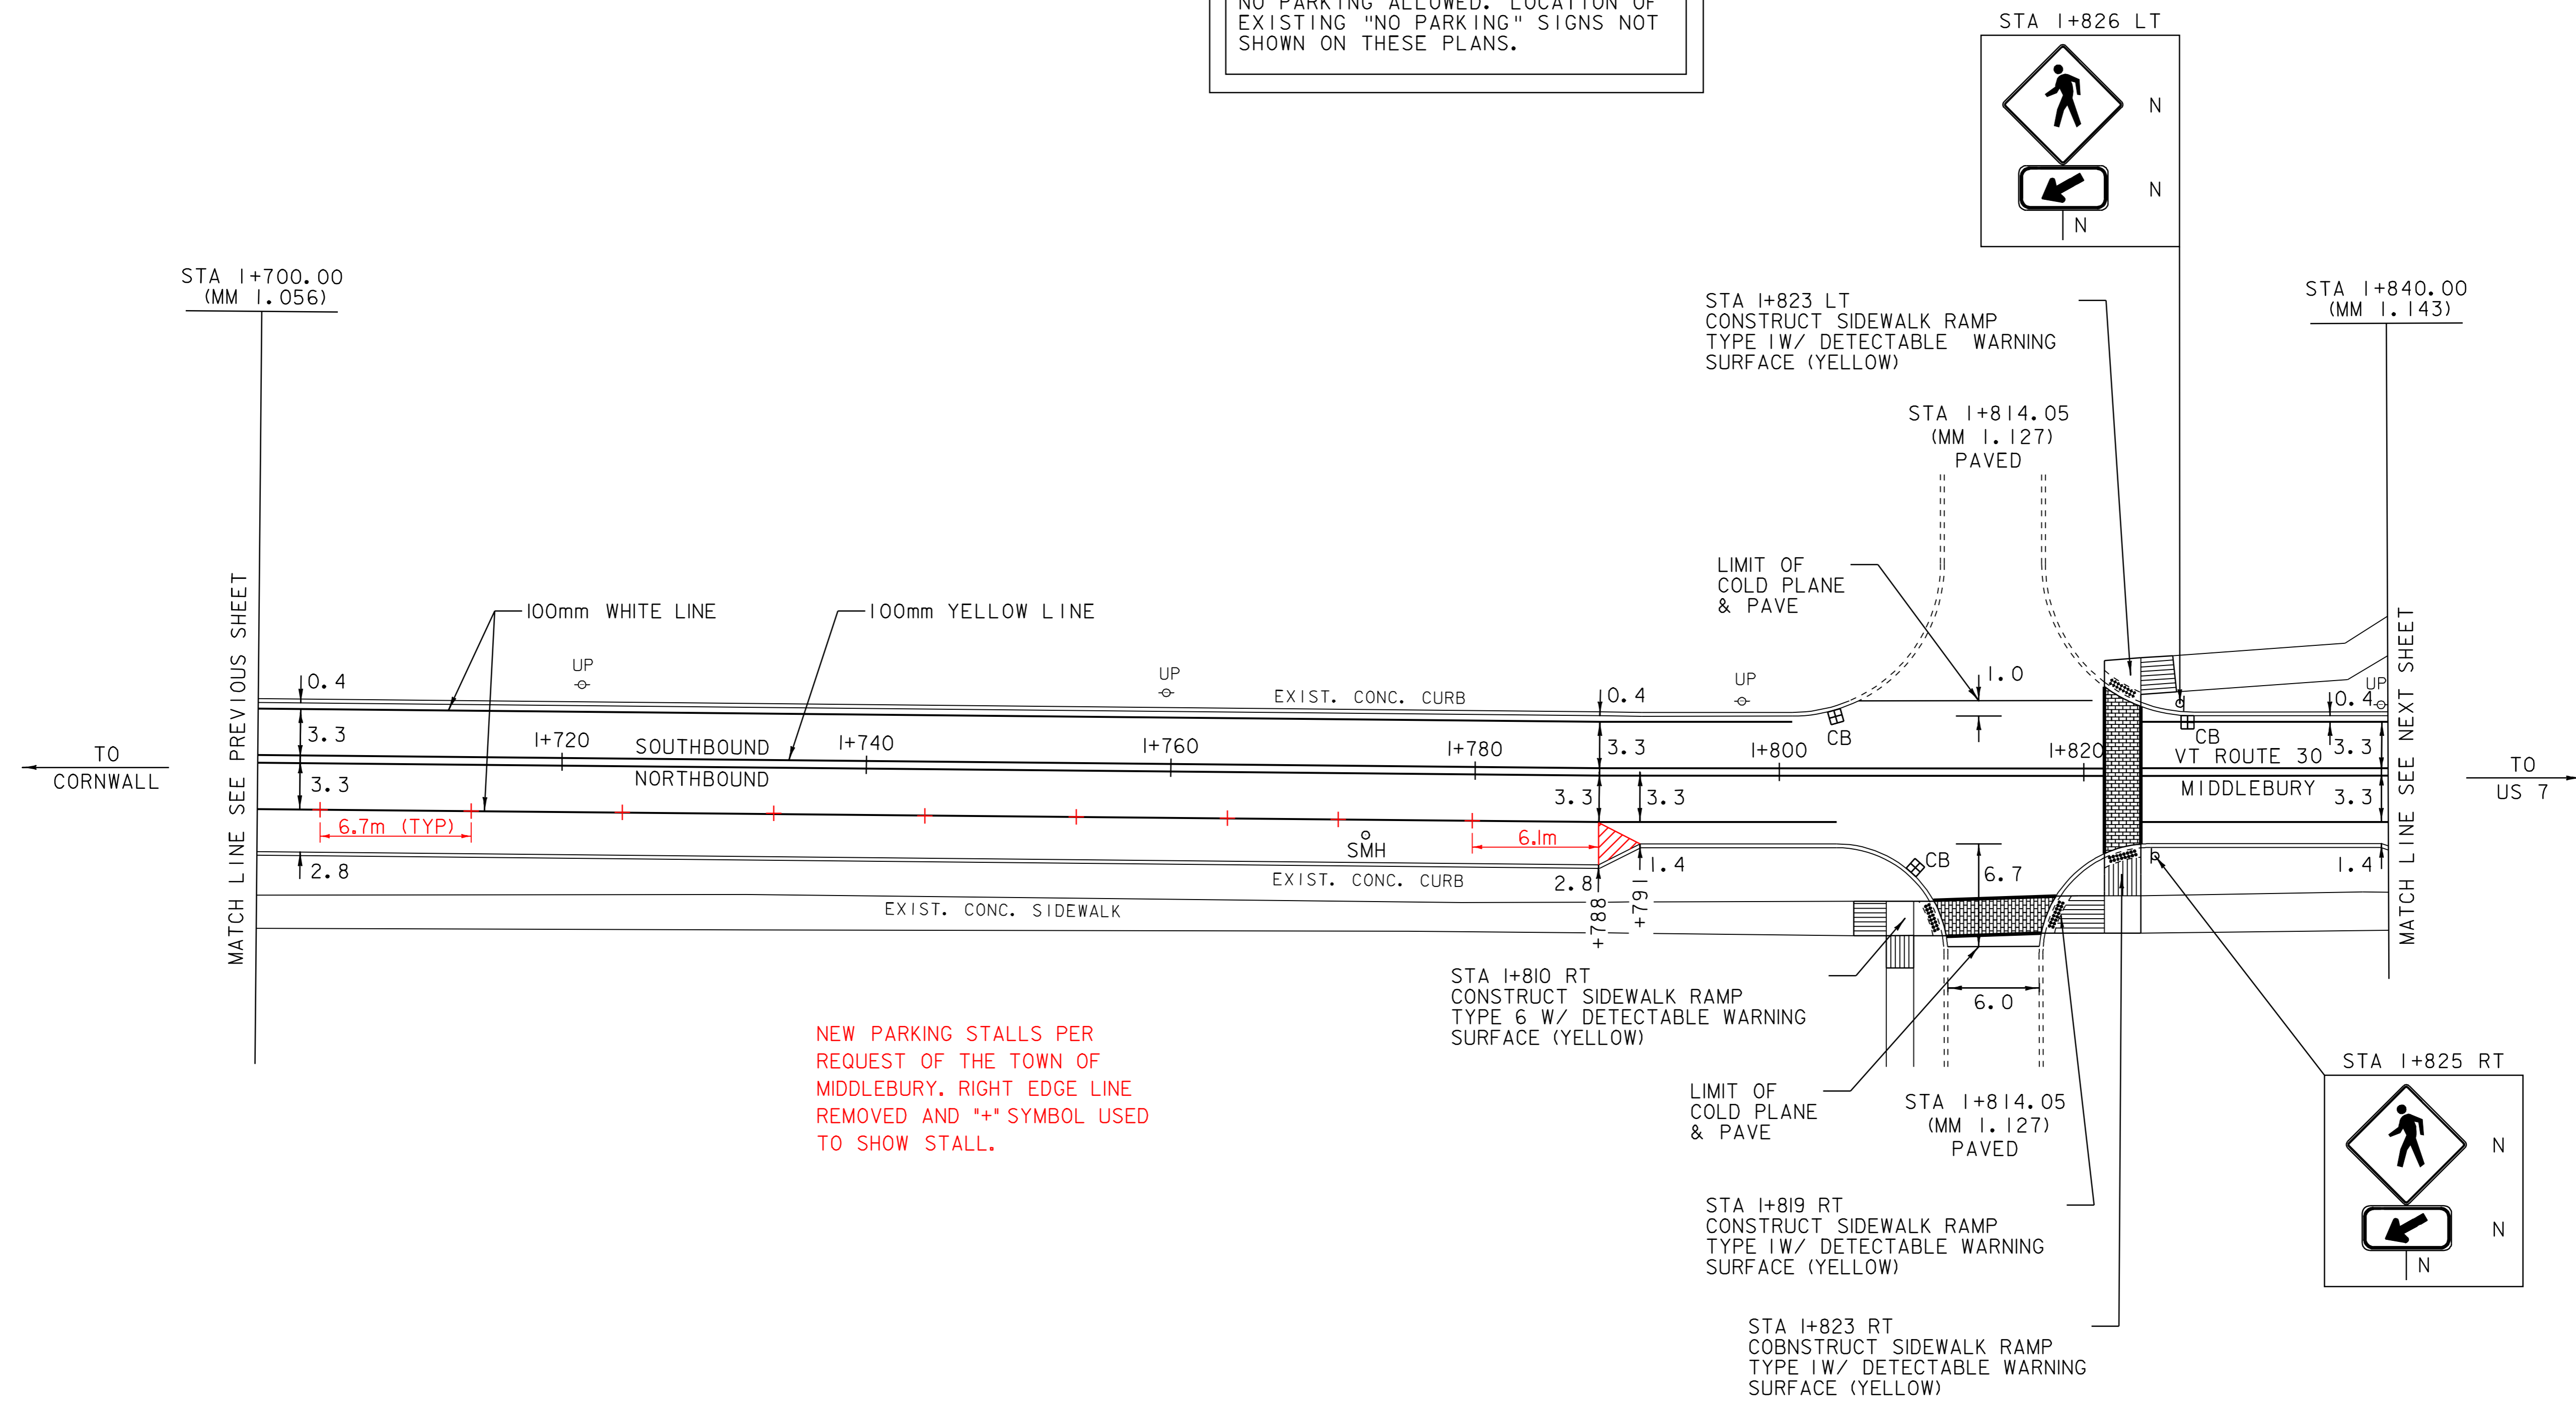

NEW PARKING STALLS PER
 REQUEST OF THE TOWN OF
 MIDDLEBURY. RIGHT EDGE LINE
 REMOVED AND "+" SYMBOL USED
 TO SHOW STALL.

LEGEND

- R = REMOVE EXISTING
- S = SALVAGE
- R&S = REMOVE AND SALVAGE
- N = NEW
- RET = RETAIN
- B-B = BACK TO BACK

PAVING LAYOUT 7

PROJECT NAME: MIDDLEBURY	FILE NAME: /pave/01d048/pd048.dgn	PLOT DATE: 06-OCT-2008 13:0
PROJECT NUMBER: STP 2304(I)S	PROJECT LEADER: PTS	DRAWN BY: MRS
	IPARM FILE NAME: pd048i07.i	CHECKED BY: NLL
		SHEET 25 OF 103

NOT TO SCALE

NOTE: ALL DIMENSIONS IN METERS EXCEPT AS INDICATED