

TEMPORARY 100mm WHITE LINE, PAINT
 DURABLE 100mm WHITE LINE, THERMOPLASTIC
 STA 2+120 TO 2+260 SOLID LT
 STA 2+126 TO 2+133 SOLID RT NO PARKING
 STA 2+139 TO 2+144 SOLID RT NO PARKING
 STA 2+150 TO 2+155 SOLID RT NO PARKING
 STA 2+159 TO 2+161 SOLID RT NO PARKING
 STA 2+187 TO 2+189 SOLID RT NO PARKING
 STA 2+191 TO 2+194 SOLID RT NO PARKING
 STA 2+233 TO 2+236 SOLID RT NO PARKING
 STA 2+243 TO 2+247 SOLID RT NO PARKING

TEMPORARY 150mm WHITE LINE, PAINT
 DURABLE 150mm WHITE LINE, THERMOPLASTIC
 STA 2+120 TO 2+126 TARGETS RT PARKING
 STA 2+144 TO 2+150 TARGETS RT PARKING
 STA 2+161 TO 2+187 TARGETS RT PARKING
 STA 2+194 TO 2+233 TARGETS RT PARKING
 STA 2+247 TO 2+260 TARGETS RT PARKING

TEMPORARY 100mm YELLOW LINE, PAINT
 DURABLE 100mm YELLOW LINE, THERMOPLASTIC
 STA 2+120 TO 2+260 SOLID LT & RT

CHANGING ELEVATION OF DROP INLETS,
 CATCH BASINS, OR MANHOLES


STA 2+235 LT (CB)
 STA 2+235 RT (CB)

CHANGING ELEVATION OF SEWER MANHOLES

STA 2+233 RT
 STA 2+241 RT

ADJUST ELEVATION OF VALVE BOX

STA 2+126 RT
 STA 2+127 RT
 STA 2+130 RT
 STA 2+239 RT

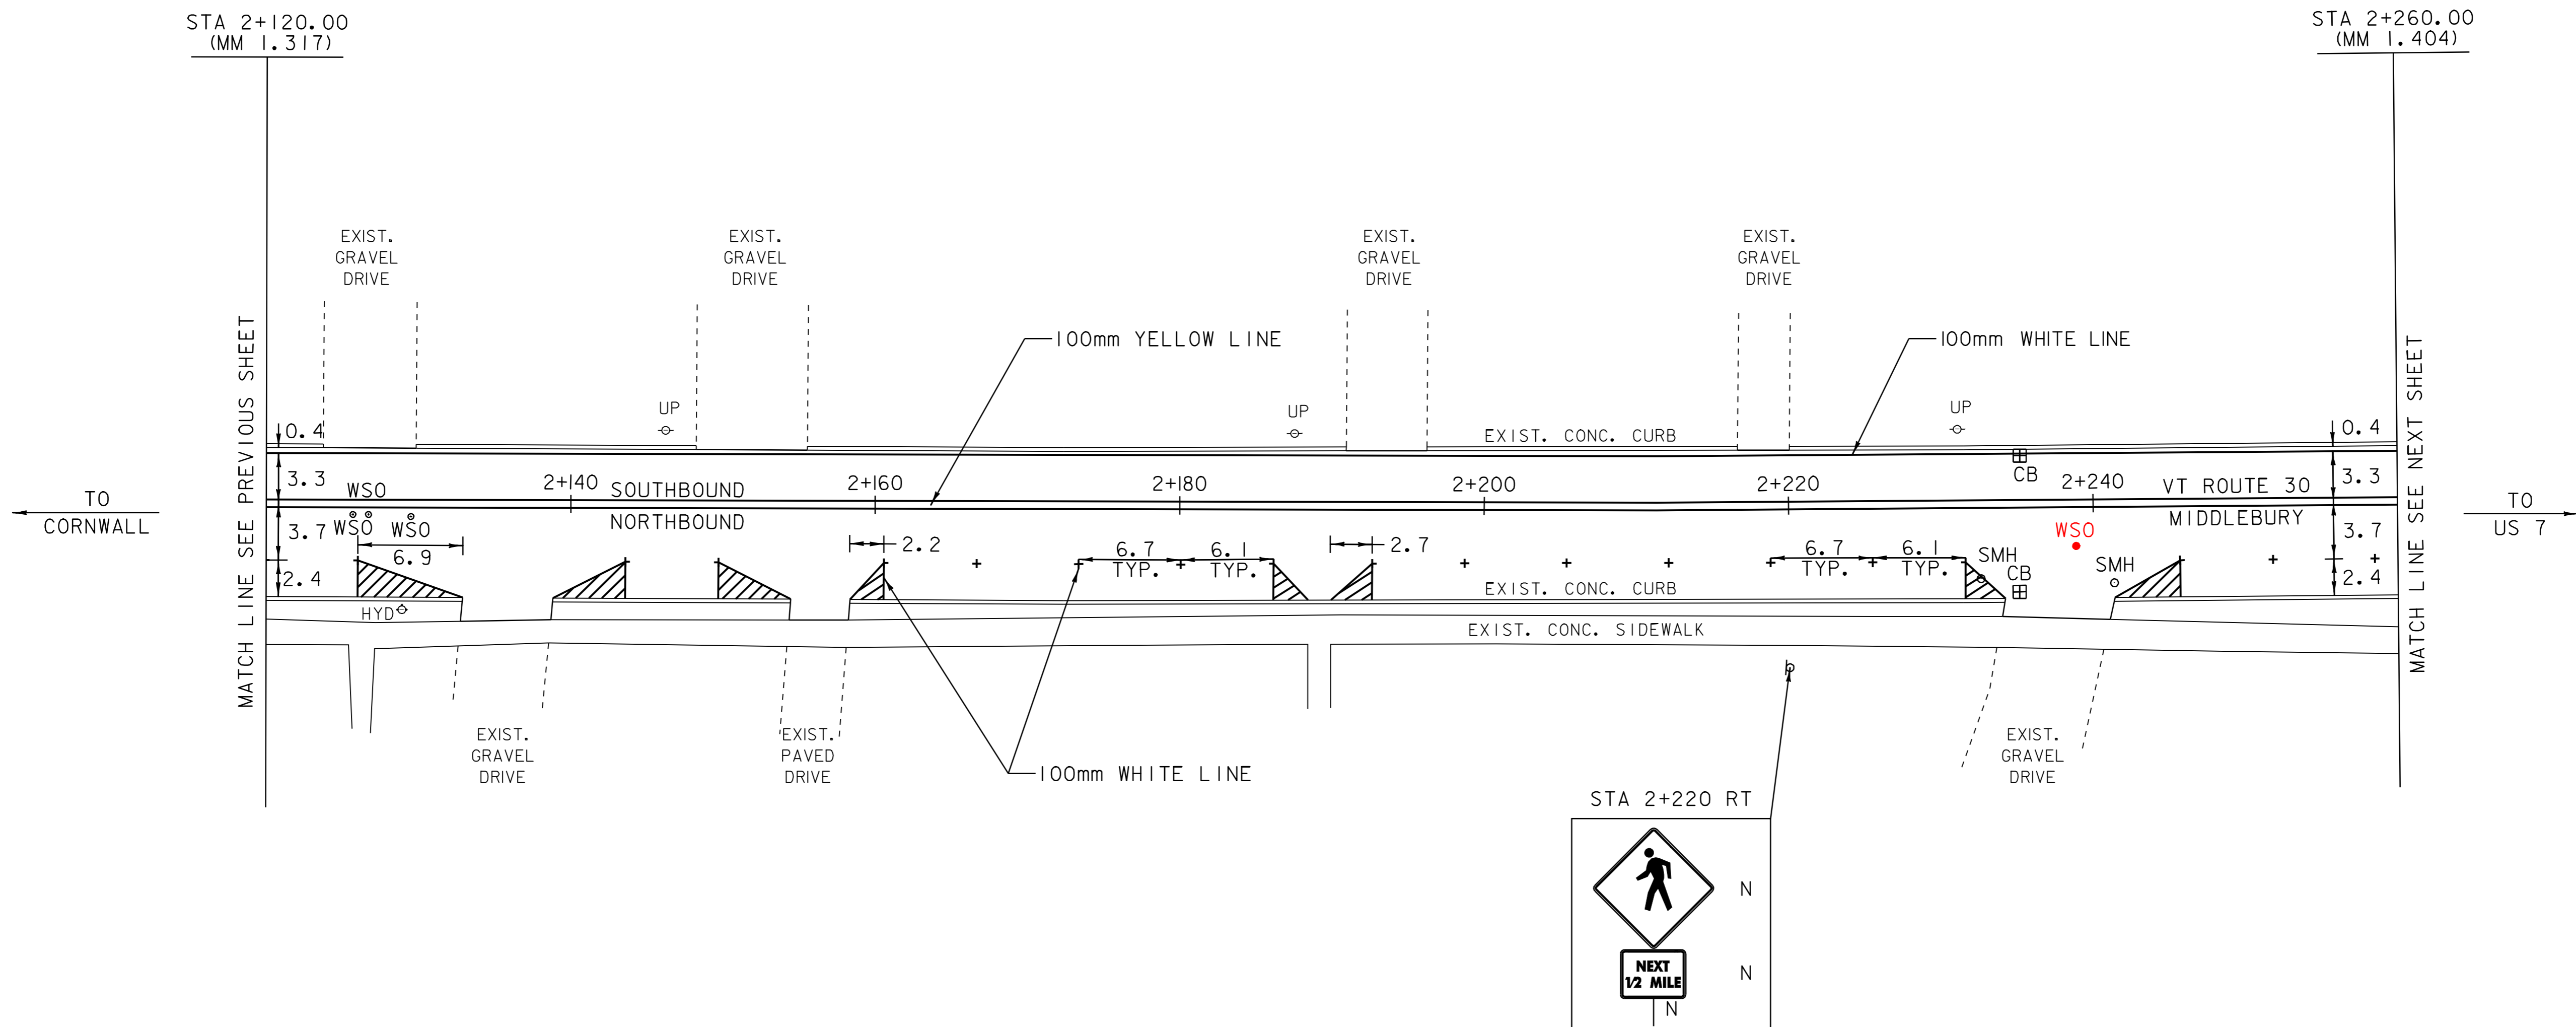

UNLESS OTHERWISE NOTED,
 PARKING SPACES ARE LAID
 OUT AS FOLLOWS: FIRST
 AND LAST ARE 6.1 m LONG
 AND THOSE IN BETWEEN ARE
 6.7 m LONG.

LEGEND

- R = REMOVE EXISTING
- S = SALVAGE
- R&S = REMOVE AND SALVAGE
- N = NEW
- RET = RETAIN
- B-B = BACK TO BACK

PAVING LAYOUT 10

PROJECT NAME:	MIDDLEBURY	FILE NAME:	/pave/01d048/pd048.dgn	PLOT DATE:	06-OCT-2008 13:00
PROJECT NUMBER:	STP 2304(I)S	PROJECT LEADER:	PTS	DRAWN BY:	MRS
		IPARM FILE NAME:	pd048110.1	CHECKED BY:	NLL
				SHEET	28 OF 103

NOT TO SCALE

NOTE: ALL DIMENSIONS IN METERS EXCEPT AS INDICATED