

TEMPORARY 100mm WHITE LINE, PAINT  
 DURABLE 100mm WHITE LINE, THERMOPLASTIC  
 STA 2+790 TO 2+817 SOLID RT PARKING  
 STA 2+790 TO 2+821 SOLID LT PARKING  
 STA 2+818 TO 2+824 SOLID LT NO PARKING  
 STA 2+820 TO 2+824 SOLID RT NO PARKING  
 STA 2+826 TO 2+835 SOLID RT NO PARKING  
 STA 2+835 TO 2+848 SOLID RT PARKING  
 STA 2+838 TO 2+856 SOLID LT PARKING

TEMPORARY 100mm YELLOW LINE, PAINT  
 DURABLE 100mm YELLOW LINE, THERMOPLASTIC  
 STA 2+790 TO 2+824 SOLID LT & RT  
 STA 2+827 TO 2+857 SOLID LT & RT  
 STA 2+860 DOUBLE SOLID RT (SA 5)  
 STA 2+863 DOUBLE SOLID LT (SA 5)  
 STA 2+869 TO 2+889 SOLID LT & RT  
 STA 2+891 TO 2+894 SOLID LT & RT

TEMPORARY LETTER OR SYMBOL, PAINT  
 DURABLE LETTER OR SYMBOL, TYPE 1T/PAE  
 STA 2+819 LT - DISABLED MARKING  
 STA 2+863 RT - "STOP" (SA 5)  
 STA 2+882 RT - "STOP"  
 STA 2+870 TO 2+874 RT - YIELD MARKINGS (5)  
 STA 2+871 TO 2+874 RT - YIELD MARKINGS (4)

TEMPORARY CROSSWALK MARKING, PAINT  
 STA 2+823 TO 2+828 RT TO LT  
 STA 2+859 TO 2+868 LT (SA 5)  
 STA 2+887 TO 2+893 LT TO RT

CHANGING ELEVATION OF DROP INLETS,  
 CATCH BASINS, OR MANHOLES  
 STA 2+797 LT (CB)  
 STA 2+799 RT (CB)  
 STA 2+874 RT (CB) - **REPLACED ENTIRE CB**

ADJUST ELEVATION OF VALVE BOX  
 STA 2+865 LT  
 STA 2+865 LT  
 STA 2+865 LT - **DID NOT TOUCH**

CONSTRUCT SIDEWALK RAMP  
 W/DETECTABLE WARNING  
 SURFACE (YELLOW)  
 STA 2+823 RT (TYPE 3)  
 STA 2+828 LT (TYPE 5)  
 STA 2+887 RT (TYPE 1)  
 STA 2+893 LT (TYPE 4)











CAST-IN-PLACE CONCRETE CURB, TYPE B  
 STA 2+837 TO 2+858 LT  
 STA 2+850 TO 2+871 RT  
 STA 2+869 TO 2+898 LT  
 STA 2+874 TO 2+894 RT

REMOVING SIGNS  
 AS SHOWN - 21  
 ERECTING SALVAGED SIGNS  
 AS SHOWN - 2

TEMPORARY 150mm WHITE LINE, PAINT  
 DURABLE 150mm WHITE LINE, THERMOPLASTIC  
 STA 2+838 TO 2+856 TARGETS LT PARKING

TEMPORARY 600mm STOP BAR, PAINT  
 DURABLE 600mm STOP BAR, TYPE 1T/PAE  
 STA 2+859 TO 2+864 LT (SA 5)  
 STA 2+885 RT

**VT ROUTE 30  
 STA 2+896.82  
 (MM 1.800)  
 END PROJECT  
 STP 2304(I)S**

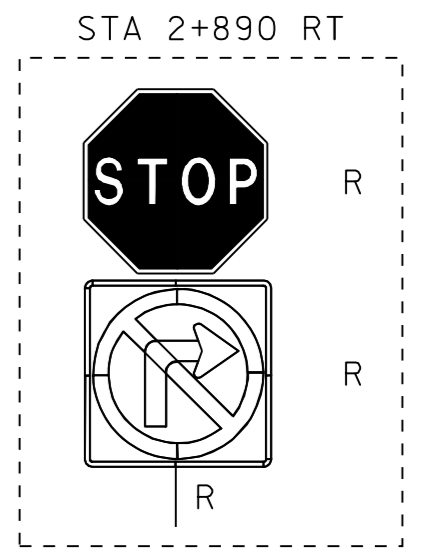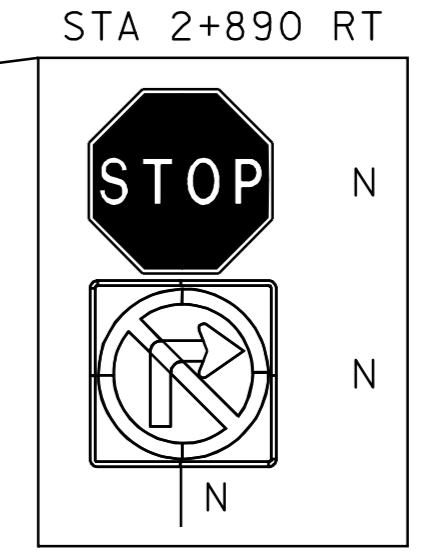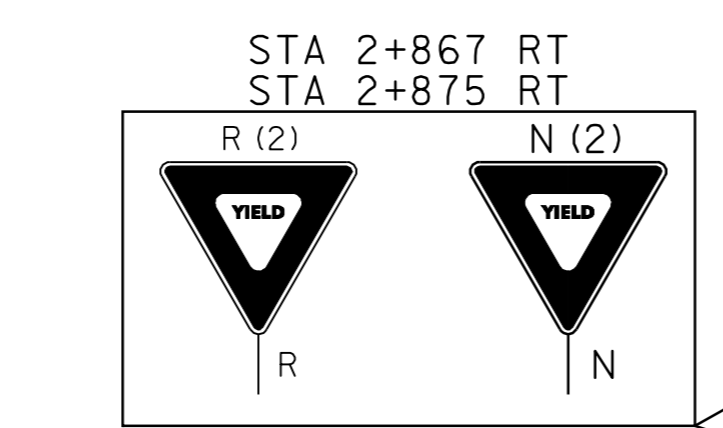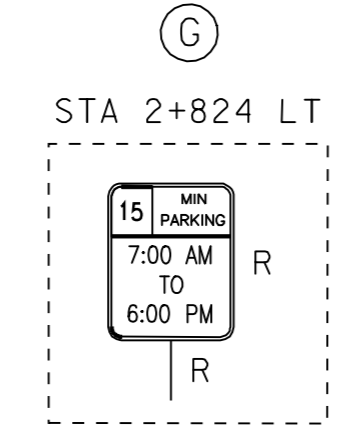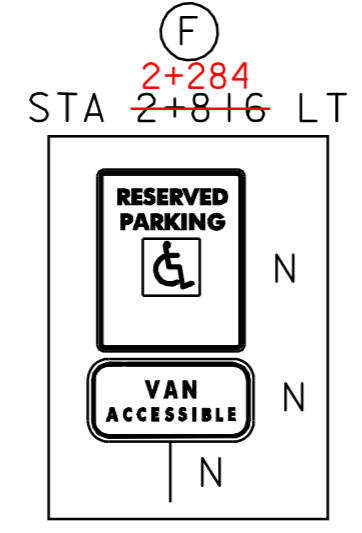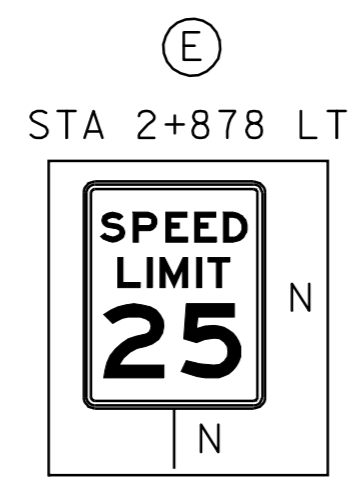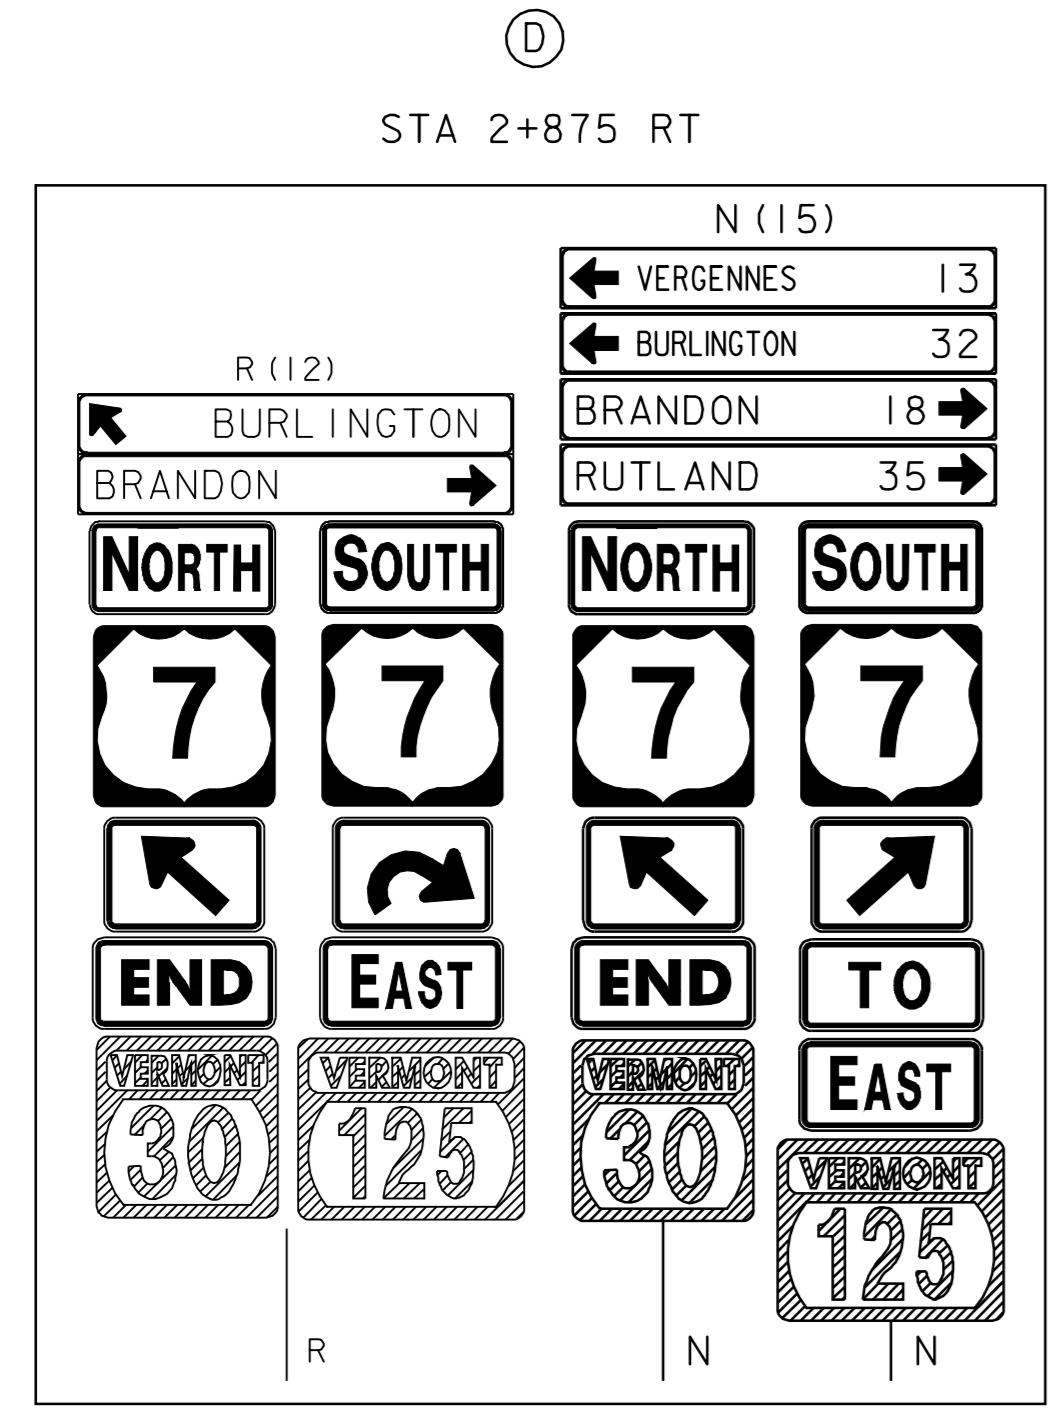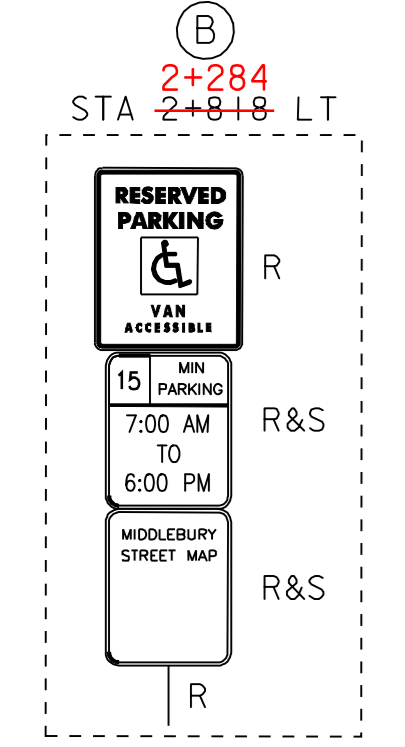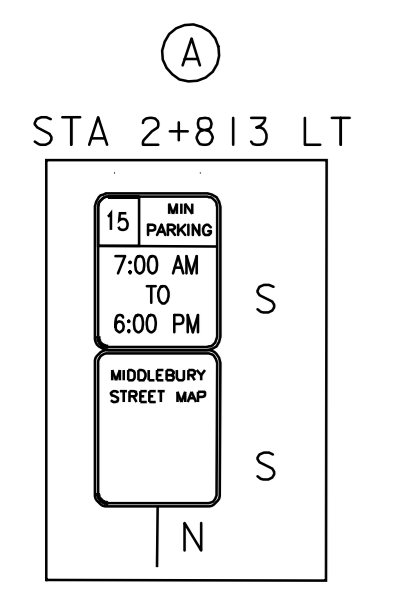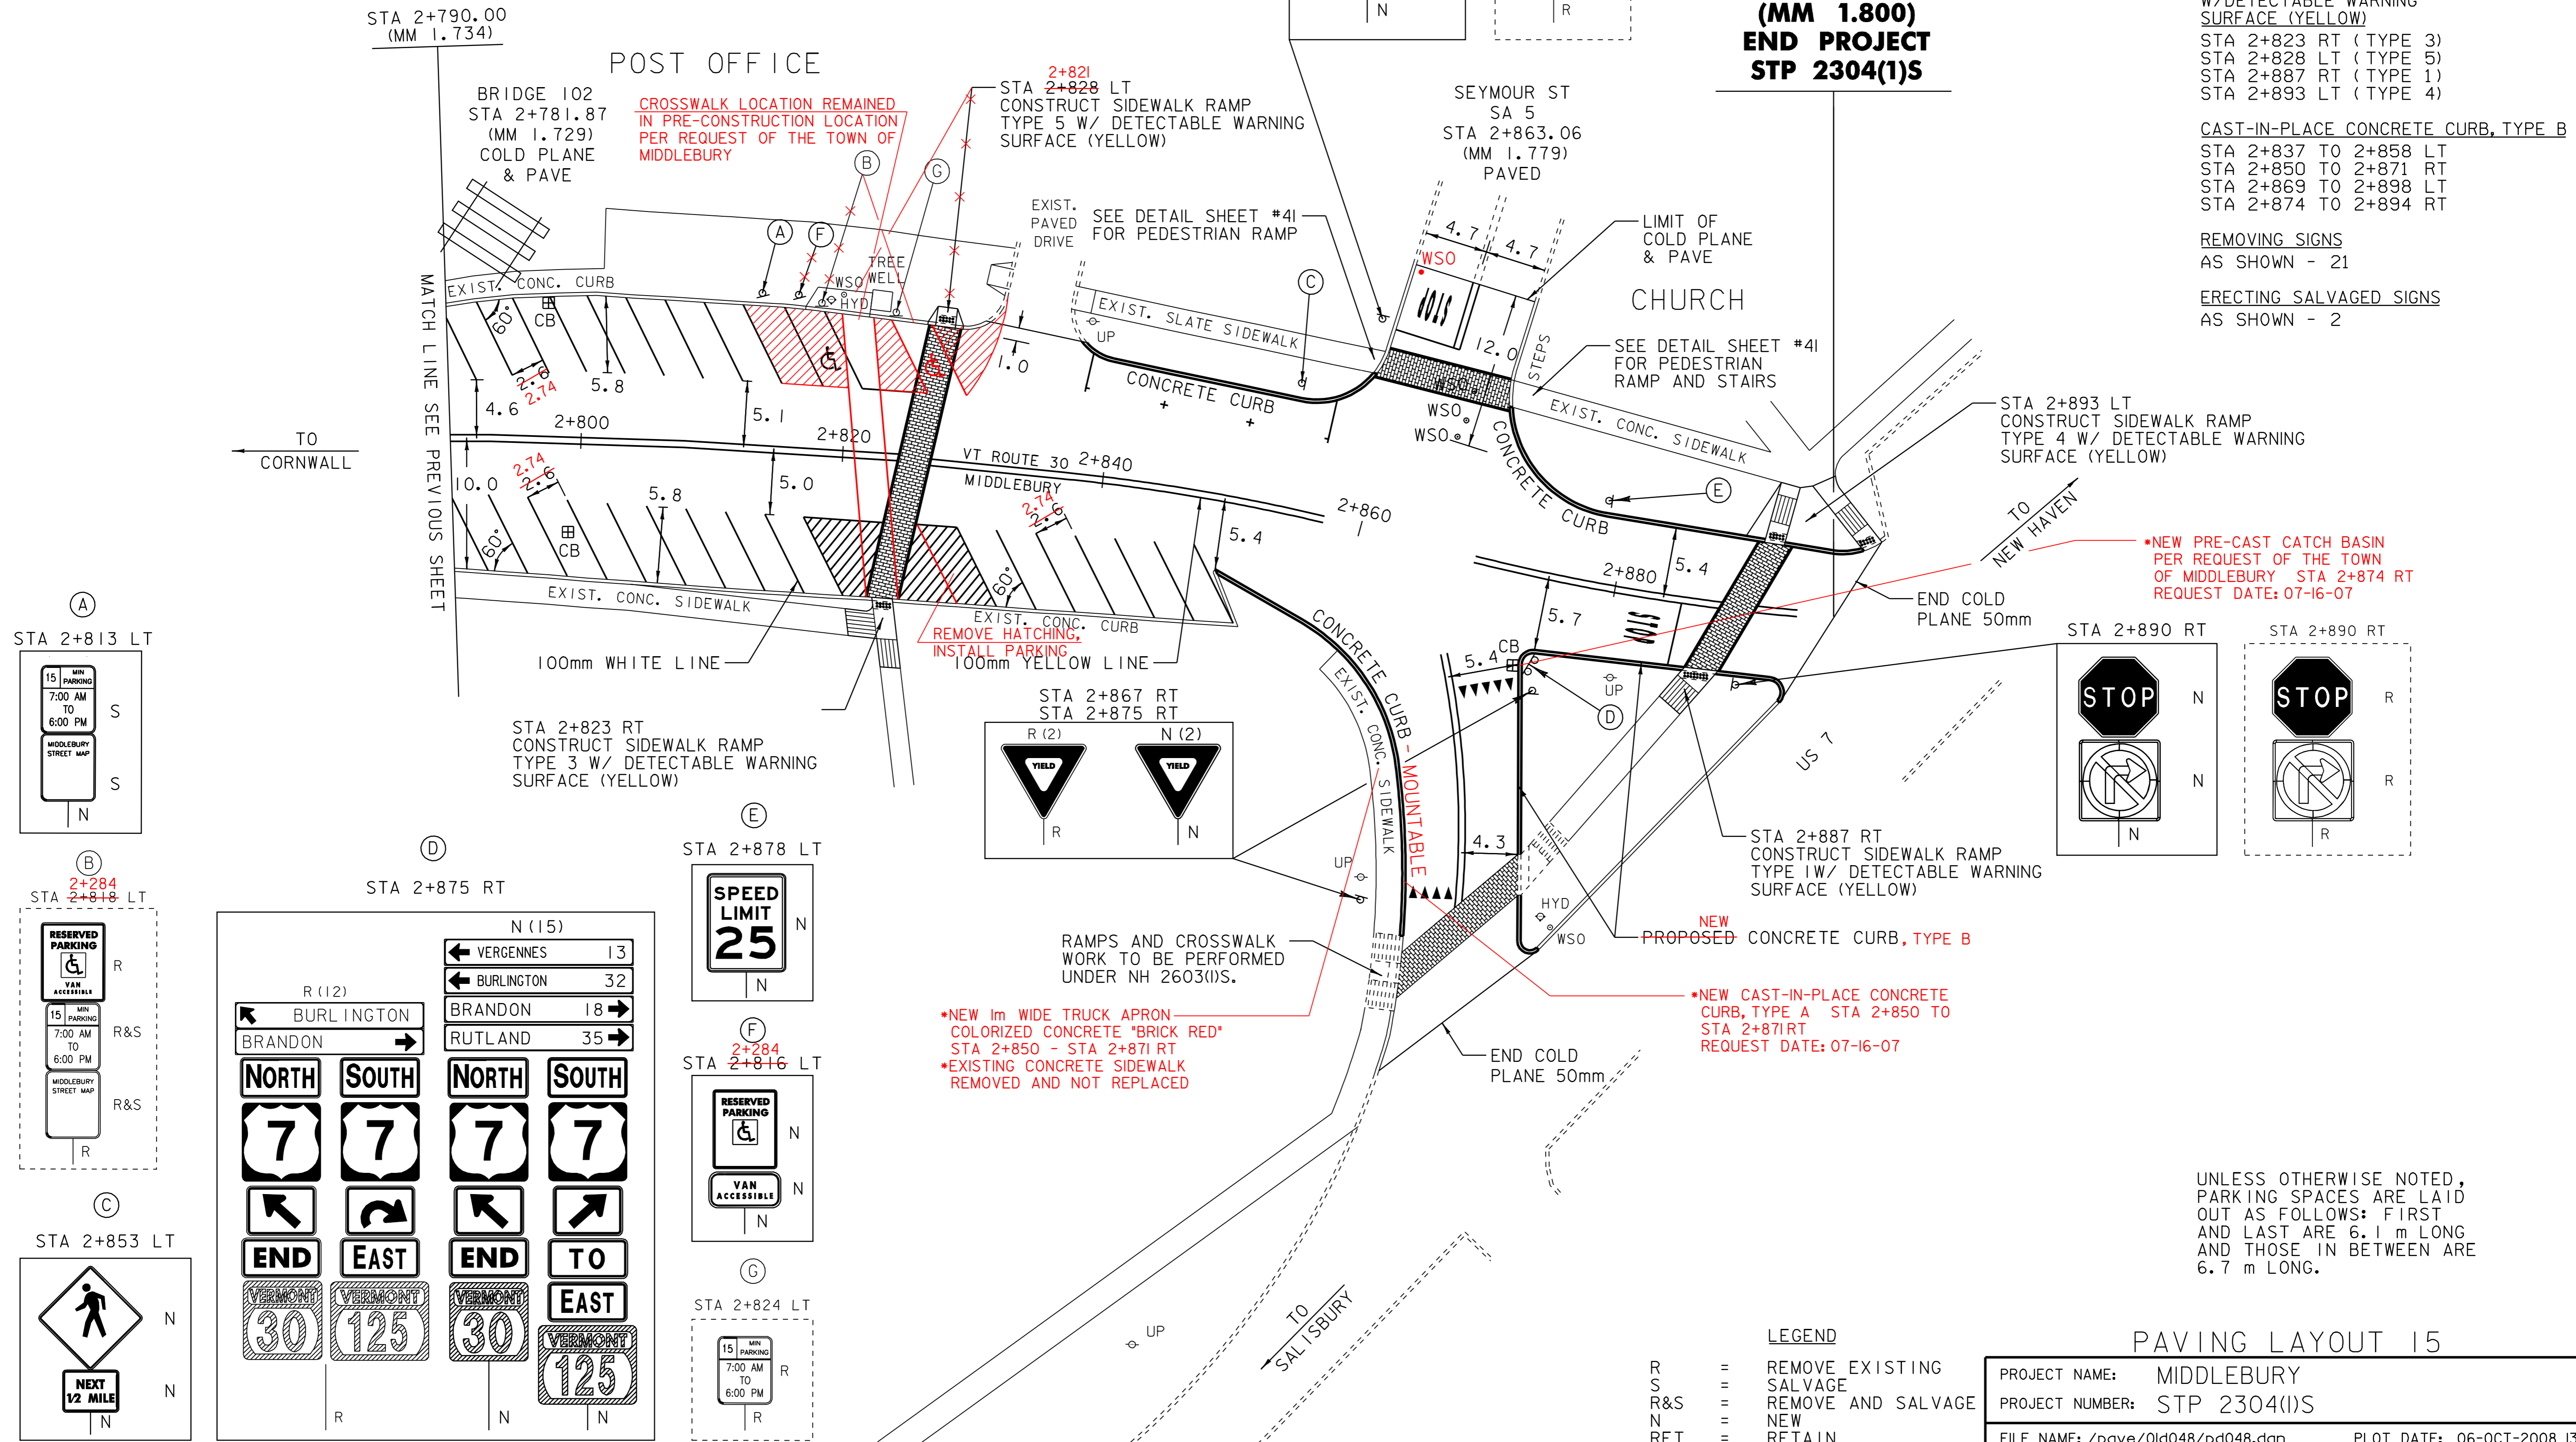

LEGEND

R	=	REMOVE EXISTING
S	=	SALVAGE
R&S	=	REMOVE AND SALVAGE
N	=	NEW
RET	=	RETAIN
B-B	=	BACK TO BACK

UNLESS OTHERWISE NOTED,  
 PARKING SPACES ARE LAID  
 OUT AS FOLLOWS: FIRST  
 AND LAST ARE 6.1 m LONG  
 AND THOSE IN BETWEEN ARE  
 6.7 m LONG.

PAVING LAYOUT 15

PROJECT NAME:	MIDDLEBURY	FILE NAME:	/pave/0ld048/pd048.dgn	PLOT DATE:	06-OCT-2008 13:00
PROJECT NUMBER:	STP 2304(I)S	PROJECT LEADER:	PTS	DRAWN BY:	MRS
		IPARM FILE NAME:	pd048I15.1	CHECKED BY:	NLL
				SHEET	33 OF 103

NOT TO SCALE

NOTE: ALL DIMENSIONS IN METERS EXCEPT AS INDICATED