

TEMPORARY 100mm WHITE LINE, PAINT
 DURABLE 100mm WHITE LINE, THERMOPLASTIC
 STA 0+538 TO 0+641 SOLID LT & RT

TEMPORARY 100mm YELLOW LINE, PAINT
 DURABLE 100mm YELLOW LINE, THERMOPLASTIC
 STA 0+538 TO 0+670 SOLID LT & RT


CAST-IN-PLACE CONCRETE CURB, TYPE B
 STA 0+589 TO 0+611 RT
 STA 0+616 TO 0+641 LT
 STA 0+617 TO 0+641 RT
 STA 0+602 TO 0+610 LT



CHANGING ELEVATION OF SEWER MANHOLE
 STA. 0+558 RT
 STA 0+604 RT

**VT ROUTE 125
 STA 0+537.52
 (MM 0.334)
 BEGIN PROJECT
 STP 2304(1)S**

STA 0+670.00
 (MM 0.416)

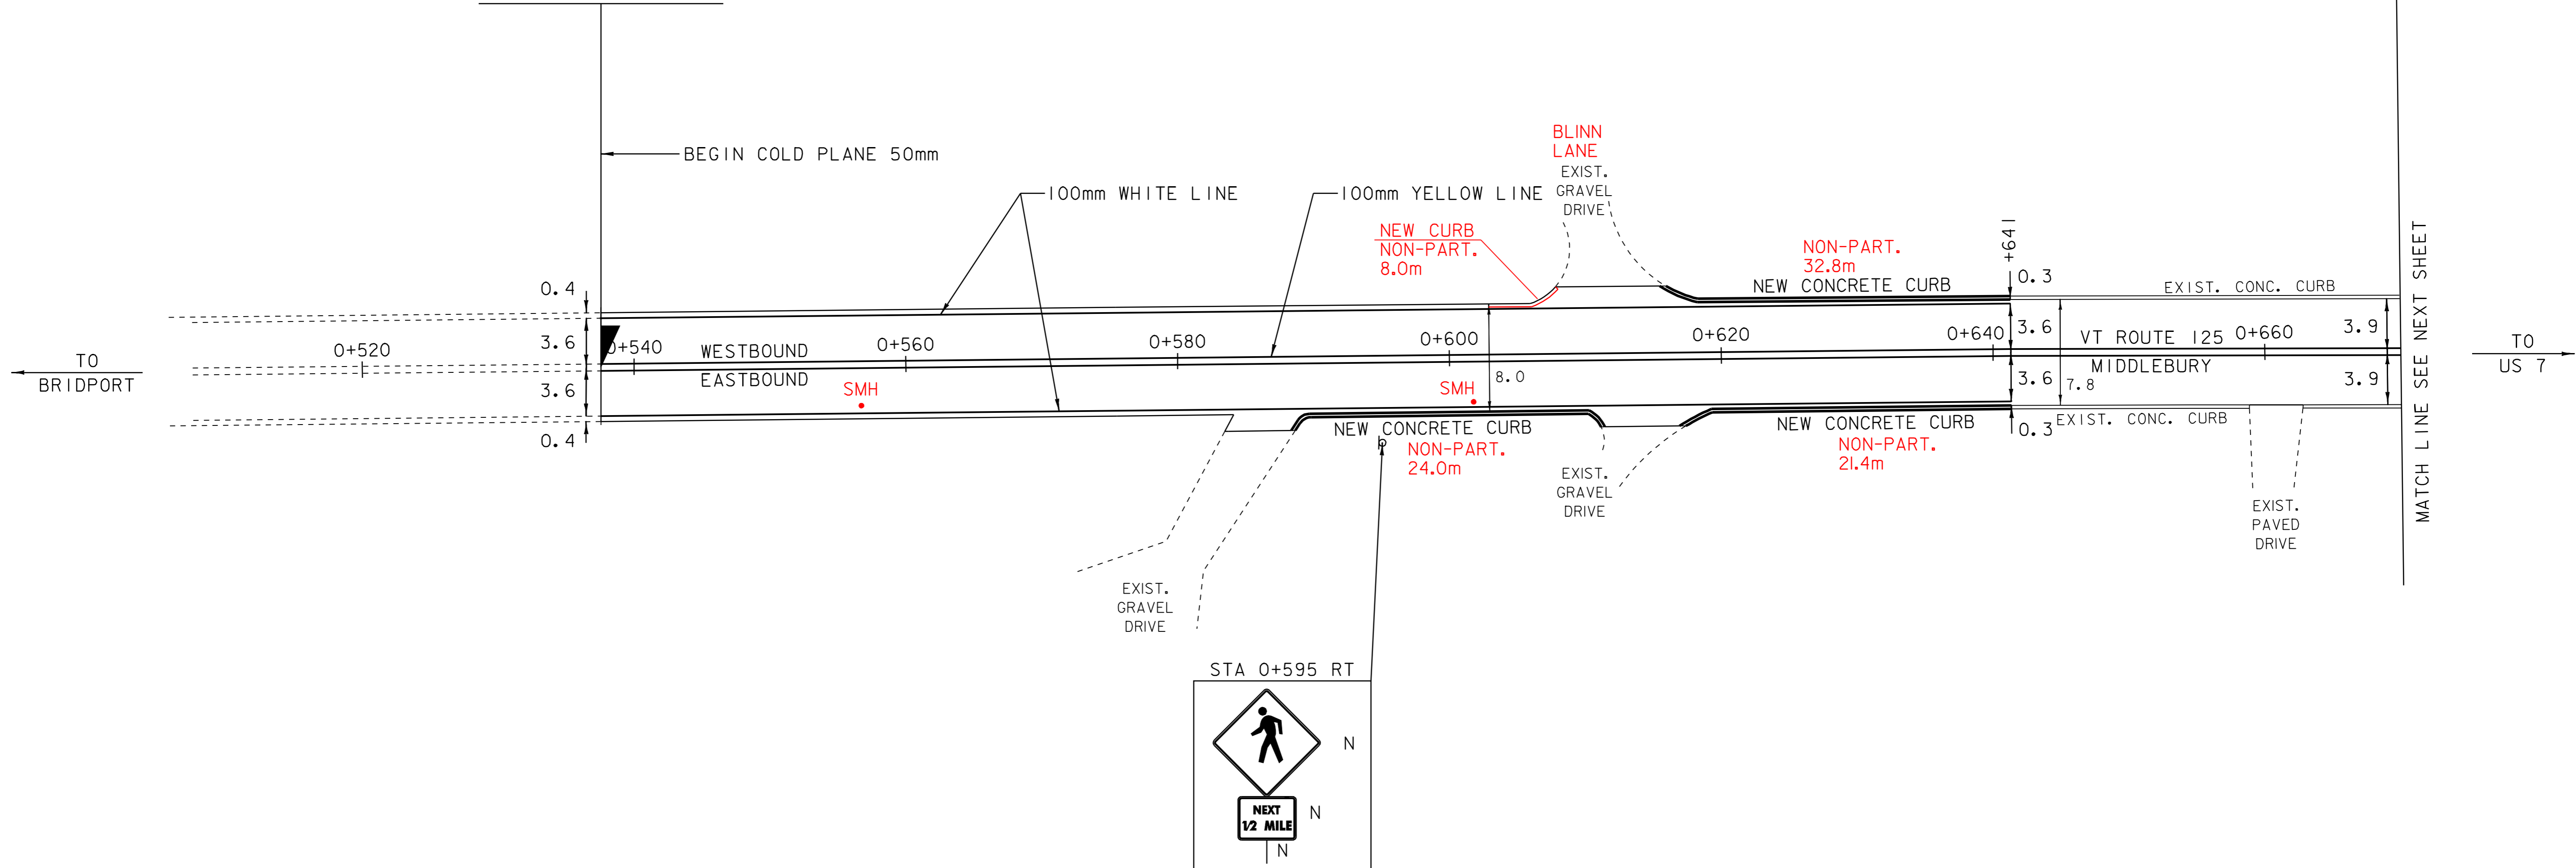

LEGEND

- R = REMOVE EXISTING
- S = SALVAGE
- R&S = REMOVE AND SALVAGE
- N = NEW
- RET = RETAIN
- B-B = BACK TO BACK

PAVING LAYOUT 16

PROJECT NAME: MIDDLEBURY	FILE NAME: /pave/01d048/pd048.dgn	PLOT DATE: 06-OCT-2008 13:00
PROJECT NUMBER: STP 2304(1)S	PROJECT LEADER: PTS	DRAWN BY: MRS
	IPARM FILE NAME: pd048116.i	CHECKED BY: NULL
		SHEET 34 OF 103

NOT TO SCALE

NOTE: ALL DIMENSIONS IN METERS EXCEPT AS INDICATED