

TEMPORARY 150mm WHITE LINE, PAINT
 DURABLE 150mm WHITE LINE, THERMOPLASTIC
 STA 0+704 TO 0+746 TARGETS RT PARKING
 STA 0+704 TO 0+746 TARGETS LT PARKING

TEMPORARY 100mm YELLOW LINE, PAINT
 DURABLE 100mm YELLOW LINE, THERMOPLASTIC
 STA 0+670 TO 0+680 SOLID LT & RT
 STA 0+686 DOUBLE SOLID RT (TH 59)
 STA 0+692 TO 0+693 SOLID LT & RT
 STA 0+696 TO 0+757 SOLID LT & RT
 STA 0+759 TO 0+764 SOLID LT & RT
 STA 0+770 DOUBLE SOLID RT (TH 58)
 STA 0+776 TO 0+810 SOLID LT & RT

TEMPORARY 600mm STOP BAR, PAINT
 DURABLE 600mm STOP BAR, TYPE 1 TAPE
 STA 0+687 TO 0+691 RT (TH 59)
 STA 0+769 TO 0+773 RT (TH 58)

TEMPORARY LETTER OR SYMBOL, PAINT
 DURABLE LETTER OR SYMBOL, TYPE 1 TAPE
 STA 0+770 RT - "STOP" (TH 58)

TEMPORARY CROSSWALK MARKING, PAINT
 STA 0+695 LT TO RT
 STA 0+758 LT TO RT
 STA 0+766 TO 0+774 RT (TH 58)


SPECIAL PROVISION (DURABLE
 CROSSWALK MARKING, IMPRINTED/COLORIZED)
 STA 0+695 LT TO RT
 STA 0+758 LT TO RT
 STA 0+766 TO 0+774 RT (TH 58)

CONSTRUCT SIDEWALK RAMP W/DETECTABLE
 WARNING SURFACE (YELLOW)
 STA 0+695 LT (TYPE 1)
 STA 0+695 RT (TYPE 1)
 STA 0+758 LT (TYPE 1)
 STA 0+758 RT (TYPE 1)
 STA 0+766 RT (TYPE 6) (TH 58)
 STA 0+774 RT (TYPE 1) (TH 58)





CHANGING ELEVATION OF DROP INLETS,
 CATCH BASINS, OR MANHOLES
 STA 0+701 LT (CB)
 STA 0+701 RT (CB)
 STA 0+773 RT (DI) (TH 58)

REMOVING SIGNS
 AS SHOWN - 3

ERECTING SALVAGED SIGNS
 AS SHOWN - 1

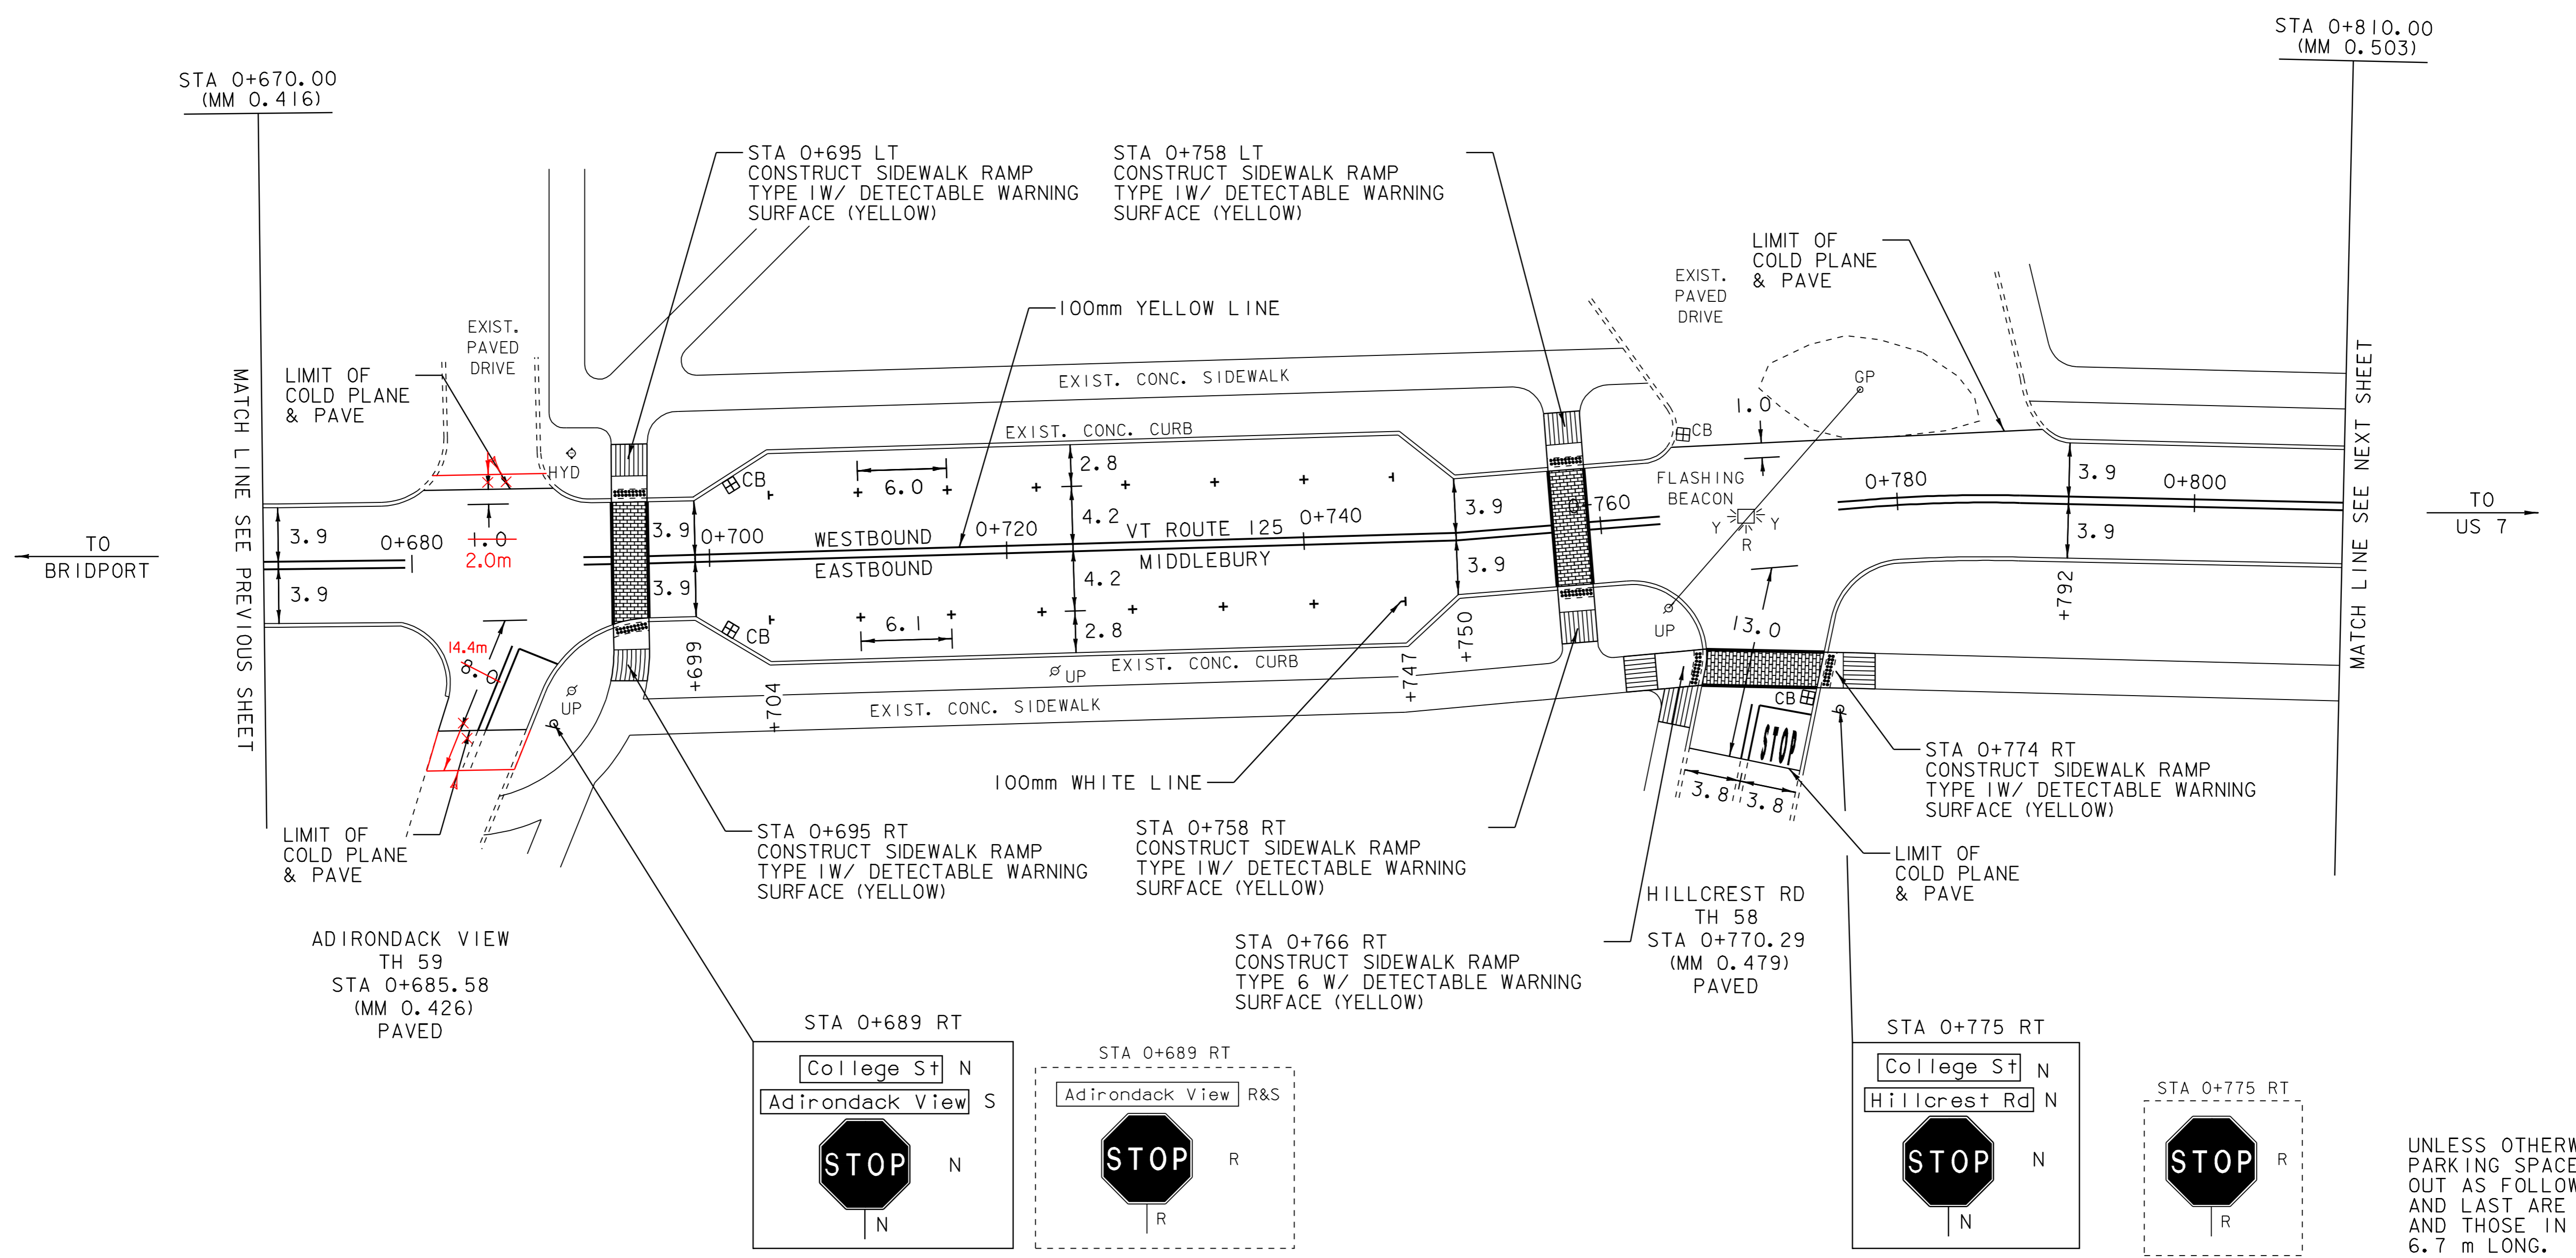

ADIRONDACK VIEW
 TH 59
 STA 0+685.58
 (MM 0.426)
 PAVED

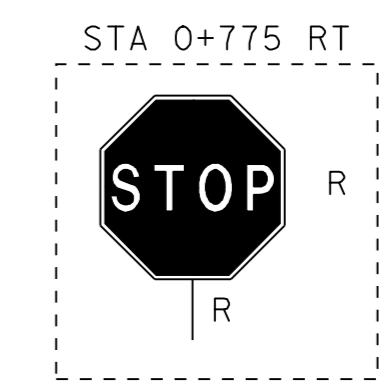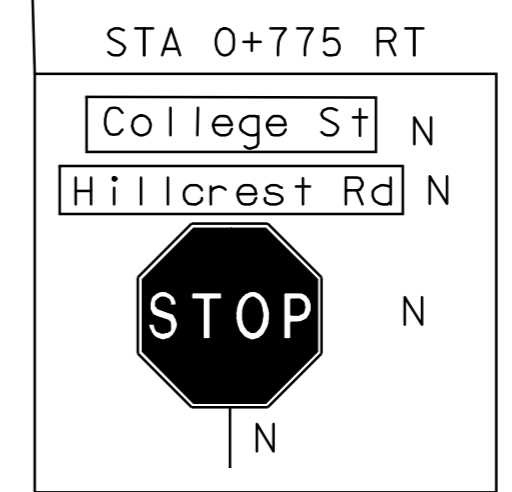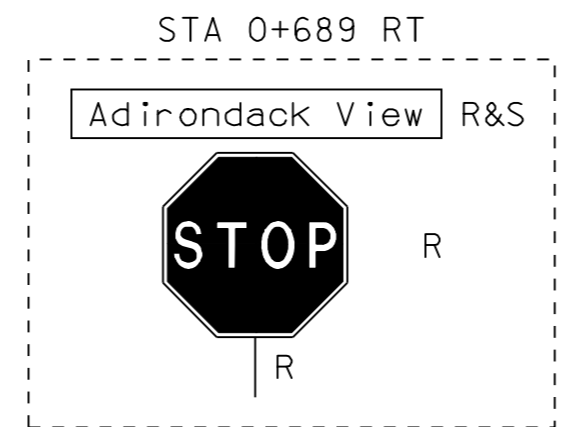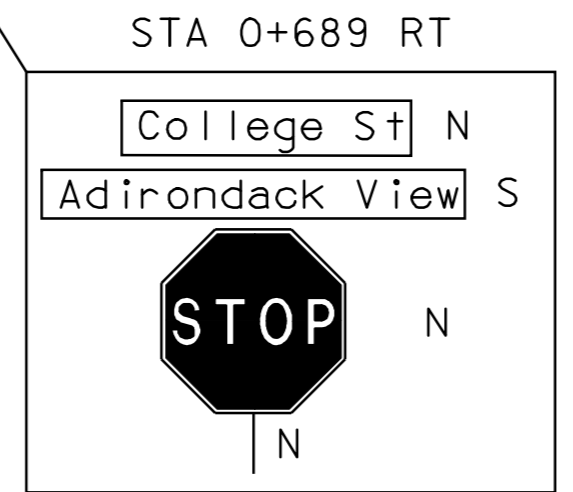

- LEGEND
- R = REMOVE EXISTING
 - S = SALVAGE
 - R&S = REMOVE AND SALVAGE
 - N = NEW
 - RET = RETAIN
 - B-B = BACK TO BACK

UNLESS OTHERWISE NOTED,
 PARKING SPACES ARE LAID
 OUT AS FOLLOWS: FIRST
 AND LAST ARE 6.1 m LONG
 AND THOSE IN BETWEEN ARE
 6.7 m LONG.

NOT TO SCALE

NOTE: ALL DIMENSIONS IN METERS EXCEPT AS INDICATED

PAVING LAYOUT 17

PROJECT NAME: MIDDLEBURY
 PROJECT NUMBER: STP 2304(I)S

FILE NAME: /pave/0ld048/pd048.dgn
 PROJECT LEADER: PTS
 IPARM FILE NAME: pd048I17.1

PLOT DATE: 06-OCT-2008 13:00
 DRAWN BY: MRS
 CHECKED BY: NLL
 SHEET 35 OF 103