

TEMPORARY 150mm WHITE LINE, PAINT  
 DURABLE 150mm WHITE LINE, THERMOPLASTIC  
 STA 0+869 TO 0+874 TARGETS LT PARKING  
 STA 0+870 TO 0+889 TARGETS RT PARKING  
 STA 0+915 TO 0+946 TARGETS RT PARKING  
 STA 0+921 TO 0+950 TARGETS LT PARKING  
 STA 0+964 TO 0+970 TARGETS RT PARKING

TEMPORARY 100mm YELLOW LINE, PAINT  
 DURABLE 100mm YELLOW LINE, THERMOPLASTIC  
 STA 0+810 TO 0+814 SOLID LT & RT  
 STA 0+837 TO 0+858 SOLID LT & RT  
 STA 0+865 TO 0+903 SOLID LT & RT  
 STA 0+912 TO 0+954 SOLID LT & RT  
 STA 0+961 TO 0+970 SOLID LT & RT


TEMPORARY LETTER OR SYMBOL, PAINT  
 DURABLE LETTER OR SYMBOL, TYPE 1 TAPE  
 STA 0+924 LT - DISABLED MARKING

TEMPORARY CROSSWALK MARKING, PAINT  
 STA 0+814 TO 0+837 LT TO RT  
 STA 0+858 TO 0+865 LT TO RT  
 STA 0+903 TO 0+912 LT TO RT  
 STA 0+954 TO 0+961 LT TO RT

SPECIAL PROVISION (DURABLE  
 CROSSWALK MARKING, IMPRINTED/COLORIZED)  
 STA 0+814 TO 0+837 LT TO RT  
 STA 0+858 TO 0+865 LT TO RT  
 STA 0+903 TO 0+912 LT TO RT  
 STA 0+954 TO 0+961 LT TO RT

CONSTRUCT SIDEWALK RAMP W/DETECTABLE  
 WARNING SURFACE (YELLOW)  
 STA 0+814 TO 0+837 LT (TYPE 2)  
 STA 0+820 RT (TYPE 6)  
 STA 0+835 RT (TYPE 6)  
 STA 0+858 TO 0+865 LT (TYPE 2)  
 STA 0+858 TO 0+865 RT (TYPE 2)  
 STA 0+903 TO 0+912 LT (TYPE 2)  
 STA 0+903 TO 0+912 RT (TYPE 2)  
 STA 0+922 LT (TYPE 6)  
 STA 0+954 TO 0+961 LT (TYPE 2)  
 STA 0+954 TO 0+961 RT (TYPE 2)

CHANGING ELEVATION OF DROP INLETS,  
 CATCH BASINS, OR MANHOLES  
 STA 0+822 RT (CB) STA 0+883 LT  
 STA 0+830 RT (CB)  
 STA 0+879 LT (CB)  
 STA 0+945 RT (CB)  
 STA 0+949 LT (CB)  
 STA 0+889 RT (CB)  
 CHANGING ELEVATION OF SEWER MANHOLES  
 STA 0+822 RT  
 STA 0+950 LT  
 STA 0+885 LT  
 REMOVING SIGNS  
 AS SHOWN - 1

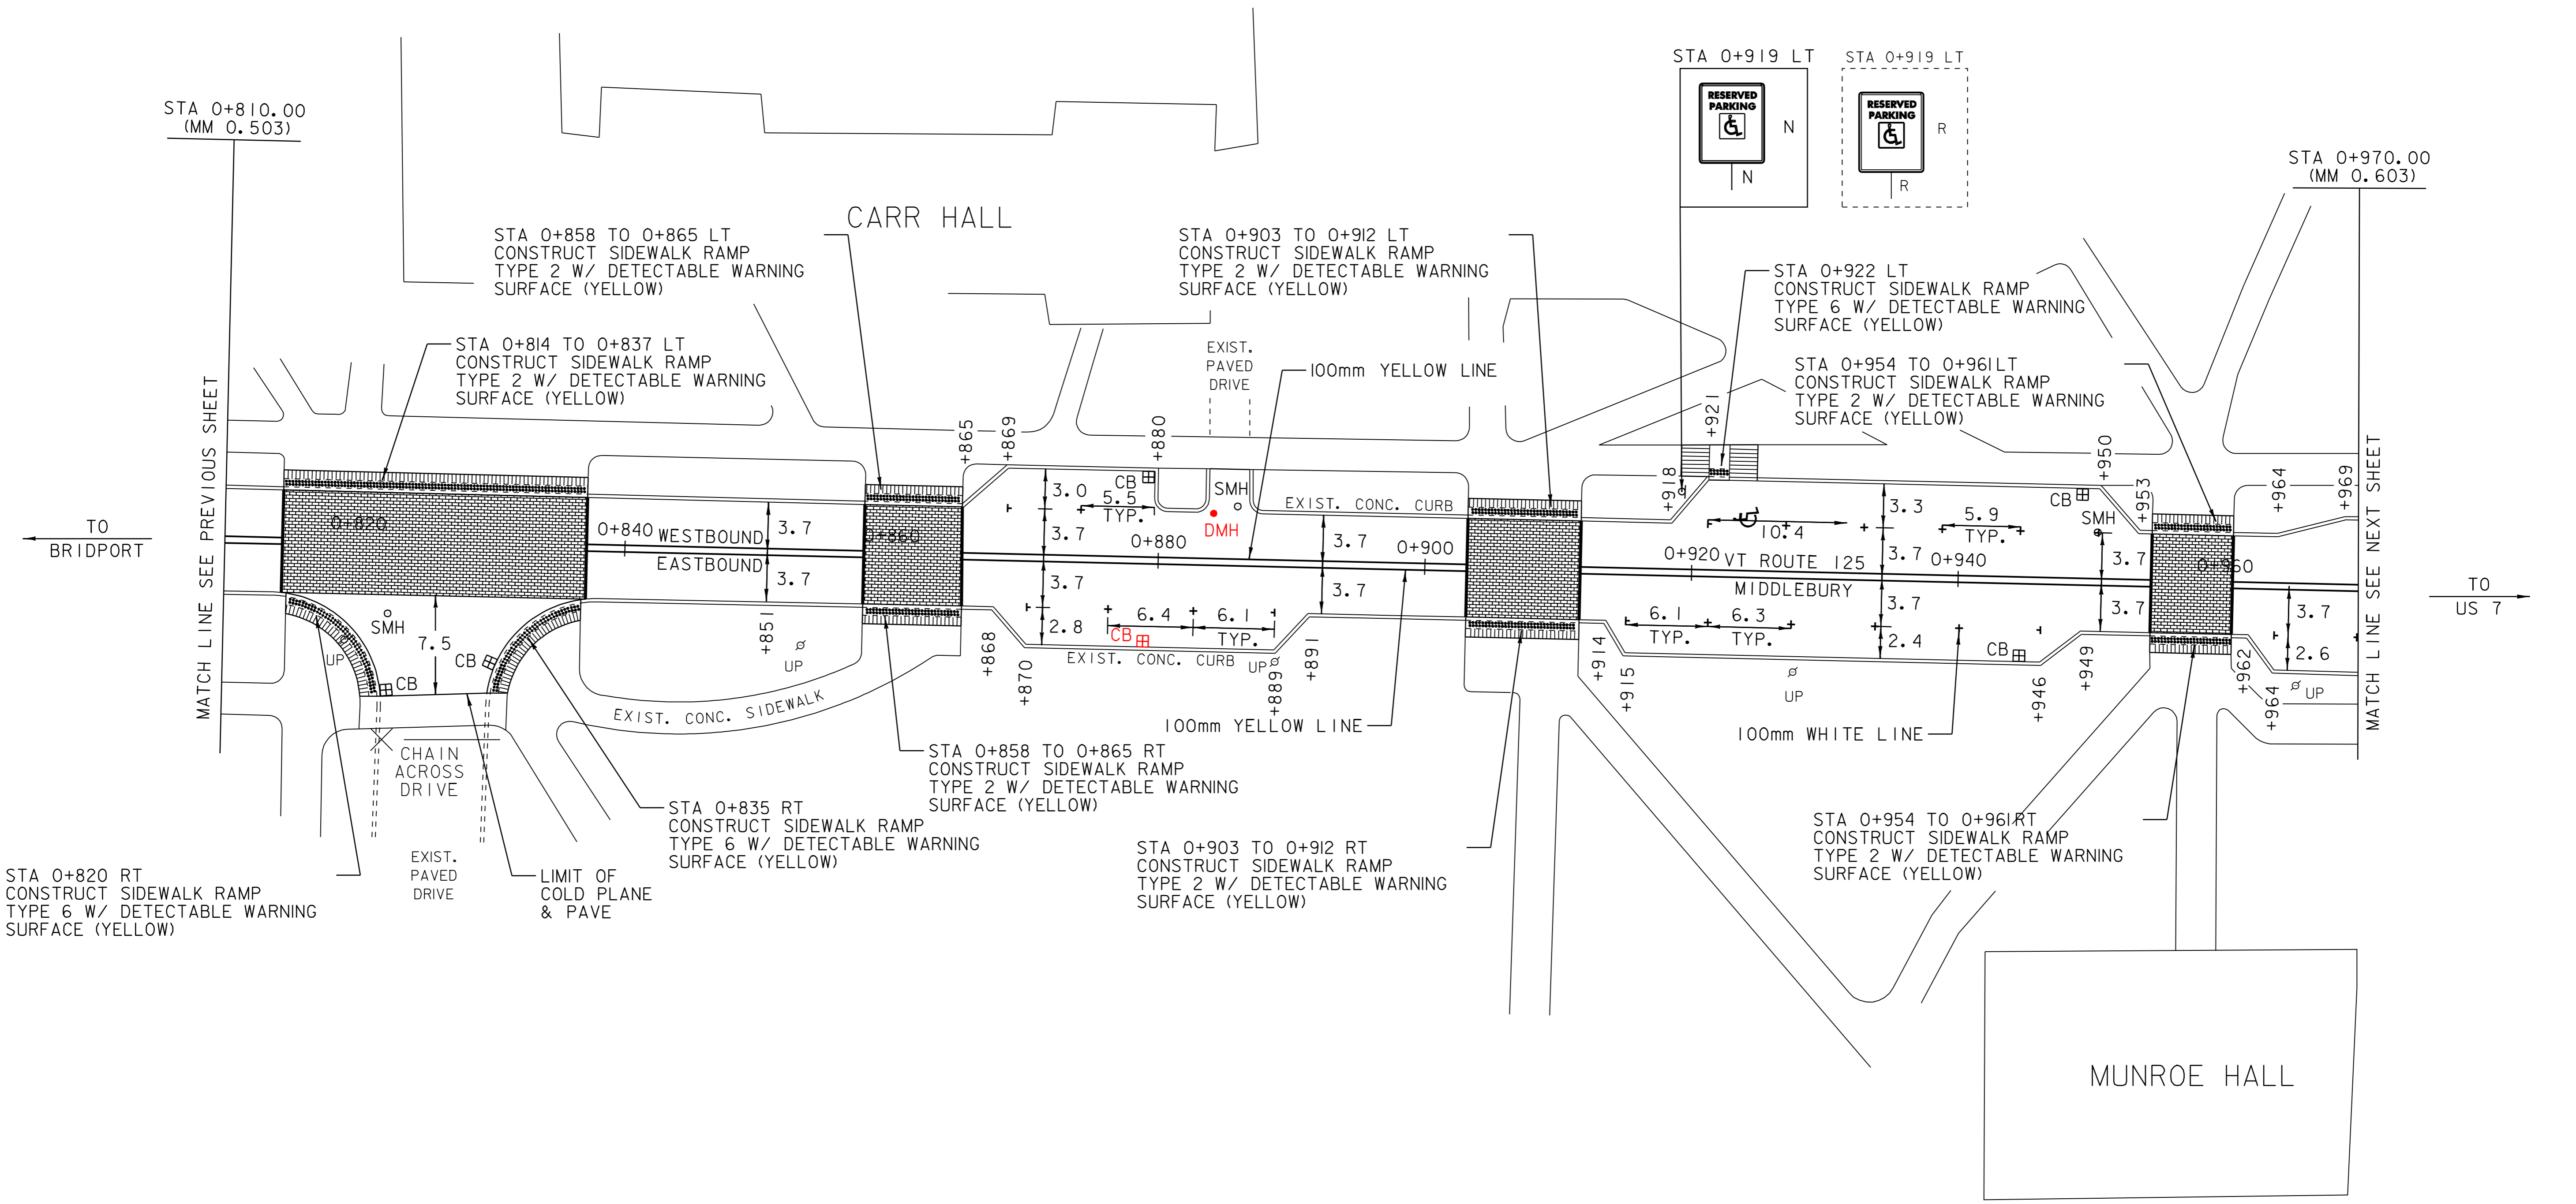

STA 0+820 RT  
 CONSTRUCT SIDEWALK RAMP  
 TYPE 6 W/ DETECTABLE WARNING  
 SURFACE (YELLOW)

UNLESS OTHERWISE NOTED,  
 PARKING SPACES ARE LAID  
 OUT AS FOLLOWS: FIRST  
 AND LAST ARE 6.1 m LONG  
 AND THOSE IN BETWEEN ARE  
 6.7 m LONG.

LEGEND

R	=	REMOVE EXISTING
S	=	SALVAGE
R&S	=	REMOVE AND SALVAGE
N	=	NEW
RET	=	RETAIN
B-B	=	BACK TO BACK

PAVING LAYOUT 18

PROJECT NAME:	MIDDLEBURY
PROJECT NUMBER:	STP 2304(I)S
FILE NAME:	/pave/0ld048/pd048.dgn
PROJECT LEADER:	PTS
IPARM FILE NAME:	pd048I18.1
PLOT DATE:	06-OCT-2008 13:00
DRAWN BY:	MRS
CHECKED BY:	NLL
SHEET	36 OF 103

NOT TO SCALE

NOTE: ALL DIMENSIONS IN METERS EXCEPT AS INDICATED