

TEMPORARY 100mm WHITE LINE, PAINT  
 DURABLE 100mm WHITE LINE, THERMOPLASTIC  
 STA 1+001 TO 1+004 SOLID RT NO PARKING

TEMPORARY 150mm WHITE LINE, PAINT  
 DURABLE 150mm WHITE LINE, THERMOPLASTIC  
 STA 0+970 TO 1+044 TARGETS RT PARKING  
 STA 1+064 TO 1+082 TARGETS RT PARKING  
 STA 1+117 TO 1+130 TARGETS RT PARKING

TEMPORARY 100mm YELLOW LINE, PAINT  
 DURABLE 100mm YELLOW LINE, THERMOPLASTIC  
 STA 0+970 TO 1+053 SOLID LT & RT  
 STA 1+059 TO 1+106 SOLID LT & RT  
 STA 1+112 TO 1+130 SOLID LT & RT

TEMPORARY CROSSWALK MARKING, PAINT  
 STA 1+053 TO 1+059 LT TO RT  
 STA 1+106 TO 1+112 LT TO RT


SPECIAL PROVISION (DURABLE  
 CROSSWALK MARKING, IMPRINTED/COLORIZED)  
 STA 1+053 TO 1+059 LT TO RT  
 STA 1+106 TO 1+112 LT TO RT

CONSTRUCT SIDEWALK RAMP W/DETECTABLE  
 WARNING SURFACE (YELLOW)  
 STA 1+053 TO 1+059 LT (TYPE 2)  
 STA 1+053 TO 1+059 RT (TYPE 2)  
 STA 1+106 TO 1+112 LT (TYPE 2)  
 STA 1+106 TO 1+112 RT (TYPE 2)

CHANGING ELEVATION OF DROP INLETS,  
 CATCH BASINS, OR MANHOLES  
 STA 1+027 RT (CB)  
 STA 1+030 LT (CB)  
 STA 1+080 RT (CB)  
 STA 1+090 LT (CB)

CHANGING ELEVATION OF SEWER MANHOLES  
 STA 0+995 LT  
 STA 1+038 LT

REHAB OF CATCH BASIN  
 STA 1+030 LT (CB)

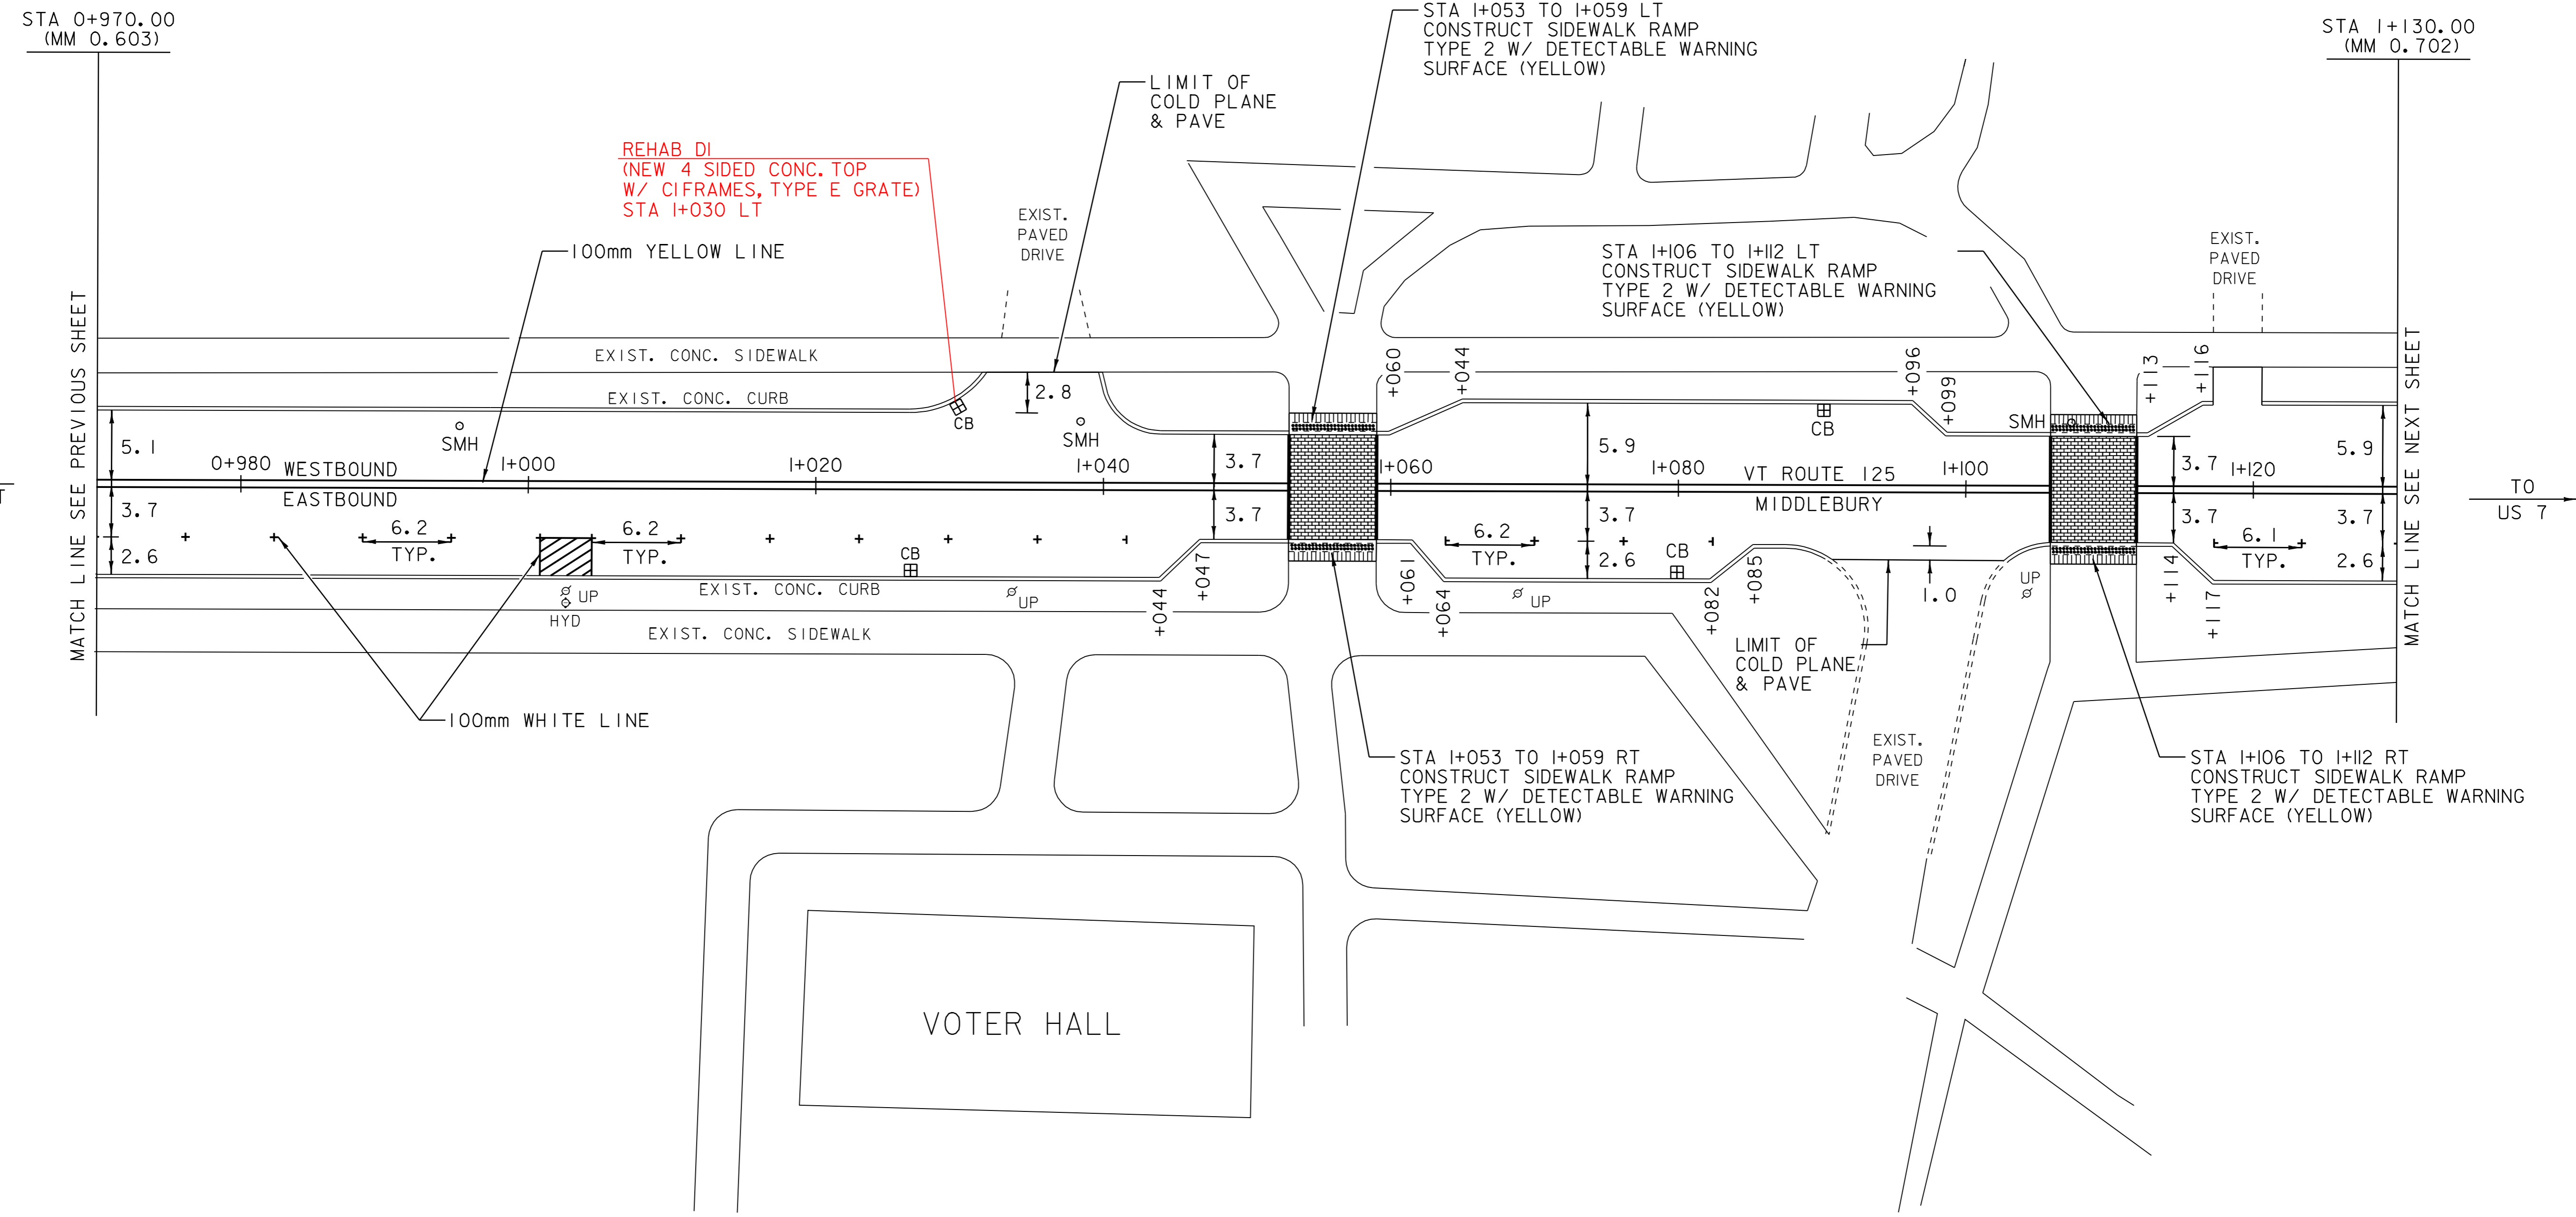

UNLESS OTHERWISE NOTED,  
 PARKING SPACES ARE LAID  
 OUT AS FOLLOWS: FIRST  
 AND LAST ARE 6.1 m LONG  
 AND THOSE IN BETWEEN ARE  
 6.7 m LONG.

LEGEND

R	=	REMOVE EXISTING
S	=	SALVAGE
R&S	=	REMOVE AND SALVAGE
N	=	NEW
RET	=	RETAIN
B-B	=	BACK TO BACK

PAVING LAYOUT 19

PROJECT NAME:	MIDDLEBURY	PLOT DATE:	06-OCT-2008 13:00
PROJECT NUMBER:	STP 2304(I)S	DRAWN BY:	MRS
FILE NAME:	/pave/01d048/pd048.dgn	CHECKED BY:	NLL
IPARM FILE NAME:	pd048I19.1	SHEET	37 OF 103

NOT TO SCALE

NOTE: ALL DIMENSIONS IN METERS EXCEPT AS INDICATED