

TEMPORARY 100mm WHITE LINE, PAINT
 DURABLE 100mm WHITE LINE, THERMOPLASTIC

STA 1+150 TO 1+152 SOLID RT NO PARKING
 STA 1+152 TO 1+155 SOLID RT NO PARKING
 STA 1+200 TO 1+266 DOTTED LT LANE LINE
 STA 1+200 TO 1+266 DOTTED RT LANE LINE
 STA 1+213 TO 1+219 SOLID RT
 STA 1+219 TO 1+228 SOLID LT
 STA 1+225 TO 1+234 SOLID RT
 STA 1+236 TO 1+238 SOLID LT NO PARKING
 STA 1+248 TO 1+250 SOLID LT NO PARKING
 STA 1+254 TO 1+290 SOLID RT
 STA 1+266 TO 1+290 SOLID LT

TEMPORARY 150mm WHITE LINE, PAINT
 DURABLE 150mm WHITE LINE, THERMOPLASTIC

STA 1+130 TO 1+150 TARGETS RT PARKING
 STA 1+155 TO 1+213 TARGETS RT PARKING
 STA 1+237 TO 1+248 TARGETS LT PARKING

TEMPORARY 100mm YELLOW LINE, PAINT
 DURABLE 100mm YELLOW LINE, THERMOPLASTIC

STA 1+130 TO 1+220 SOLID LT & RT
 STA 1+222 TO 1+225 DOUBLE SOLID RT (TH 57)
 STA 1+226 TO 1+232 DOUBLE SOLID LT (TH 61)
 STA 1+232 TO 1+290 SOLID LT & RT

TEMPORARY 600mm STOP BAR, PAINT
 DURABLE 600mm STOP BAR, TYPE 1 TAPE

STA 1+218 TO 1+225 LT (TH 61)
 STA 1+227 TO 1+241 RT (TH 57)

TEMPORARY LETTER OR SYMBOL, PAINT
 DURABLE LETTER OR SYMBOL, TYPE 1 TAPE

STA 1+223 LT - "STOP" (TH 61)
 STA 1+229 RT - "STOP" (TH 57)

TEMPORARY CROSSWALK MARKING, PAINT

STA 1+219 TO 1+227 RT (TH 57)
 STA 1+228 TO 1+234 LT (TH 61)

SPECIAL PROVISION (DURABLE
 CROSSWALK MARKING, IMPRINTED/COLORIZED)

STA 1+219 TO 1+227 RT (TH 57)
 STA 1+228 TO 1+234 LT (TH 61)

SPECIAL PROVISION
 IMPRINTED/COLORIZED SURFACE)

STA 1+208 TO 1+222 LT
 STA 1+213 TO 1+219 RT
 STA 1+226 TO 1+253 RT

CONSTRUCT SIDEWALK RAMP W/DETECTABLE
 WARNING SURFACE (YELLOW)

STA 1+219 RT (TYPE 1)
 STA 1+227 RT (TYPE 1)
 STA 1+228 LT (TYPE 6)
 STA 1+234 LT (TYPE 6)

CHANGING ELEVATION OF DROP INLETS,
 CATCH BASINS, OR MANHOLES

STA 1+144 LT (CB)
 STA 1+208 LT (CB)
 STA 1+216 RT (DMH)
 STA 1+218 RT (CB) (TH 57) - WAS NOT REQUIRED
 STA 1+219 LT (CB)
 STA 1+254 RT (CB) - WAS NOT REQUIRED

REHAB. DROP INLETS, CATCH BASINS,
 OR MANHOLES, CLASS 1

STA 1+144 RT (CB) - DID NOT TOUCH

CHANGING ELEVATION OF SEWER MANHOLES

STA 1+160 LT
 STA 1+216 LT

ADJUST ELEVATION OF VALVE BOX

STA 1+219 RT (TH 57)



REMOVING SIGNS

AS SHOWN - 6

ERECTING SALVAGED SIGNS

AS SHOWN - 1

STA 1+290.00
 (MM 0.802)

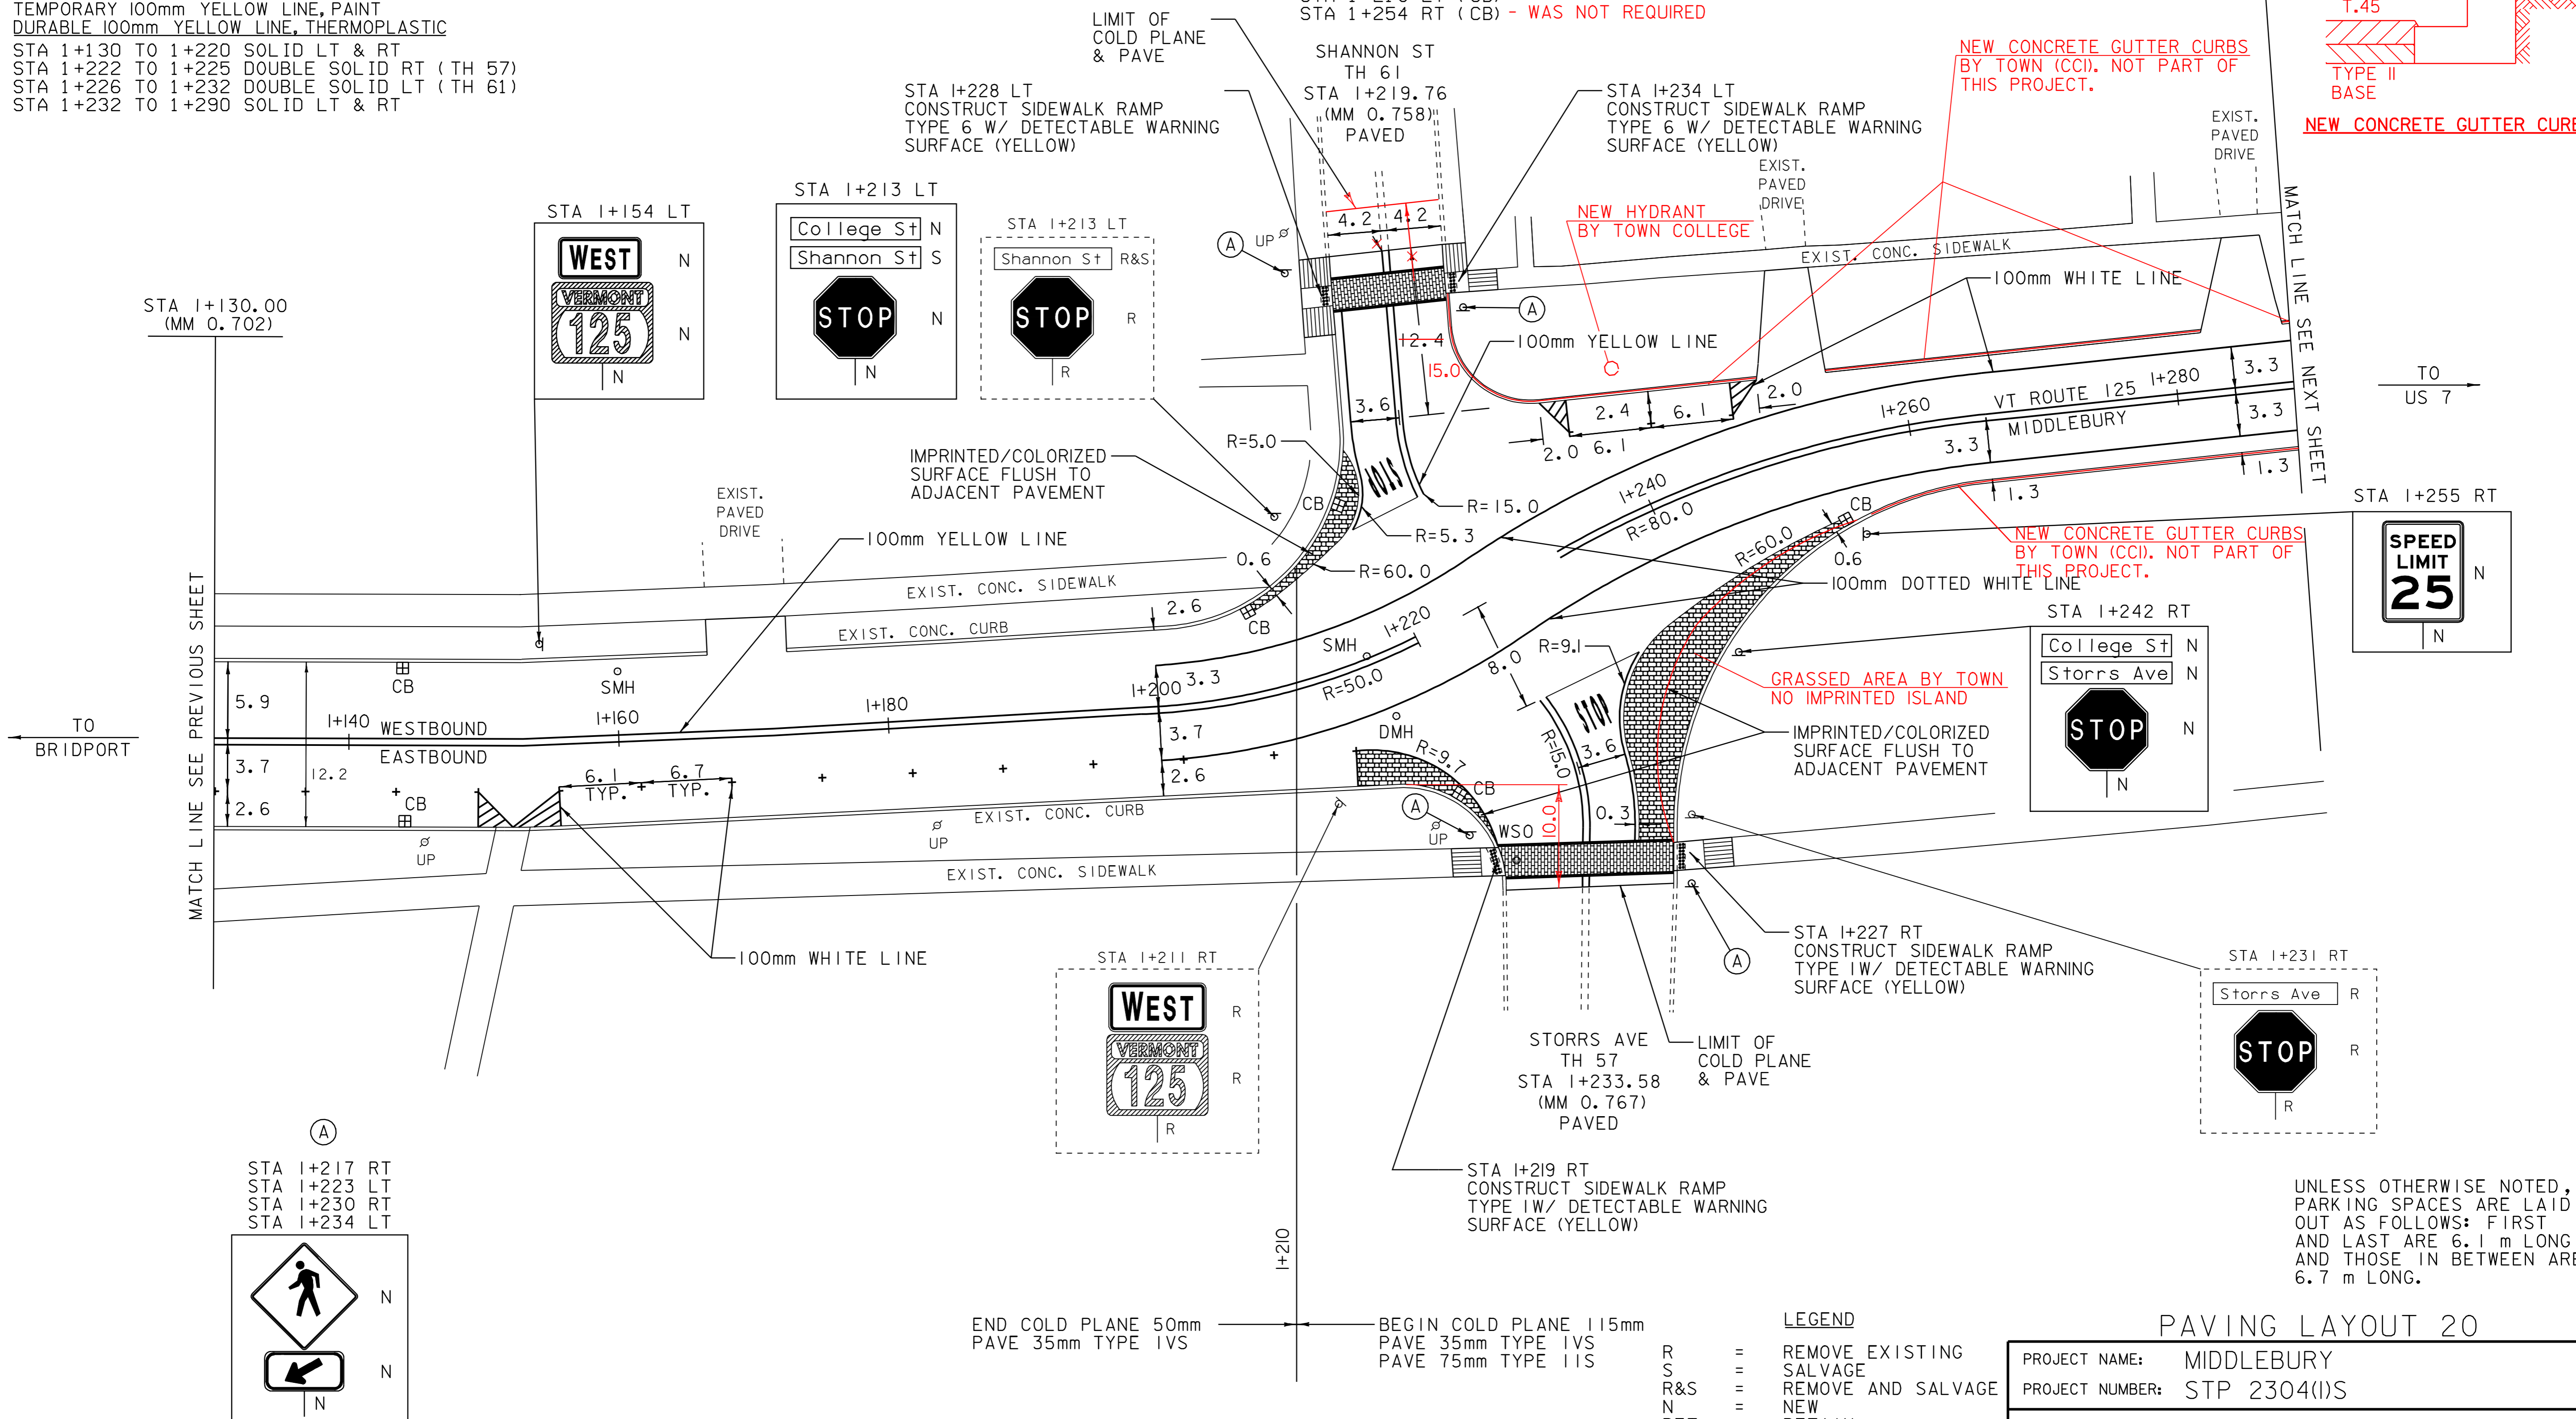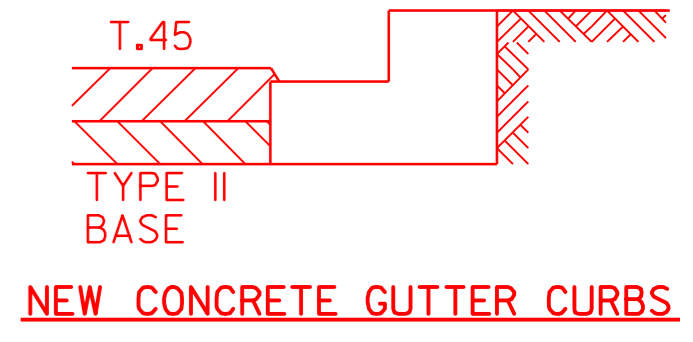

UNLESS OTHERWISE NOTED,
 PARKING SPACES ARE LAID
 OUT AS FOLLOWS: FIRST
 AND LAST ARE 6.1 m LONG
 AND THOSE IN BETWEEN ARE
 6.7 m LONG.

END COLD PLANE 50mm
 PAVE 35mm TYPE IVS

BEGIN COLD PLANE 115mm
 PAVE 35mm TYPE IVS
 PAVE 75mm TYPE IIS

LEGEND

R = REMOVE EXISTING
 S = SALVAGE
 R&S = REMOVE AND SALVAGE
 N = NEW
 RET = RETAIN
 B-B = BACK TO BACK

PAVING LAYOUT 20

PROJECT NAME: MIDDLEBURY
 PROJECT NUMBER: STP 2304(I)S

FILE NAME: /pave/0ld048/pd048.dgn
 PROJECT LEADER: PTS
 IPARM FILE NAME: pd048i20.i

PLOT DATE: 06-OCT-2008 13:00
 DRAWN BY: MRS
 CHECKED BY: NLL
 SHEET 38 OF 103