

TEMPORARY 100mm WHITE LINE, PAINT  
DURABLE 100mm WHITE LINE, THERMOPLASTIC

STA 1+290 TO 1+295 SOLID LT  
STA 1+290 TO 1+387 SOLID RT  
STA 1+313 TO 1+318 SOLID LT NO PARKING  
STA 1+324 TO 1+328 SOLID LT NO PARKING  
STA 1+334 TO 1+337 SOLID LT NO PARKING  
STA 1+343 TO 1+346 SOLID LT NO PARKING  
STA 1+352 TO 1+356 SOLID LT NO PARKING  
STA 1+381 TO 1+387 SOLID LT NO PARKING

TEMPORARY 150mm WHITE LINE, PAINT  
DURABLE 150mm WHITE LINE, THERMOPLASTIC

STA 1+318 TO 1+324 TARGETS LT PARKING  
STA 1+337 TO 1+343 TARGETS LT PARKING  
STA 1+356 TO 1+381 TARGETS LT PARKING

TEMPORARY 100mm YELLOW LINE, PAINT  
DURABLE 100mm YELLOW LINE, THERMOPLASTIC

STA 1+290 TO 1+387 SOLID LT & RT  
STA 1+390 TO 1+436 SOLID LT & RT  
STA 1+438 TO 1+440 SOLID LT & RT

TEMPORARY CROSSWALK MARKING, PAINT

STA 1+389 LT TO RT  
STA 1+437 LT TO RT

SPECIAL PROVISION (DURABLE  
CROSSWALK MARKING, IMPRINTED/COLORIZED)

STA 1+389 LT TO RT  
STA 1+437 LT TO RT

CONSTRUCT SIDEWALK RAMP W/DETECTABLE  
WARNING SURFACE (YELLOW)



STA 1+389 LT (TYPE 2)  
STA 1+389 RT  
STA 1+437 LT (TYPE 2)  
STA 1+437 RT (TYPE 1)

CHANGING ELEVATION OF DROP INLETS,  
CATCH BASINS, OR MANHOLES - WORK NOT REQUIRED

STA 1+298 LT (CB)  
STA 1+307 RT (CB)  
STA 1+385 LT (CB)  
STA 1+385 RT (CB)

CHANGE ELEVATION OF SEWER MANHOLE

STA 1+332 LT - NOT FOUND  
STA 1+406 LT  
STA 1+383 LT

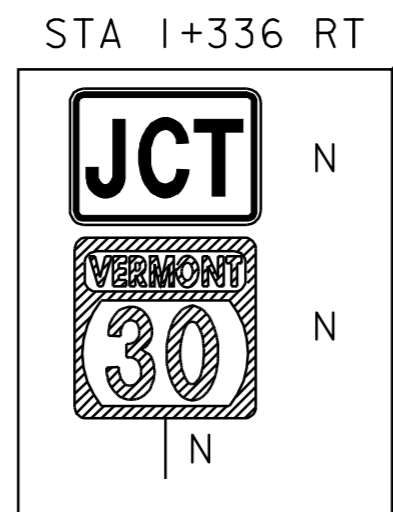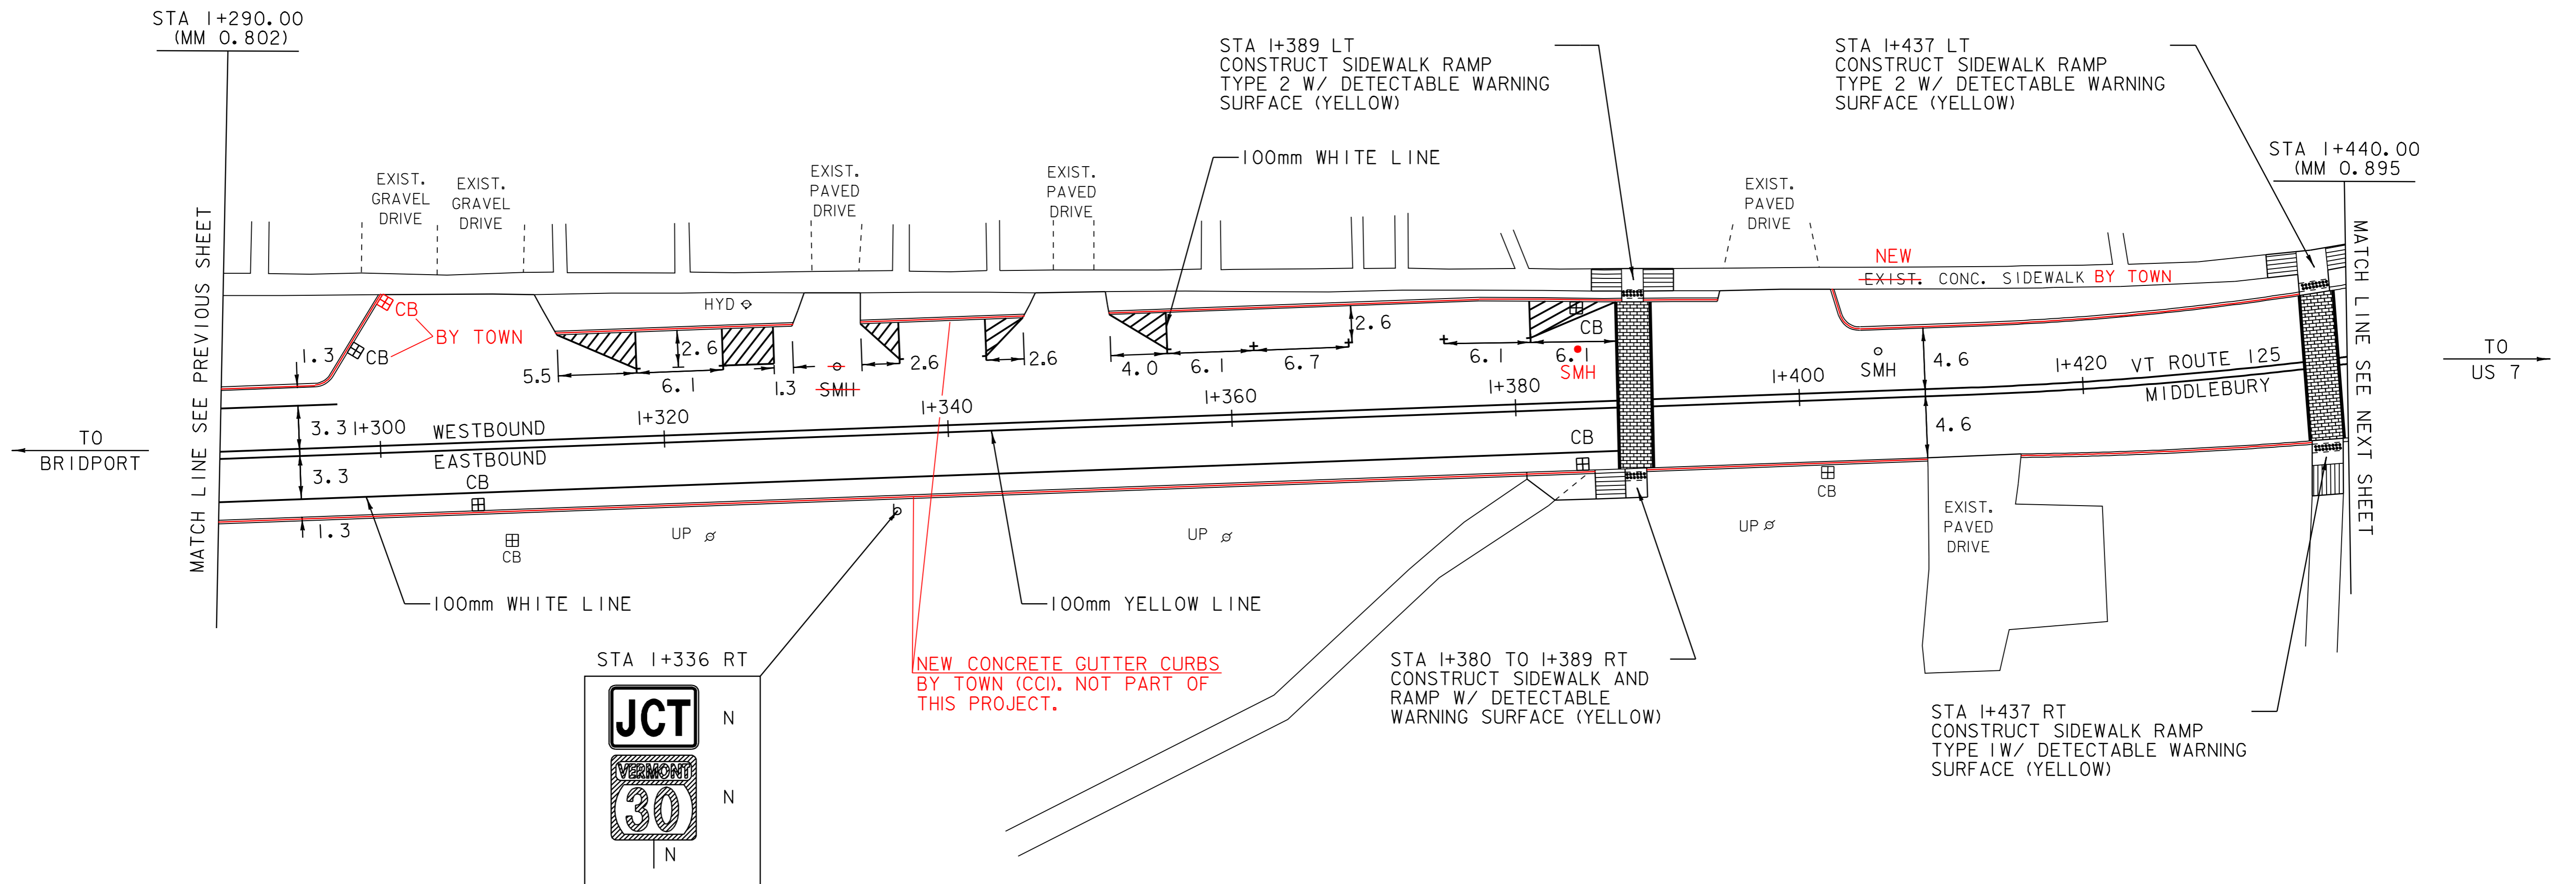

UNLESS OTHERWISE NOTED,  
PARKING SPACES ARE LAID  
OUT AS FOLLOWS: FIRST  
AND LAST ARE 6.1 m LONG  
AND THOSE IN BETWEEN ARE  
6.7 m LONG.

LEGEND

- R = REMOVE EXISTING
- S = SALVAGE
- R&S = REMOVE AND SALVAGE
- N = NEW
- RET = RETAIN
- B-B = BACK TO BACK

PAVING LAYOUT 21

PROJECT NAME: MIDDLEBURY	FILE NAME: /pave/01d048/pd048.dgn	PLOT DATE: 06-OCT-2008 13:00
PROJECT NUMBER: STP 2304(I)S	PROJECT LEADER: PTS	DRAWN BY: MRS
	IPARM FILE NAME: pd048i21.i	CHECKED BY: NLL
		SHEET 39 OF 103

NOT TO SCALE

NOTE: ALL DIMENSIONS IN METERS EXCEPT AS INDICATED