

REMOVE JOG IN CURB ON SEYMOUR STREET. EXTEND CURB LINE TO INTERSECTION AND RESET RADIUS TO 7.6 m. CONSTRUCT CONCRETE PAD W/ DETECTABLE WARNING SURFACE BETWEEN NEW CURB LINE AND EXISTING SLATE SIDEWALK.

SEYMOUR ST
SA 5
STA 2+863.06
(MM 1.779)
PAVED

STA 2+827.00
(MM 1.757)

CONCRETE PAD W/DETECTABLE WARNING SURFACE (YELLOW)

EXIST. PAVED DRIVE

EXIST. SLATE WALK 10%

METAL HAND RAILING

LANDING 'B' CHURCH

CONSTRUCT SIDEWALK RAMP FROM LANDING 'A' TO LANDING 'B'. INSTALL METAL HAND RAILING* (PROVIDED AND INSTALLED BY THE TOWN) ON TOP OF RETAINING WALL ALONG EXIST. SIDEWALK. THE RAMP BETWEEN THE LANDINGS WILL BE 5.0%.

LANDING 'A' W/ DETECTABLE WARNING SURFACE (YELLOW)

REMOVE EXISTING CONCRETE STAIRS AND CONSTRUCT NEW CONCRETE STAIRS (PER STANDARD J-2) AND METAL HAND RAILING. (METAL HAND RAILING WILL BE PROVIDED AND INSTALLED BY THE TOWN OF MIDDLEBURY)*.



MATCH LINE SEE SHEET #33

VT ROUTE 30 2+840
MIDDLEBURY

NEW TYPE A CONCRETE CURB

REMOVED EXISTING SIDEWALK REPLACED WITH MOUNTABLE CURBS AND TRUCK APRON (COLORED CONCRETE (BRICK))

SEE SHEET 33 OF 103 FOR DETAILS AND STATIONING 1m WIDE 200mm CONCRETE TRUCK APRON, COLORED BRICK RED

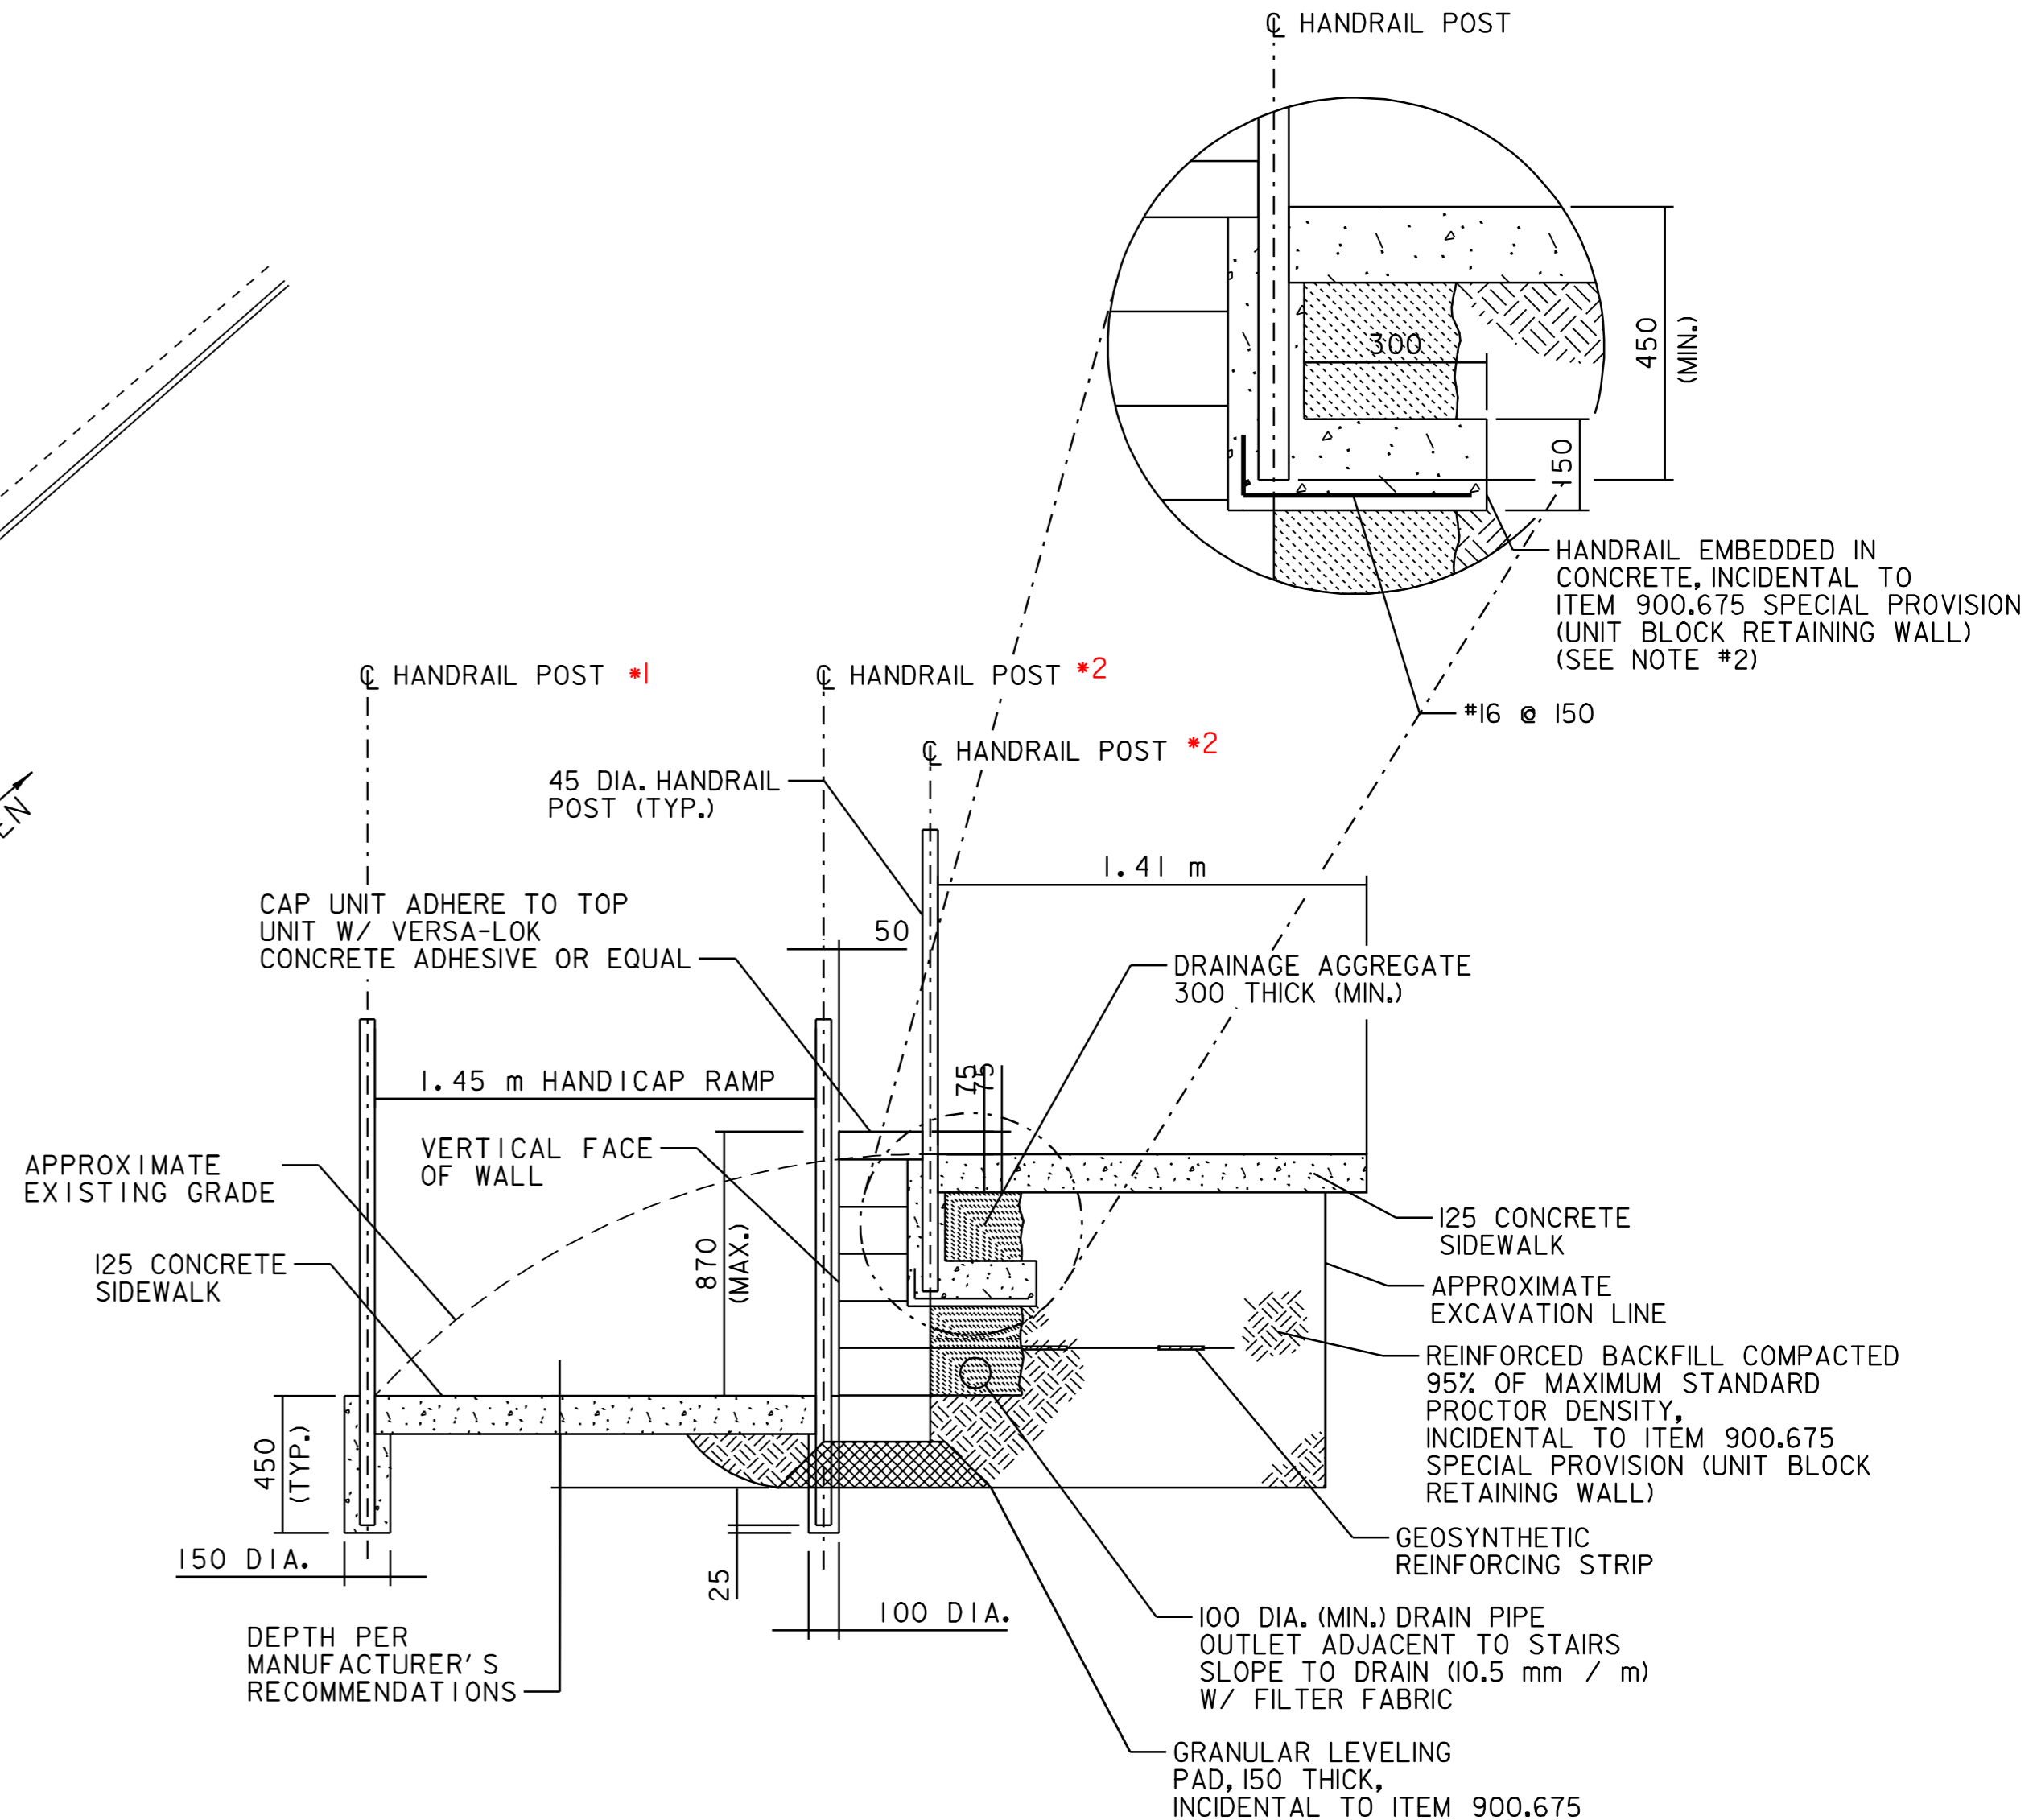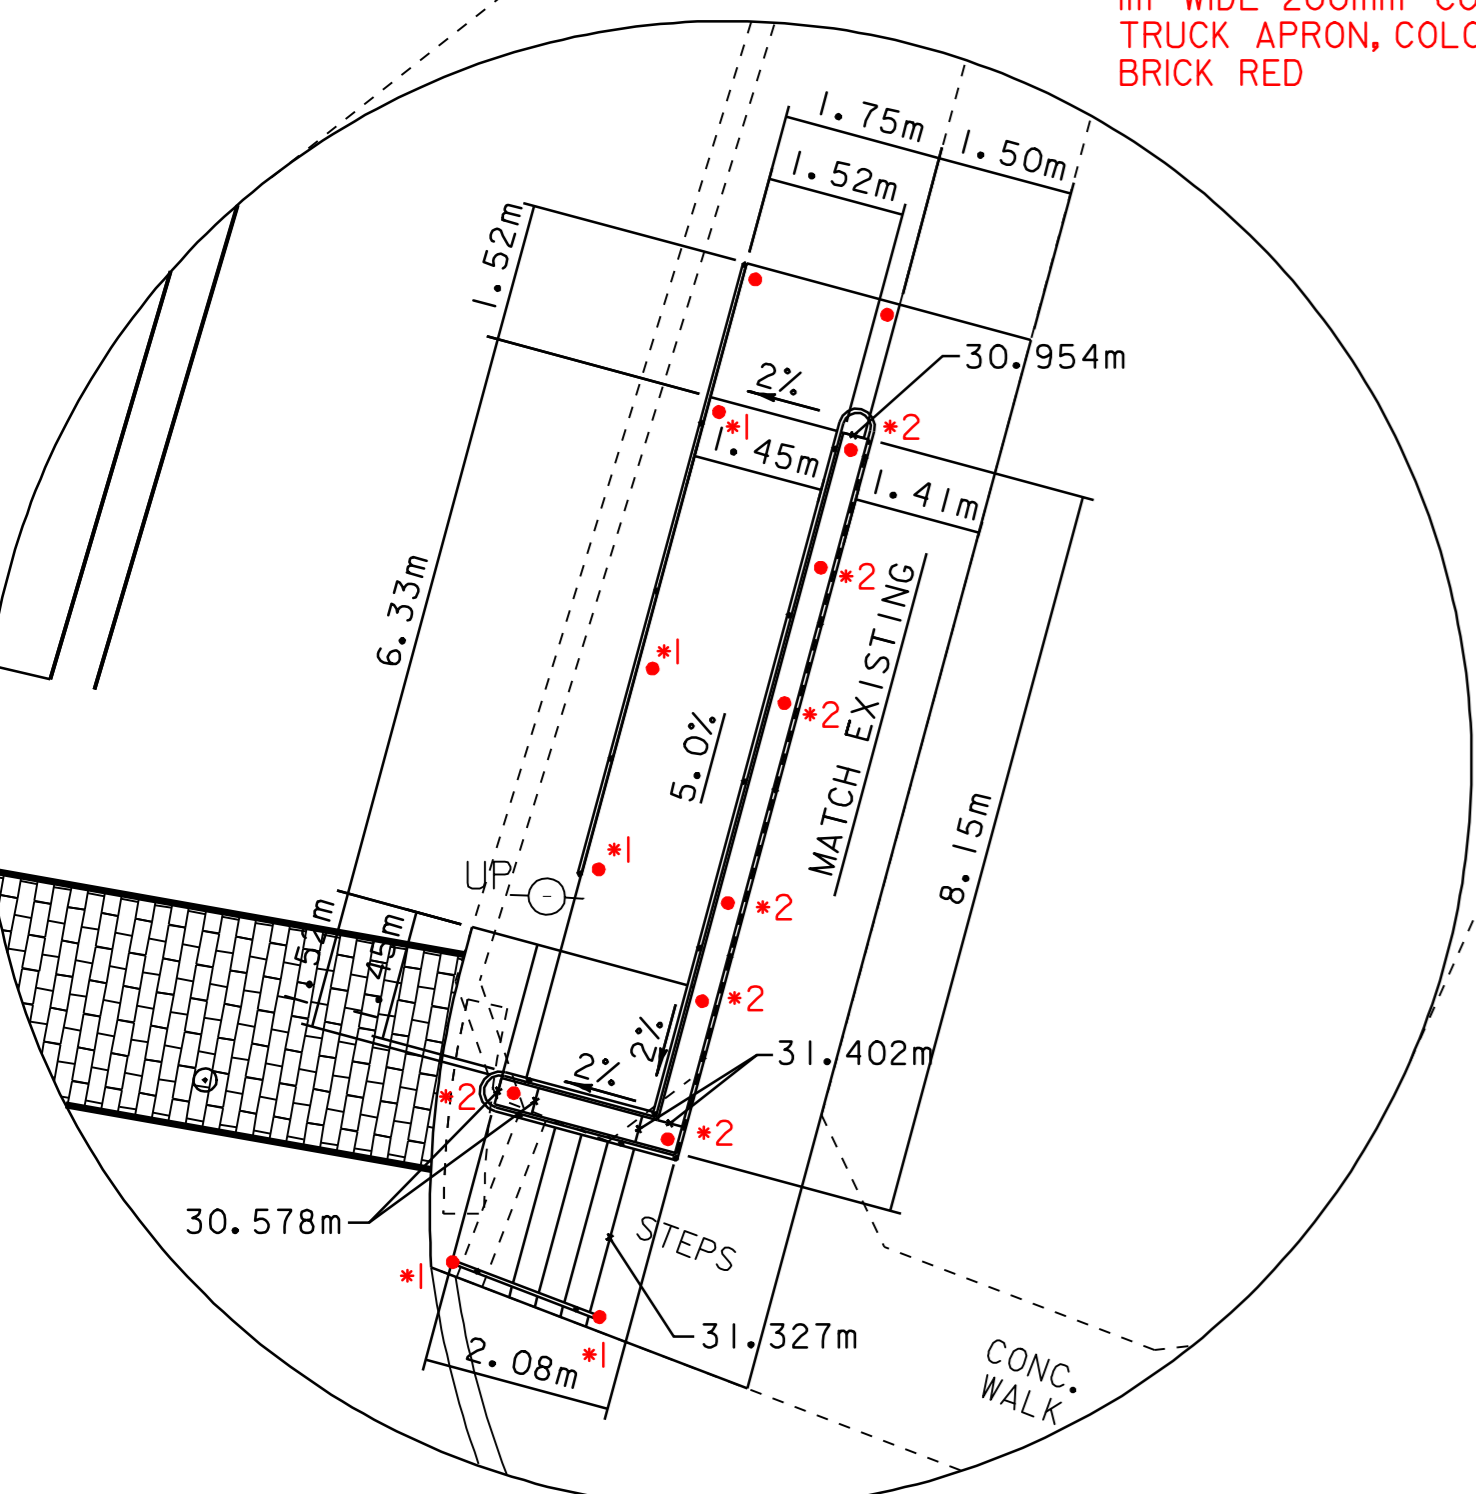

UNIT BLOCK RETAINING WALL

NOTE:

1. WALL TO BE MANUFACTURED & DESIGNED BY VERSA-LOK OR APPROVED EQUIVALENT. DETAIL PROVIDED FOR GENERAL INFORMATION ONLY. STAMPED FINAL DESIGN FOR MODULAR BLOCK WALL SYSTEM TO BE PROVIDED BY CONTRACTOR.
2. HANDRAIL SPACING AND TYPE TO BE DETERMINED AND PROVIDED BY THE TOWN PRIOR TO CONSTRUCTING THE WALL. CONCRETE FOR HANDRAIL EMBEDMENT BEHIND WALL IS SUBJECT TO HANDRAIL TYPE AND MAY NOT BE REQUIRED.

NOTES:

- *1) STAINLESS STEEL MOUNTING BRACKETS WERE USED TO MOUNT HANDRAIL. SS BRACKETS WERE CAST INTO THE NEW CONCRETE SIDEWALK RAMP WHERE REQUIRED. HANDRAIL WAS FABRICATED AND INSTALLED BY OTHERS (FOR THE TOWN OF MIDDLEBURY).
- *2) IN ADDITION, THE HANDRAIL FOR THE EASTERN SIDE WAS CORE DRILLED INTO THE RETAINING WALL BLOCKS.

SIDEWALK RAMP DETAIL

PROJECT NAME:	MIDDLEBURY	FILE NAME:	/pave/01d048/pd048.dgn	PLOT DATE:	06-OCT-2008 13:0
PROJECT NUMBER:	STP 2304(I)S	PROJECT LEADER:	PTS	DRAWN BY:	MRS
		IPARM FILE NAME:	pd048sr.1	CHECKED BY:	NLL
				SHEET	41 OF 103

NOT TO SCALE