


REMOVING SIGNS  
AS SHOWN - 21

ERECTING SALVAGED SIGNS  
AS SHOWN - 8

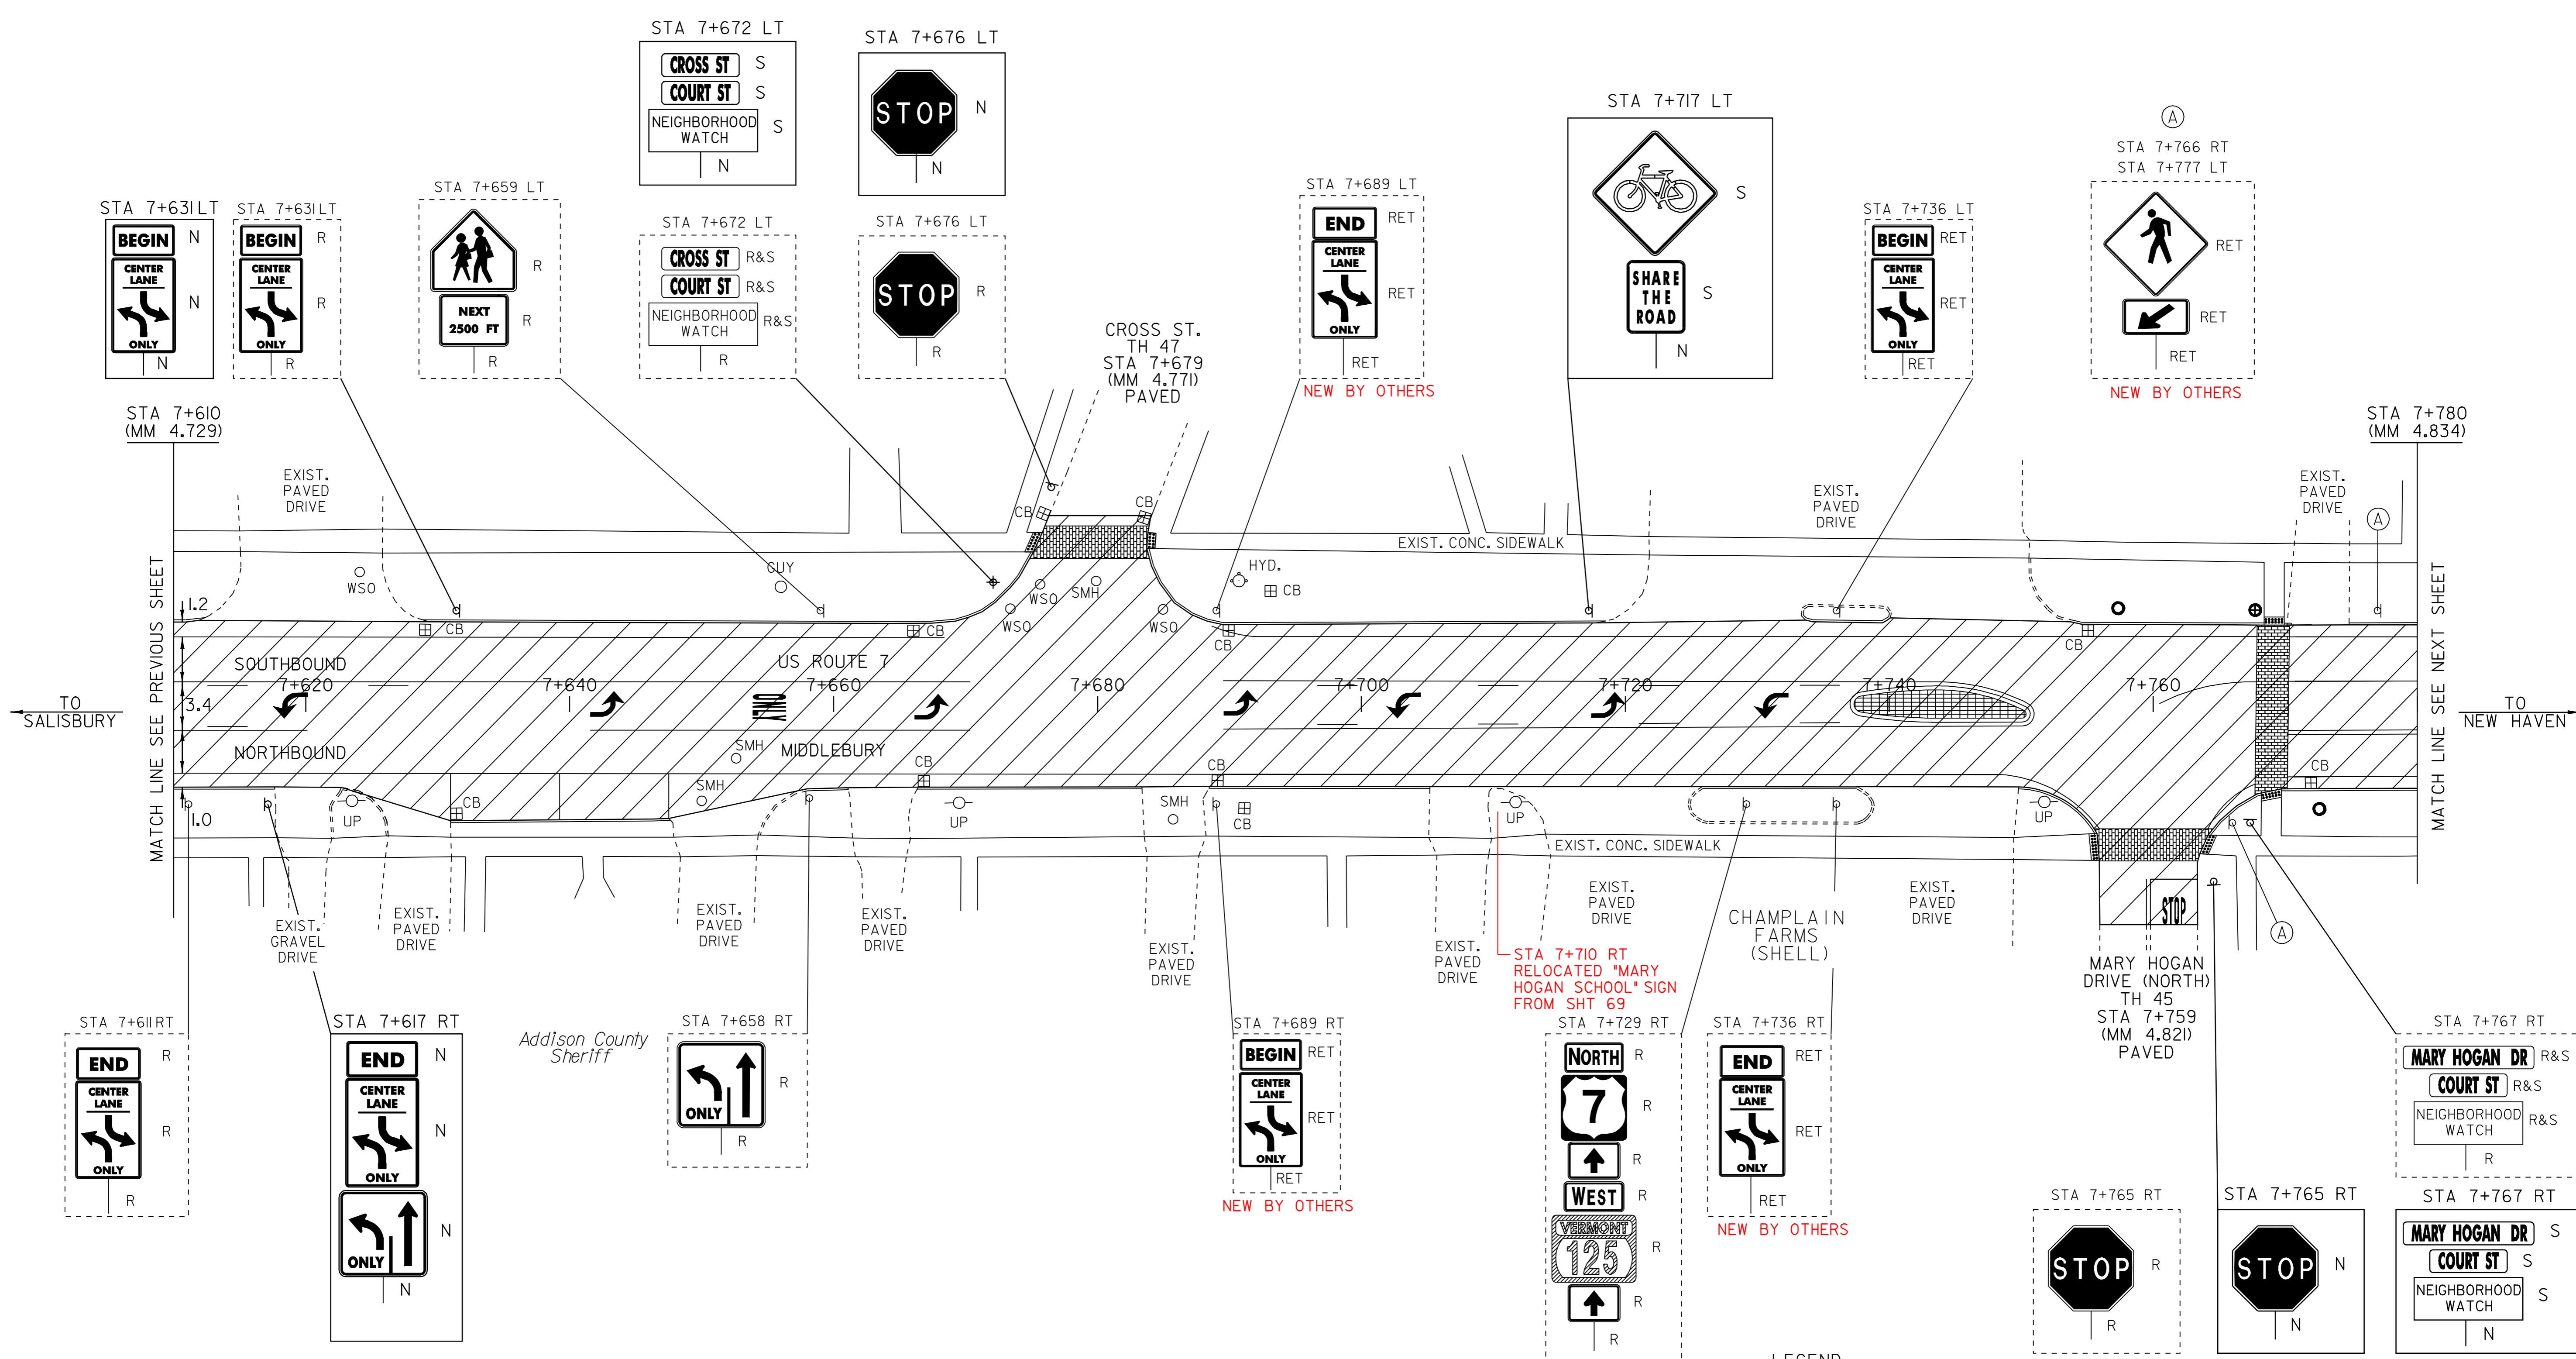

**LEGEND**

R	=	REMOVE EXISTING
S	=	SALVAGE
R&S	=	REMOVE AND SALVAGE
N	=	NEW
RET	=	RETAIN
B-B	=	BACK TO BACK WORK TO BE PERFORMED UNDER NHG 019-3 (52) S
	=	

**PAVING LAYOUT 6**

PROJECT NAME:	MIDDLEBURY	FILE NAME:	/pave/06b032/p06b032.dgn	PLOT DATE:	06-OCT-2008 13:
PROJECT NUMBER:	NH 2603(I)S	PROJECT LEADER:	PTS	DRAWN BY:	MRS
		DESIGNED BY:	NLL	CHECKED BY:	NLL
		IPARM FILE NAME:	p06b032a06.i	SHEET	71 OF 103

NOT TO SCALE NOTE: ALL DIMENSIONS IN METERS EXCEPT AS INDICATED