


THINNING AND TRIMMING FOR SIGNS
 STA 7+870 LT
 SEE DETAIL ON SHEET 101

REMOVING SIGNS
 AS SHOWN - 18

ERECTING SALVAGED SIGNS
 AS SHOWN - 2

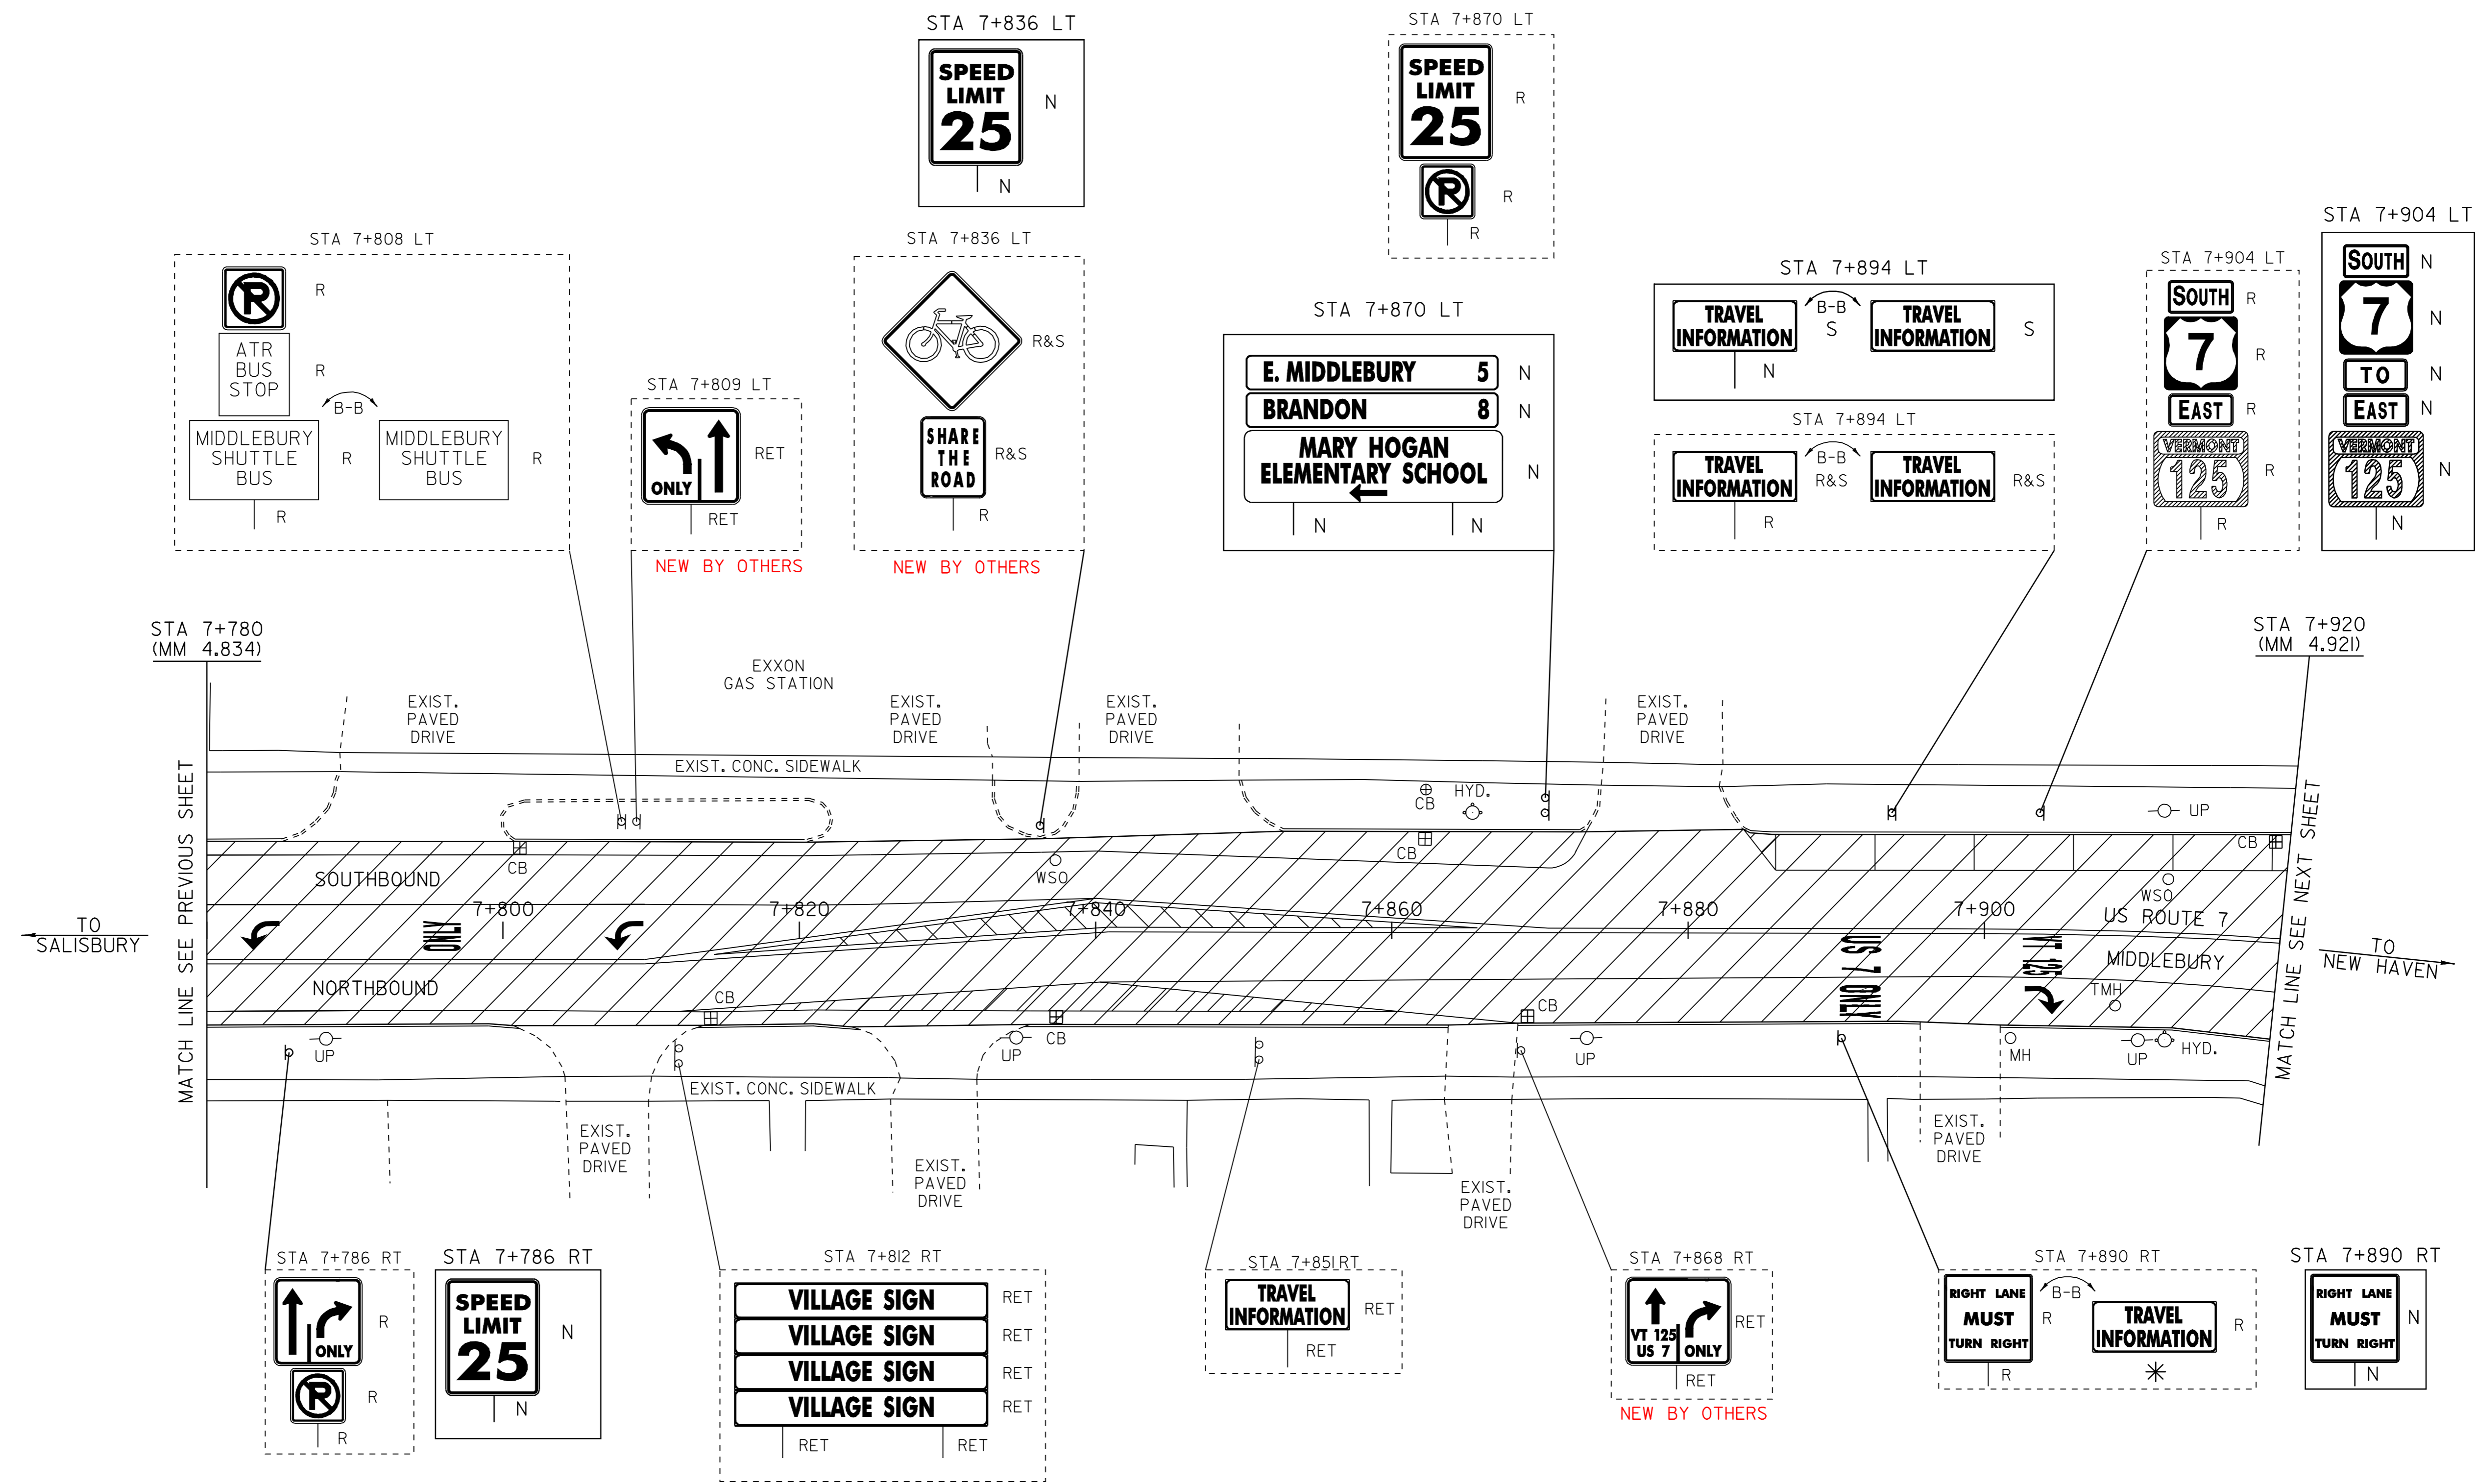

LEGEND

- R = REMOVE EXISTING
- S = SALVAGE
- R&S = REMOVE AND SALVAGE
- N = NEW
- RET = RETAIN
- B-B = BACK TO BACK
- /// = WORK TO BE PERFORMED UNDER NHG 019-3 (52) S

* DENOTES REMOVED SIGN TO BE RETURNED TO THE TOWN.

PAVING LAYOUT 7

PROJECT NAME:	MIDDLEBURY	FILE NAME:	/pave/06b032/p06b032.dgn	PLOT DATE:	06-OCT-2008 13:1
PROJECT NUMBER:	NH 2603(I)S	PROJECT LEADER:	PTS	DRAWN BY:	MRS
		DESIGNED BY:	NLL	CHECKED BY:	NLL
		IPARM FILE NAME:	p06b032la07.1	SHEET	72 OF 103

NOT TO SCALE

NOTE: ALL DIMENSIONS IN METERS EXCEPT AS INDICATED