

**TEMPORARY 100mm WHITE LINE, PAINT**

STA 1+000	TO 1+039	SOLID RT
STA 1+048	TO 1+049	SOLID RT NO PARKING (TH 47)
STA 1+051	TO 1+051	SOLID RT NO PARKING (TH 47)
STA 1+051	TO 1+051	SOLID RT PARKING (TH 47)
STA 1+056	TO 1+105	SOLID RT LANE LINE
STA 7+971	TO 7+981	SOLID RT LANE LINE
STA 7+971	TO 8+029	DASHED RT LANE LINE
STA 7+981	TO 8+001	SOLID RT
STA 7+994	TO 8+001	SOLID RT
STA 7+996	TO 8+015	SOLID RT
STA 8+000	TO 8+029	DOTTED LT LANE LINE
STA 8+006	TO 8+015	SOLID RT NO PARKING
STA 8+015	TO 8+040	SOLID RT PARKING
STA 8+029	TO 8+047	SOLID LT LANE LINE
STA 8+029	TO 8+047	SOLID RT LANE LINE
STA 8+040	TO 8+046	SOLID RT NO PARKING
STA 8+049	TO 8+081	SOLID RT NO PARKING
STA 8+049	TO 8+070	SOLID LT LANE LINE
STA 8+049	TO 8+100	SOLID RT LANE LINE
STA 8+084	TO 8+100	SOLID LT
STA 8+094	TO 8+100	SOLID RT LANE LINE

**DURABLE 100mm WHITE LINE, THERMOPLASTIC**

STA 1+000	TO 1+039	SOLID RT
STA 1+048	TO 1+049	SOLID RT NO PARKING (TH 47)
STA 1+051	TO 1+051	SOLID RT NO PARKING (TH 47)
STA 1+051	TO 1+051	SOLID RT PARKING (TH 47)
STA 7+981	TO 8+001	SOLID RT
STA 7+996	TO 8+015	SOLID RT
STA 8+006	TO 8+015	SOLID RT NO PARKING
STA 8+015	TO 8+040	SOLID RT PARKING
STA 8+040	TO 8+046	SOLID RT NO PARKING
STA 8+049	TO 8+081	SOLID RT NO PARKING
STA 8+084	TO 8+100	SOLID LT

**DURABLE 100mm WHITE LINE, TYPE 1 TAPE**

STA 1+056	TO 1+105	SOLID RT LANE LINE
STA 7+971	TO 7+981	SOLID RT LANE LINE
STA 7+971	TO 8+029	DASHED RT LANE LINE
STA 8+000	TO 8+029	DOTTED LT LANE LINE
STA 8+029	TO 8+047	SOLID LT LANE LINE
STA 8+029	TO 8+047	SOLID RT LANE LINE
STA 8+049	TO 8+070	SOLID LT LANE LINE
STA 8+049	TO 8+100	SOLID RT LANE LINE

**TEMPORARY 100mm YELLOW LINE, PAINT**

STA 1+000	TO 1+021	SOLID LT
STA 1+019	TO 1+041	SOLID LT
STA 1+045	DOUBLE SOLID RT (SA 8)	
STA 1+049	DOUBLE SOLID RT (TH 47)	
STA 7+981	TO 7+993	SOLID RT
STA 7+994	TO 8+001	SOLID RT
STA 8+062	TO 8+081	SOLID LT
STA 8+084	TO 8+100	LT & RT

**DURABLE 200mm YELLOW LINE, THERMOPLASTIC**

STA 7+981	TO 7+989	RT GORE
-----------	----------	---------

**SPECIAL PROVISION IMPRINTED/COLORIZED SURFACE**

STA 1+020	TO 1+044	LT
STA 8+062	TO 8+081	LT

**TEMPORARY CROSSWALK MARKING, PAINT**

STA 1+040	TO 1+053	RT TO LT
STA 1+044	TO 1+047	RT (SA 8)
STA 1+047	TO 1+051	RT (TH 47)
STA 1+053	TO 1+055	LT TO RT
STA 1+107	TO 1+109	LT TO RT
STA 7+990	TO 7+996	RT (TH 6)
STA 8+048	TO 8+048	LT TO RT

**SPECIAL PROVISION (DURABLE CROSSWALK MARKING, IMPRINTED/COLORIZED)**


STA 1+040	TO 1+053	RT TO LT
STA 1+044	TO 1+047	RT (SA 8)
STA 1+047	TO 1+051	RT (TH 47)
STA 1+053	TO 1+055	LT TO RT
STA 1+107	TO 1+109	LT TO RT
STA 7+990	TO 7+996	RT (TH 6)
STA 8+048	TO 8+048	LT TO RT

**TEMPORARY 600mm STOP BAR, PAINT**

STA 1+050	RT (TH 47)
STA 1+105	RT

**TEMPORARY LETTER OR SYMBOL, PAINT**

STA 1+016	RT - YIELD MARKINGS (5)
STA 1+046	RT - YIELD MARKINGS (5) (SA 8)
STA 1+050	RT - "STOP" (TH 47)
STA 1+078	RT - RIGHT TURN ARROW
STA 1+078	LT - LEFT TURN ARROW
STA 1+102	RT - RIGHT TURN ARROW
STA 1+102	LT - LEFT TURN ARROW
STA 7+998	RT - YIELD MARKINGS (4)
STA 8+030	LT - LEFT TURN ARROW
STA 8+030	RT - "VT 30"
STA 8+030	RT - "US 7"
STA 8+051	RT - "VT 125"
STA 8+066	LT - LEFT TURN ARROW
STA 8+076	RT - LEFT TURN ARROW

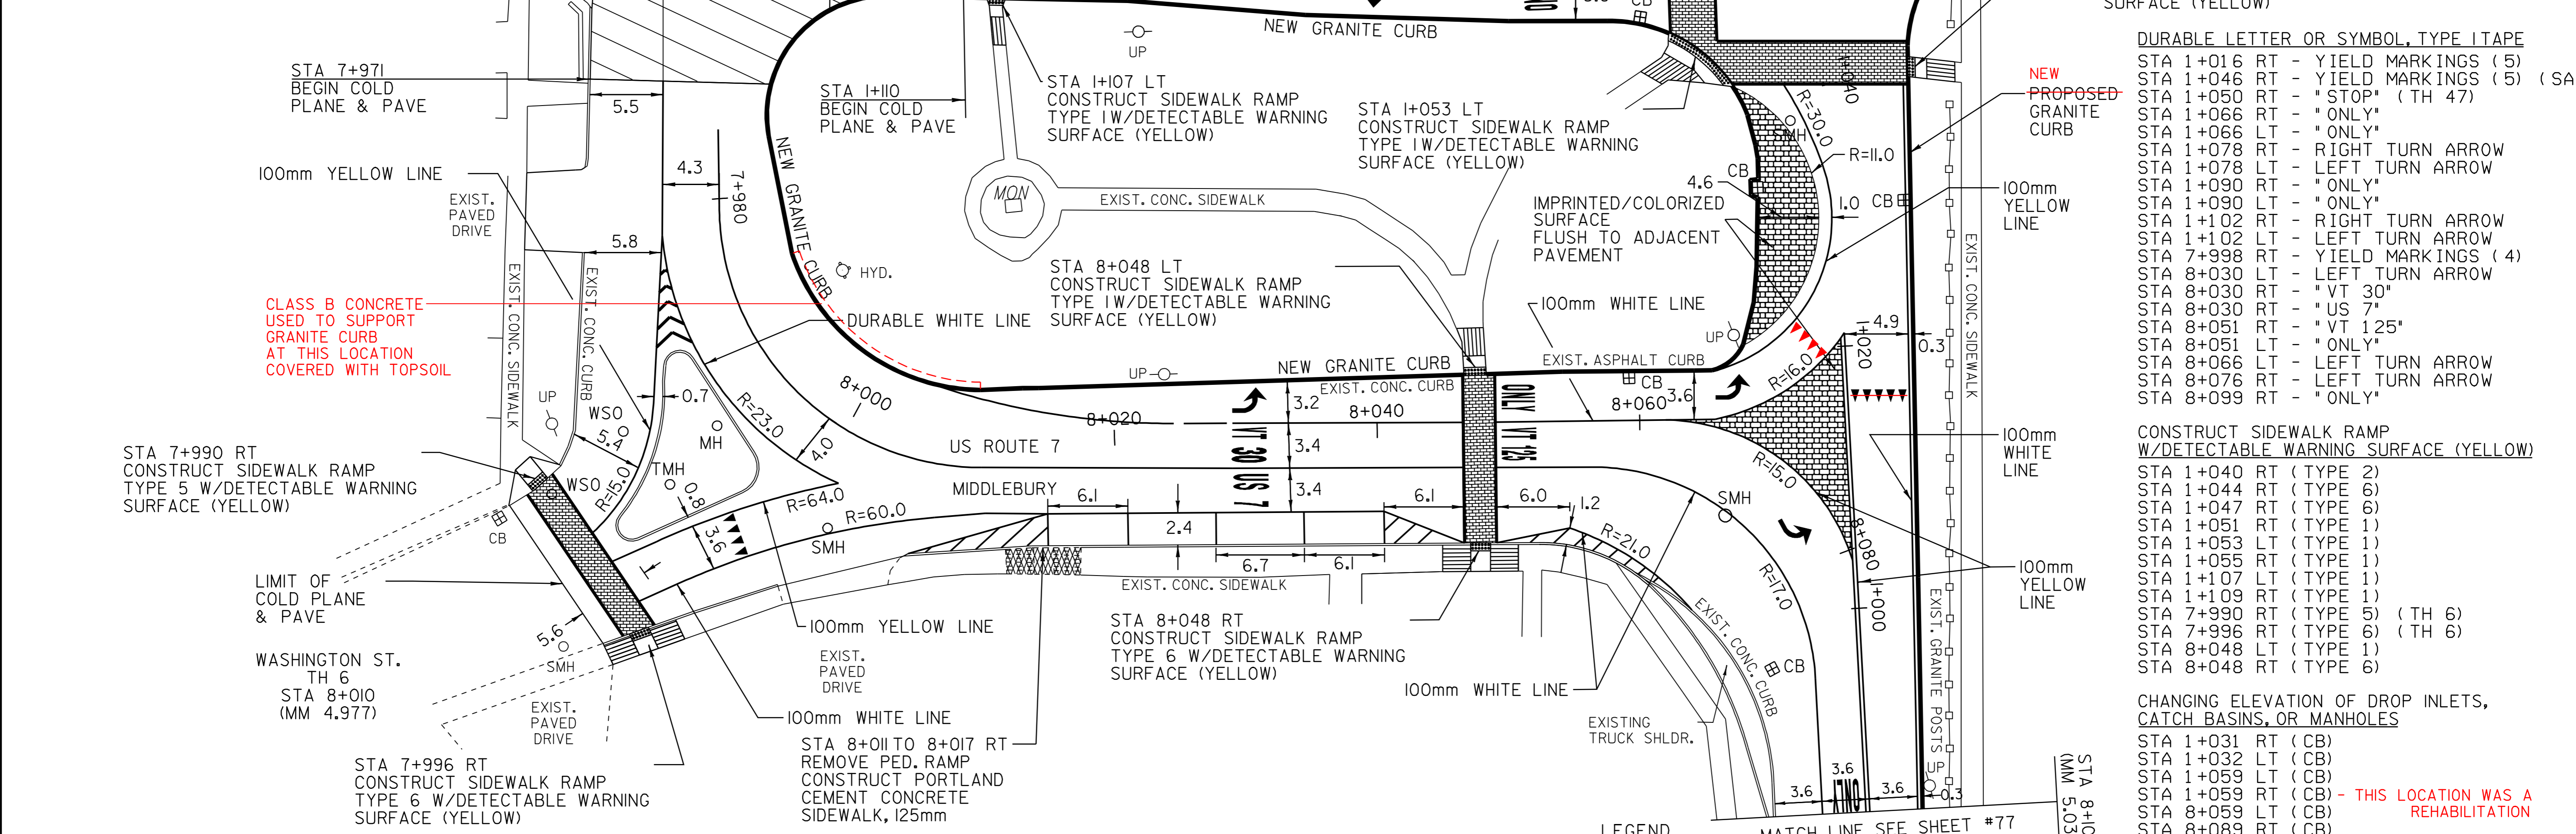

**VERTICAL GRANITE CURB**

STA 1+000	TO 1+044	RT
STA 1+019	TO 1+115	LT
STA 7+964	TO 8+064	LT
STA 8+084	TO 8+100	LT

**CAST-IN-PLACE CONCRETE CURB, TYPE B**

STA 1+056	TO 1+108	RT
-----------	----------	----

**PORTLAND CEMENT CONCRETE SIDEWALK, 125 mm**

STA 8+011	TO 8+017	RT
-----------	----------	----

**ADJUST ELEVATION OF VALVE BOX**

STA 1+047	RT
STA 1+049	RT
STA 7+991	RT
STA 7+992	RT
STA 1+046	RT
STA 1+048	RT

**CHANGING ELEVATION OF SEWER MANHOLES**

STA 1+037	LT
STA 8+002	RT
STA 8+070	RT

**THINNING AND TRIMMING FOR SIGNS**

STA 1+096	RT
STA 1+105	RT

SEE DETAIL ON SHEET 101

**LEGEND**

R	= REMOVE EXISTING
S	= SALVAGE
R&S	= REMOVE AND SALVAGE
N	= NEW
RET	= RETAIN
B-B	= BACK TO BACK
	= WORK TO BE PERFORMED UNDER NHG 019-3 (52) S

**PAVING LAYOUT 8A - NOTES**

PROJECT NAME: MIDDLEBURY  
PROJECT NUMBER: NH 2603(I)S

FILE NAME: /pave/06b032/p06b032.dgn  
PROJECT LEADER: PTS  
DESIGNED BY: NLL  
IPARM FILE NAME: p06b032la08a.i

PLOT DATE: 06-OCT-2008 13:1  
DRAWN BY: MRS  
CHECKED BY: NLL  
SHEET 73 OF 103

NOT TO SCALE NOTE: ALL DIMENSIONS IN METERS EXCEPT AS INDICATED