

TEMPORARY 100mm WHITE LINE, PAINT  
 DURABLE 100mm WHITE LINE, THERMOPLASTIC  
 STA 8+271 TO 8+277 SOLID RT NO PARKING  
 STA 8+274 TO 8+277 SOLID LT PARKING  
 STA 8+276 TO 8+320 SOLID RT  
 STA 8+277 TO 8+283 SOLID LT NO PARKING  
 STA 8+285 TO 8+317 SOLID LT PARKING  
 STA 8+327 TO 8+430 SOLID RT  
 STA 8+341 TO 8+430 SOLID LT

TEMPORARY 100mm YELLOW LINE, PAINT  
 DURABLE 100mm YELLOW LINE, THERMOPLASTIC  
 STA 8+270 TO 8+318 SOLID LT & RT  
 STA 8+335 TO 8+430 SOLID LT & RT

TEMPORARY 600mm STOP BAR, PAINT  
 DURABLE 600mm STOP BAR, TYPE I TAPE  
 STA 8+324 RT (SA 7)

TEMPORARY CROSSWALK MARKING, PAINT  
 STA 8+319 TO 8+328 RT (SA 7)  
 STA 8+327 TO 8+331 LT (TH 71)

SPECIAL PROVISION  
 (DURABLE CROSSWALK MARKING, IMPRINTED/COLORIZED)  
 STA 8+319 TO 8+328 RT (SA 7)  
 STA 8+327 TO 8+331 LT (TH 71)

TEMPORARY LETTER OR SYMBOL, PAINT  
 DURABLE LETTER OR SYMBOL, TYPE I TAPE  
 STA 8+324 RT - "STOP" (SA 7)

CONSTRUCT SIDEWALK RAMP  
 W/DETECTABLE WARNING SURFACE (YELLOW)  
 STA 8+327 LT (TYPE 1) (TH 71)  
 STA 8+331 LT (TH 71)

CHANGING ELEVATION OF DROP INLETS,  
 CATCH BASINS, OR MANHOLES  
 STA 8+317 RT (CB)  
 STA 8+328 LT (CB)  
 STA 8+331 RT (CB)  
 STA 8+424 RT (CB)


CHANGING ELEVATION OF SEWER MANHOLES  
 STA 8+322 RT  
 STA 8+331 LT  
 STA 8+421 RT

ADJUST ELEVATION OF VALVE BOX  
 STA 8+320 LT STA 8+319 LT  
 STA 8+322 LT  
 CAST-IN-PLACE CONCRETE CURB, TYPE B  
 STA 8+270 TO 8+315 RT  
 STA 8+317 TO 8+327 LT

THINNING AND TRIMMING FOR SIGNS  
 STA 8+350 RT  
 STA 8+368 LT  
 STA 8+419 RT  
 SEE DETAIL SHEET 101

REMOVING SIGNS  
 AS SHOWN - 17

ERECTING SALVAGED SIGNS  
 AS SHOWN - 3

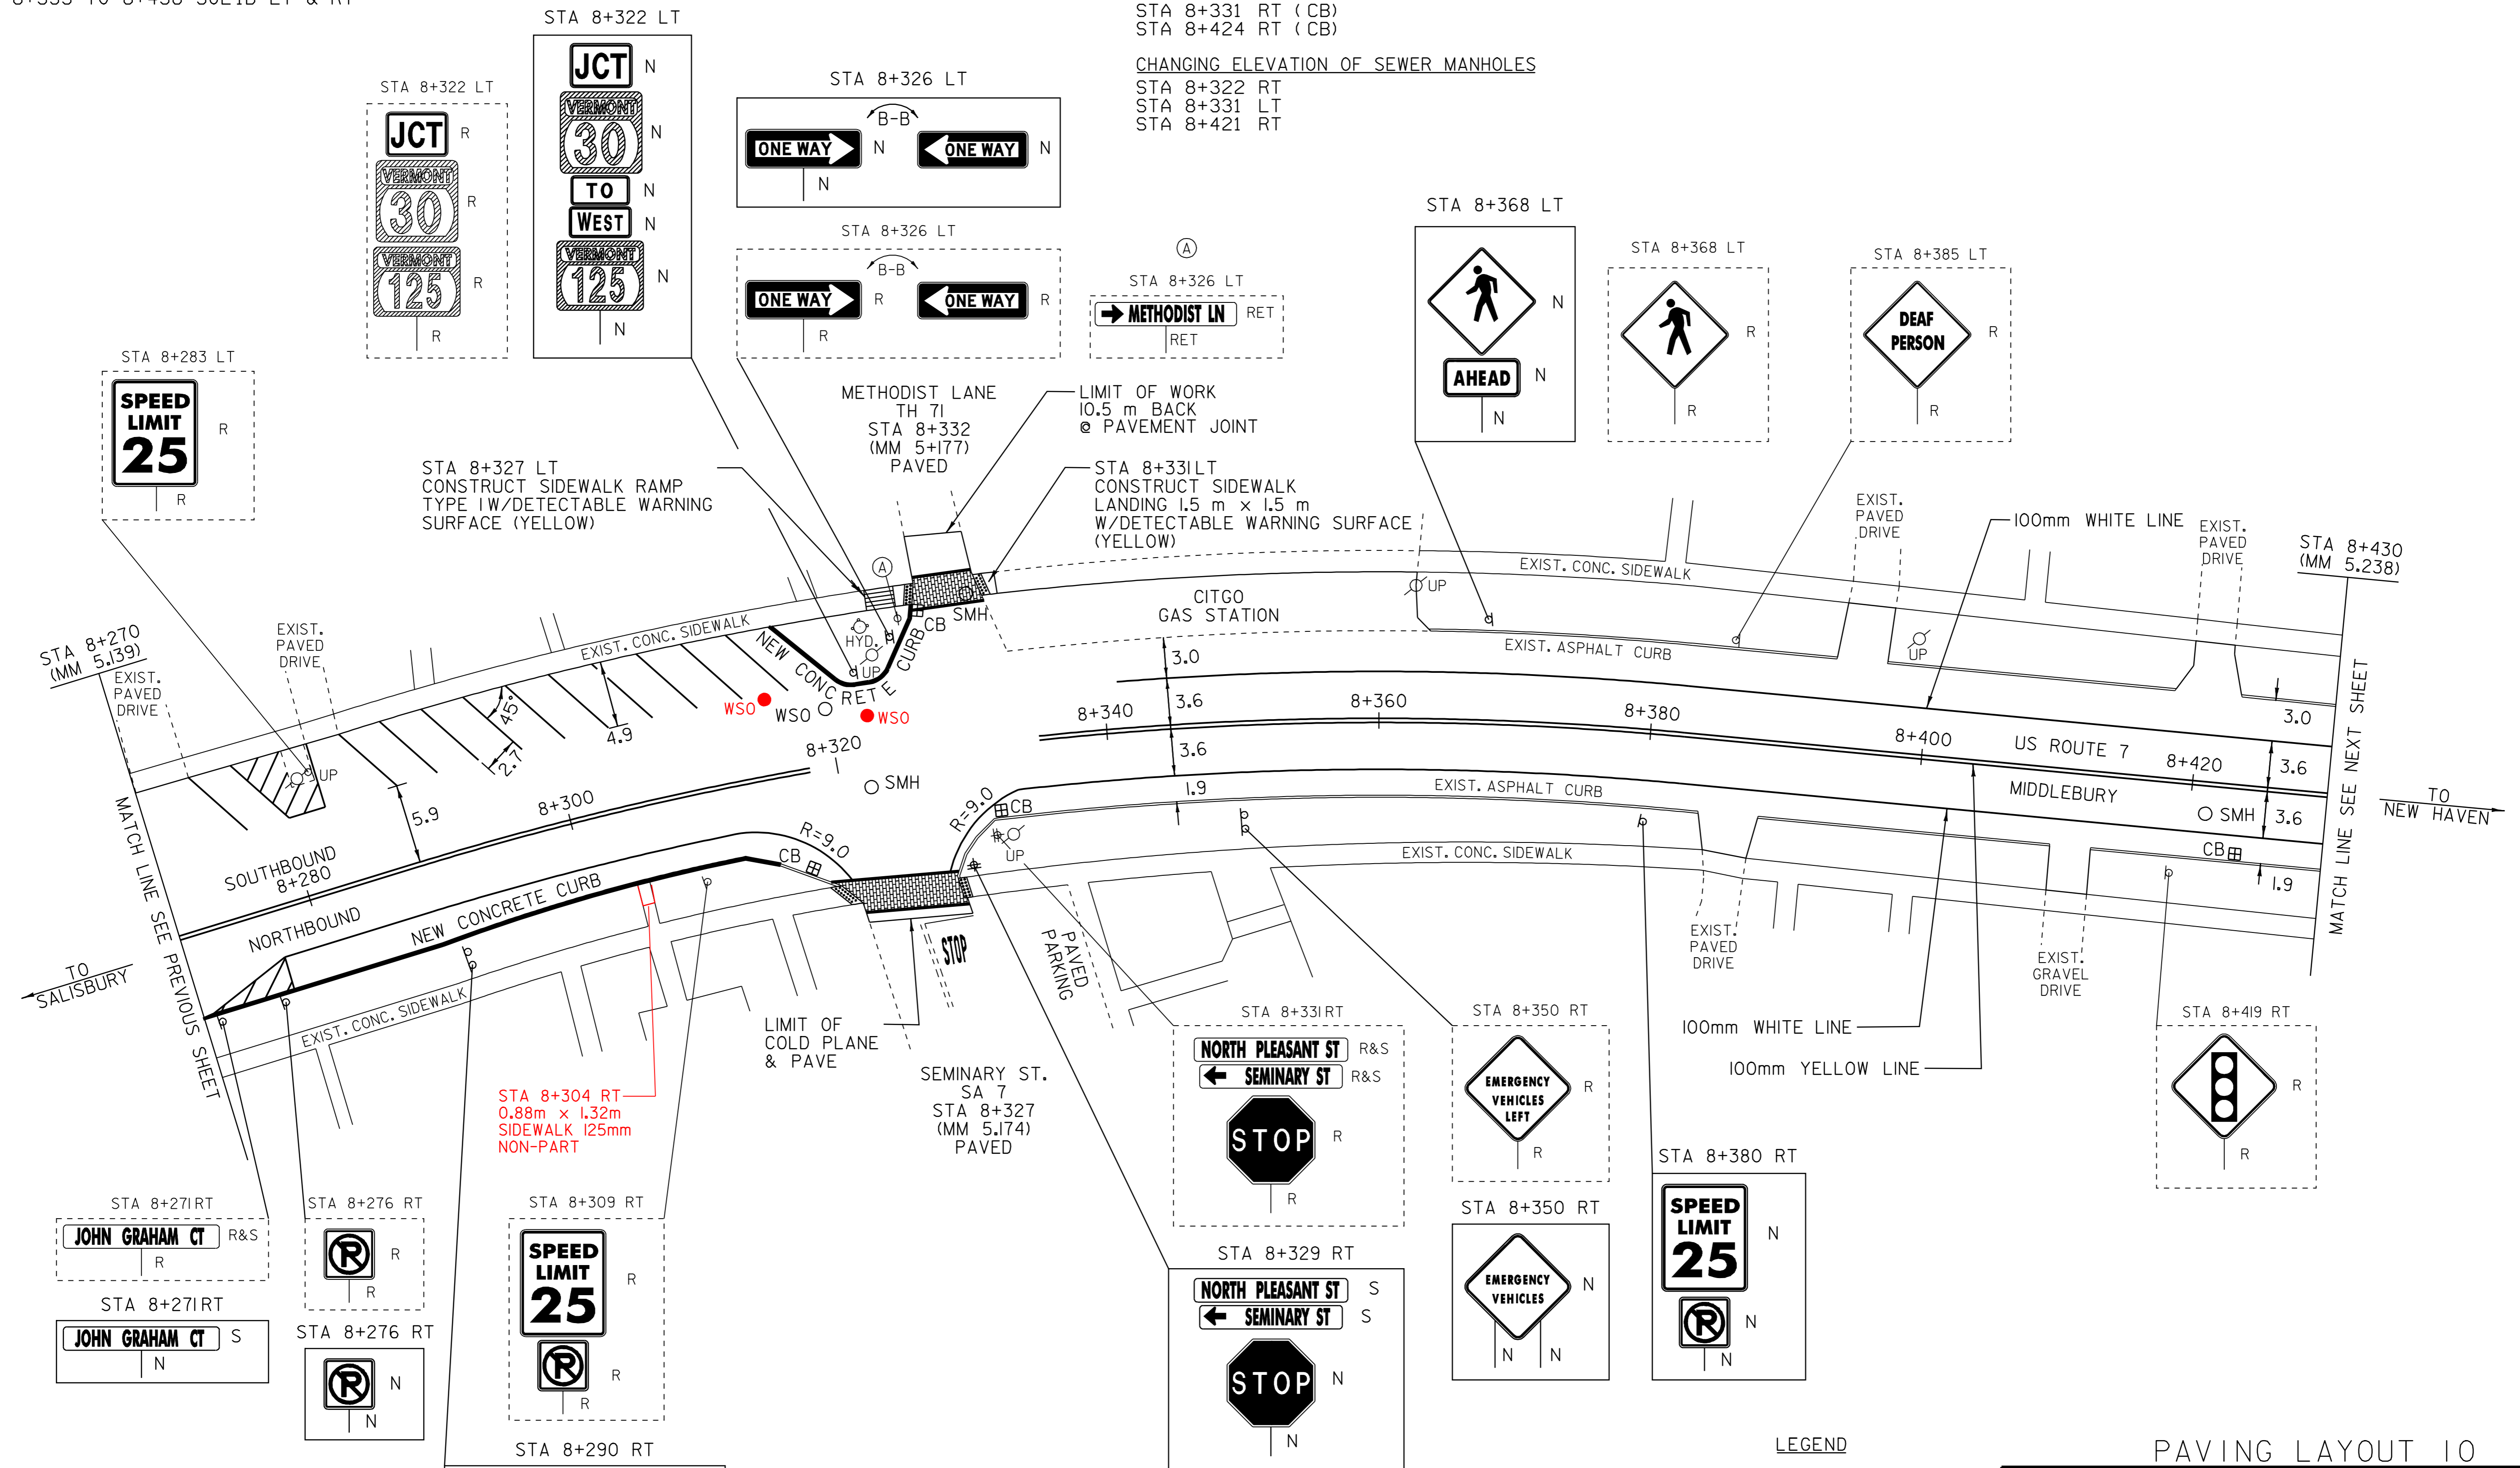

STA 8+304 RT  
 0.88m x 1.32m  
 SIDEWALK 125mm  
 NON-PART

VERGENNES 13 N  
 BURLINGTON 32 N

LEGEND  
 R = REMOVE EXISTING  
 S = SALVAGE  
 R&S = REMOVE AND SALVAGE  
 N = NEW  
 RET = RETAIN  
 B-B = BACK TO BACK

NOT TO SCALE

NOTE: ALL DIMENSIONS IN METERS EXCEPT AS INDICATED

PAVING LAYOUT 10

PROJECT NAME: MIDDLEBURY  
 PROJECT NUMBER: NH 2603(I)S

FILE NAME: /pave/06b032/p06b032.dgn PLOT DATE: 06-OCT-2008 13:01  
 PROJECT LEADER: PTS DRAWN BY: MRS  
 DESIGNED BY: NLL CHECKED BY: NLL  
 IPARM FILE NAME: p06b032la10.1 SHEET 78 OF 103