

TEMPORARY 100mm WHITE LINE, PAINT
 STA 8+430 TO 8+516 SOLID RT
 STA 8+430 TO 8+518 SOLID LT
 STA 8+450 TO 8+482 DOTTED RT LANE LINE
 STA 8+482 TO 8+513 SOLID RT LANE LINE
 STA 8+519 SOLID LT (TH 72)
 STA 8+522 SOLID LT (TH 72) LANE LINE
 STA 8+531 SOLID LT (TH 72)
 STA 8+532 TO 8+590 SOLID RT
 STA 8+533 TO 8+590 SOLID LT

DURABLE 100mm WHITE LINE, THERMOPLASTIC

STA 8+430 TO 8+516 SOLID RT
 STA 8+430 TO 8+518 SOLID LT
 STA 8+519 SOLID LT (TH 72)
 STA 8+531 SOLID LT (TH 72)
 STA 8+532 TO 8+590 SOLID RT
 STA 8+533 TO 8+590 SOLID LT

DURABLE 100mm WHITE LINE, TYPE ITAPE

STA 8+450 TO 8+482 DOTTED RT LANE LINE
 STA 8+482 TO 8+513 SOLID RT LANE LINE
 STA 8+522 SOLID LT (TH 72) LANE LINE

TEMPORARY 100mm YELLOW LINE, PAINT
DURABLE 100mm YELLOW LINE, THERMOPLASTIC

STA 8+430 TO 8+513 SOLID LT & RT
 STA 8+520 TO 8+521 DOUBLE SOLID RT (TH 75)
 STA 8+525 DOUBLE SOLID LT (TH 72)
 STA 8+535 TO 8+590 SOLID LT TO RT

TEMPORARY CROSSWALK MARKING, PAINT

STA 8+516 TO 8+524 RT (TH 75)
 STA 8+518 TO 8+533 LT (TH 72)
 STA 8+531 TO 8+533 RT TO LT

SPECIAL PROVISION
(DURABLE CROSSWALK MARKING, IMPRINTED/COLORIZED)

STA 8+516 TO 8+524 RT (TH 75)
 STA 8+518 TO 8+533 LT (TH 72)
 STA 8+531 TO 8+533 RT TO LT

CONSTRUCT SIDEWALK RAMP
W/DETECTABLE WARNING SURFACE (YELLOW)

STA 8+516 RT (TYPE 1) (TH 75)
 STA 8+518 LT (TYPE 6) (TH 72)
 STA 8+524 RT (TYPE 6) (TH 75)
 STA 8+531 RT (TYPE 2)
 STA 8+533 LT (TYPE 5) (TH 72)

TEMPORARY 600mm STOP BAR, PAINT
DURABLE 600mm STOP BAR, TYPE ITAPE

STA 8+513 RT
 STA 8+519 TO 8+526 LT (TH 72)
 STA 8+521 TO 8+524 RT (TH 75)
 STA 8+535 LT

TEMPORARY LETTER OR SYMBOL, PAINT

STA 8+483 RT - LEFT TURN ARROW
 STA 8+511 RT - LEFT TURN ARROW
 STA 8+521 LT - RIGHT TURN ARROW (TH 72)
 STA 8+521 LT - THROUGH ARROW (TH 72)
 STA 8+524 LT - LEFT TURN ARROW (TH 72)

DURABLE LETTER OR SYMBOL, TYPE ITAPE

STA 8+483 RT - LEFT TURN ARROW
 STA 8+497 RT - "ONLY"
 STA 8+511 RT - LEFT TURN ARROW
 STA 8+521 LT - RIGHT TURN ARROW (TH 72)
 STA 8+521 LT - THROUGH ARROW (TH 72)
 STA 8+524 LT - LEFT TURN ARROW (TH 72)

REHAB. DROP INLETS, CATCH BASINS
OR MANHOLES, CLASS 1

STA 8+510 LT (CB)

CHANGING ELEVATION OF DROP INLETS,
CATCH BASINS, OR MANHOLES

STA 8+432 RT (CB)
 STA 8+477 RT (CB)
 STA 8+496 RT (CB)
 STA 8+512 RT (CB)
 STA 8+527 RT (CB) - DID NOT TOUCH
 STA 8+535 LT (CB)

CHANGING ELEVATION OF SEWER MANHOLES


STA 8+533 RT
 STA 8+529 LT
 ADJUST ELEVATION OF VALVE BOX

STA 8+518 LT
 STA 8+523 LT
 STA 8+529 LT
 STA 8+522 LT
 REMOVING SIGNS

AS SHOWN - 6

ERECTING SALVAGED SIGNS

AS SHOWN - 4

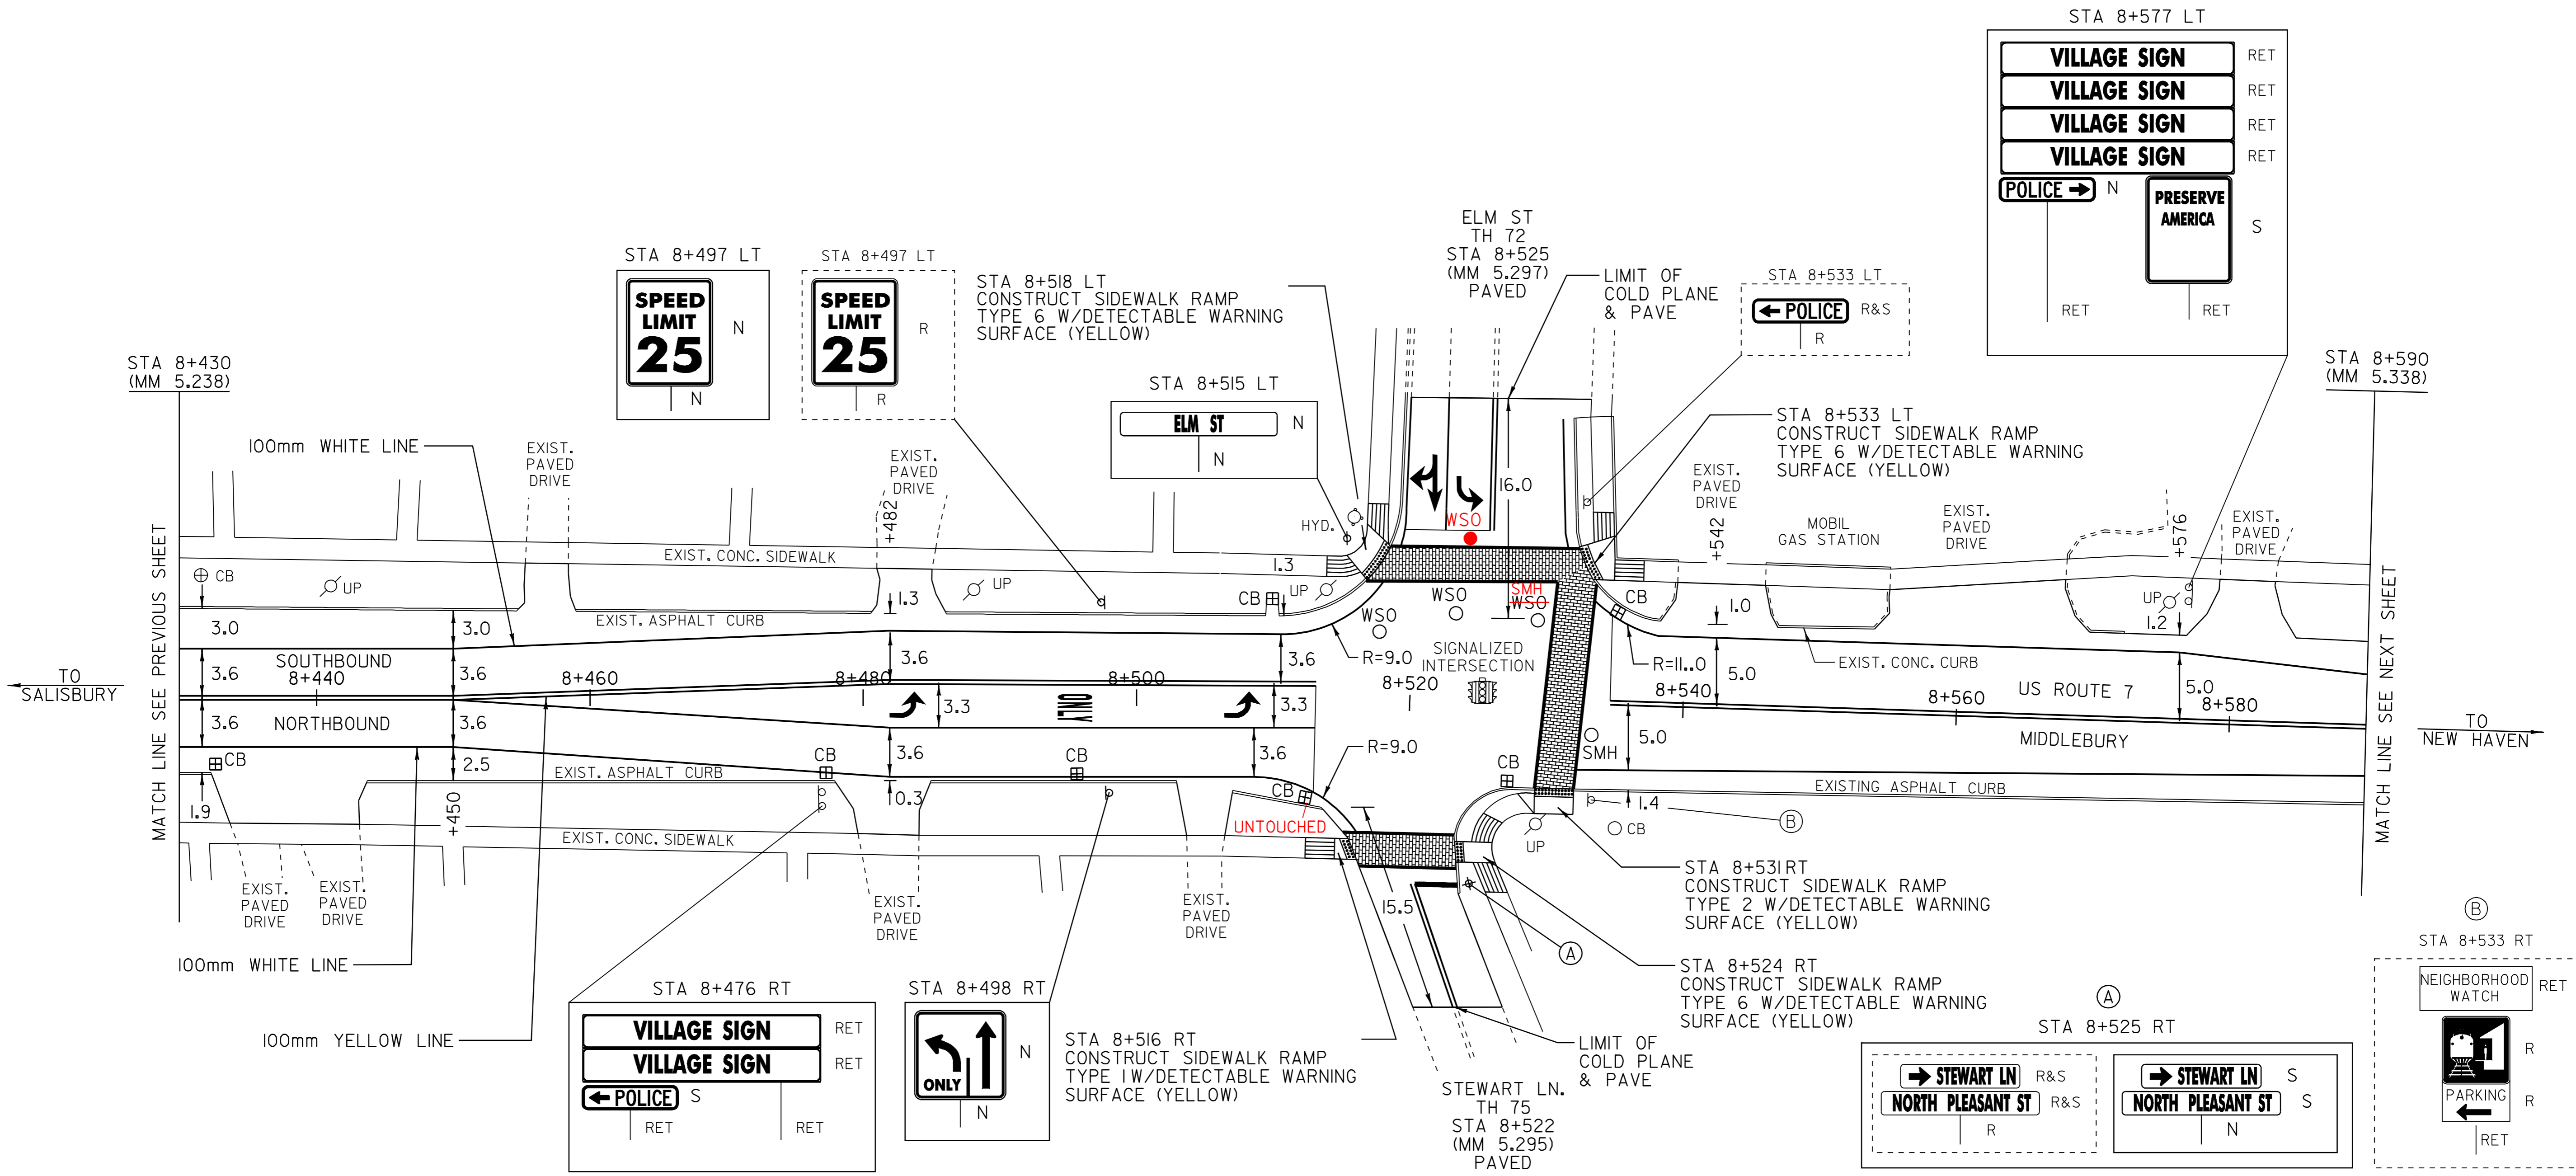

LEGEND

- R = REMOVE EXISTING
- S = SALVAGE
- R&S = REMOVE AND SALVAGE
- N = NEW
- RET = RETAIN
- B-B = BACK TO BACK

PAVING LAYOUT II

PROJECT NAME: MIDDLEBURY	FILE NAME: /pave/06b032/p06b032.dgn	PLOT DATE: 06-OCT-2008 13:1
PROJECT NUMBER: NH 2603(I)S	PROJECT LEADER: PTS	DRAWN BY: MRS
	DESIGNED BY: NLL	CHECKED BY: NLL
	IPARM FILE NAME: p06b0321all.I	SHEET 79 OF 103

NOT TO SCALE

NOTE: ALL DIMENSIONS IN METERS EXCEPT AS INDICATED