


TEMPORARY 100mm WHITE LINE, PAINT
 DURABLE 100mm WHITE LINE, THERMOPLASTIC
 STA 8+750 TO 8+920 SOLID LT & RT

TEMPORARY 100mm YELLOW LINE, PAINT
 DURABLE 100mm YELLOW LINE, THERMOPLASTIC
 STA 8+750 TO 8+920 SOLID LT & RT




REHAB. DROP INLETS,
 CATCH BASINS, OR MANHOLES, CLASS I
 STA 8+840 LT
 CHANGING ELEVATION OF SEWER MANHOLES
 STA 8+899 RT

BITUMINOUS CONCRETE GUTTERS AND TRAFFIC ISLANDS
 STA 8+840 TO 8+920 LT
 REMOVING SIGNS
 AS SHOWN - 5

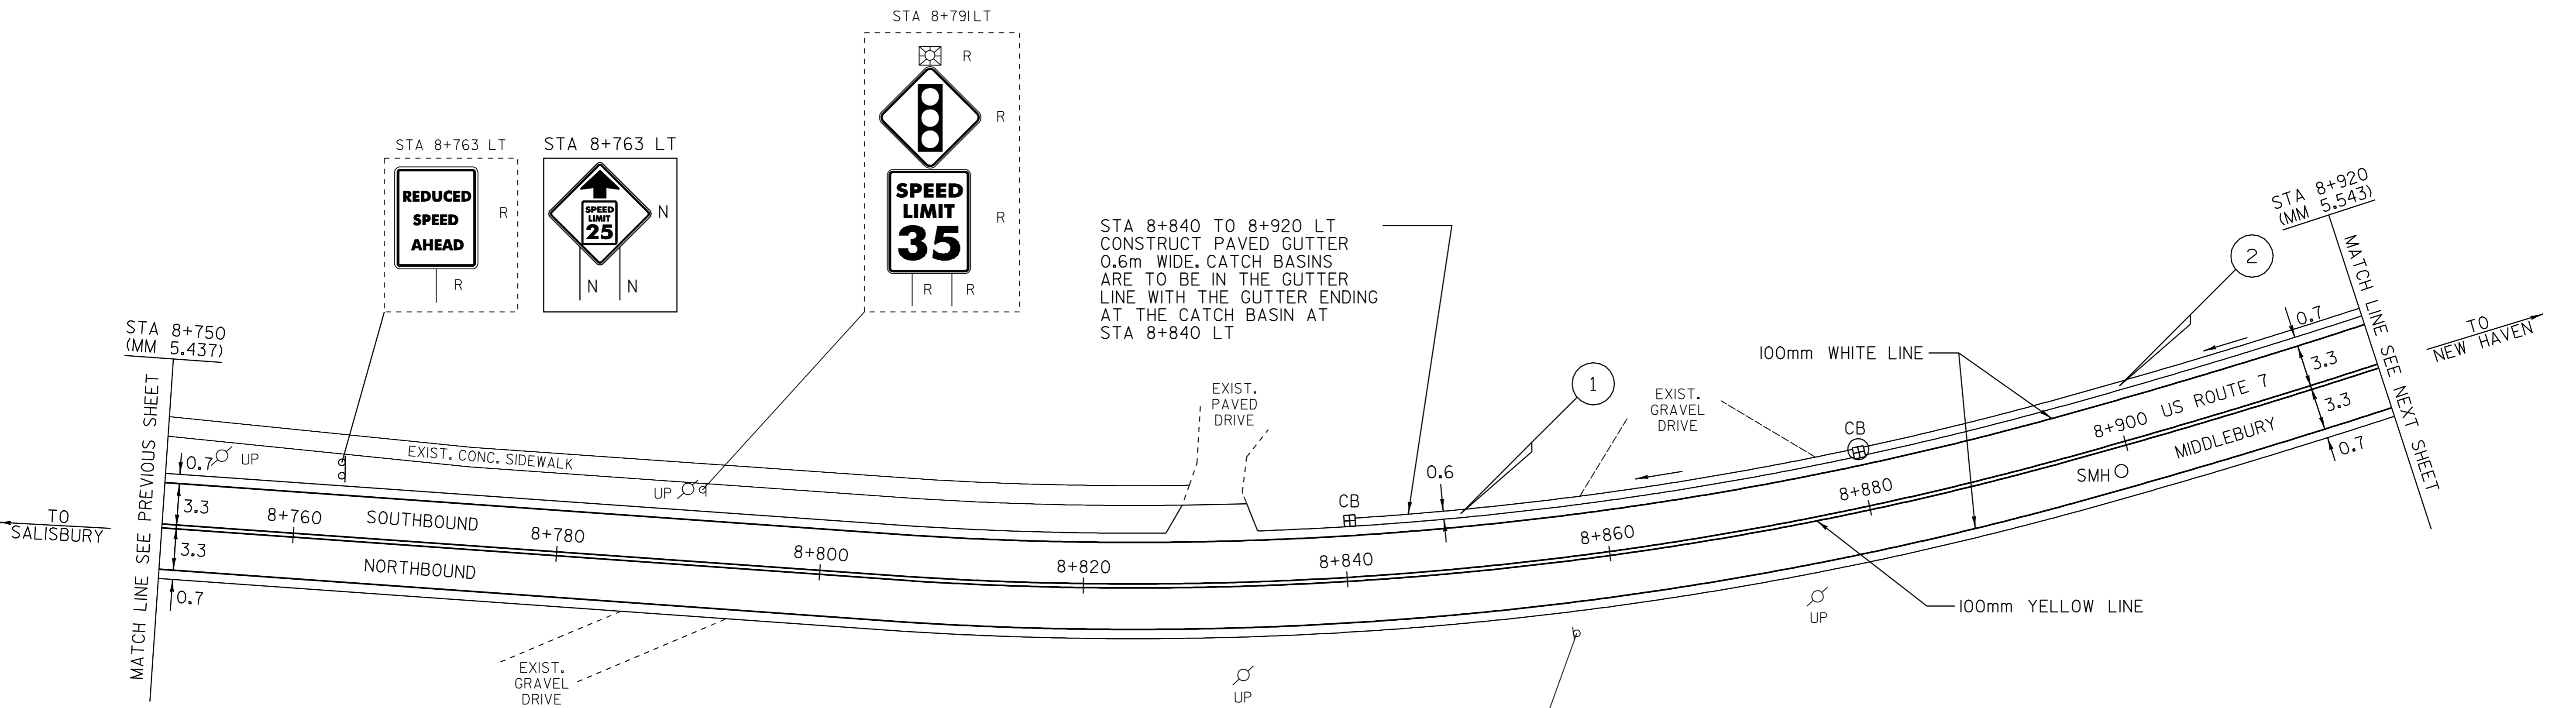

STA 8+840 TO 8+920 LT
 CONSTRUCT PAVED GUTTER
 0.6m WIDE. CATCH BASINS
 ARE TO BE IN THE GUTTER
 LINE WITH THE GUTTER
 ENDING AT THE CATCH BASIN AT
 STA 8+840 LT

- ① ^{375mm}
 STA 8+840 TO 8+880 LT
 NEW ~~450mm~~ x 37.7 m CSP (1.63)
 OR PCCSP (1.63) OR RCP CLASS III OR CPEP (SL)
 NEW 1.2 m PRCCB W/CIGRATE, TYPE E AT STA 8+880 LT
 CONNECT TO EXISTING CB AT 8+840 LT
- ② ^{375mm}
 STA 8+880 TO 8+935 LT
 NEW ~~450mm~~ x 53.2 m CSP (1.63)
 OR PCCSP (1.63) OR RCP CLASS III OR CPEP (SL)
 NEW 1.2 m PRCCB W/CIGRATE, TYPE E AT STA 8+935 LT

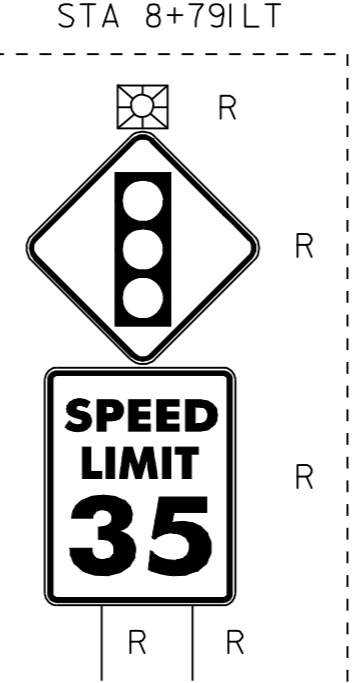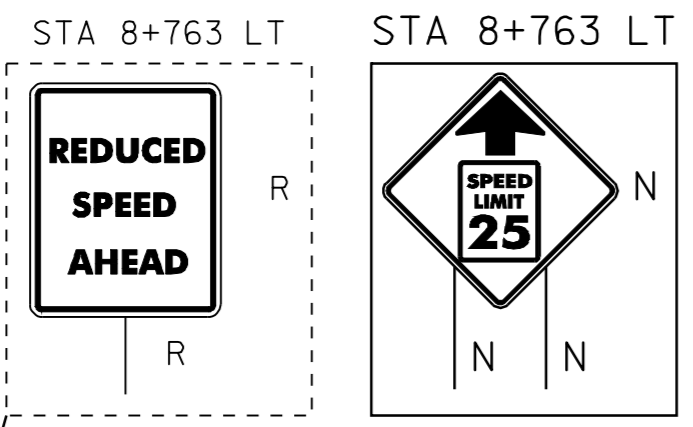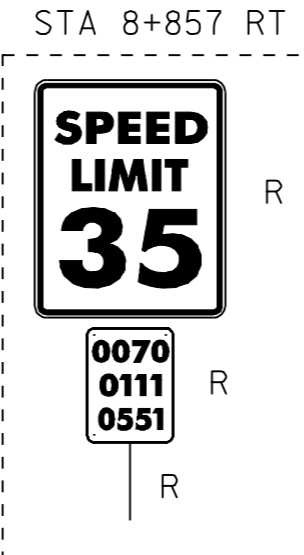

LEGEND

R	=	REMOVE EXISTING
S	=	SALVAGE
R&S	=	REMOVE AND SALVAGE
N	=	NEW
RET	=	RETAIN
B-B	=	BACK TO BACK

PROJECT NAME: MIDDLEBURY	
PROJECT NUMBER: NH 2603(IIS)	
FILE NAME: /pave/06b032/p06b032.dgn	PLOT DATE: 06-OCT-2008 13:1
PROJECT LEADER: PTS	DRAWN BY: MRS
DESIGNED BY: NLL	CHECKED BY: NLL
IPARM FILE NAME: p06b032la3.i	SHEET 81 OF 103

NOT TO SCALE

NOTE: ALL DIMENSIONS IN METERS EXCEPT AS INDICATED

PAVING LAYOUT 13