


TEMPORARY 100mm WHITE LINE, PAINT
 DURABLE 100mm WHITE LINE, THERMOPLASTIC
 STA 9+090 TO 9+137 SOLID LT & RT

TEMPORARY 100mm YELLOW LINE, PAINT
 DURABLE 100mm YELLOW LINE, THERMOPLASTIC
 STA 9+090 TO 9+137 SOLID LT & RT

BITUMINOUS CONCRETE GUTTERS AND TRAFFIC ISLANDS
 STA 9+090 TO ~~9+133~~ LT
~~9+105~~ LT
 THINNING AND TRIMMING FOR SIGNS
 STA 9+111 RT
 SEE DEATIL SHEET 101



**US ROUTE 7
 STA 9+136.25
 (MM 5.677)
 END PROJECT
 NH 2603(1)S**

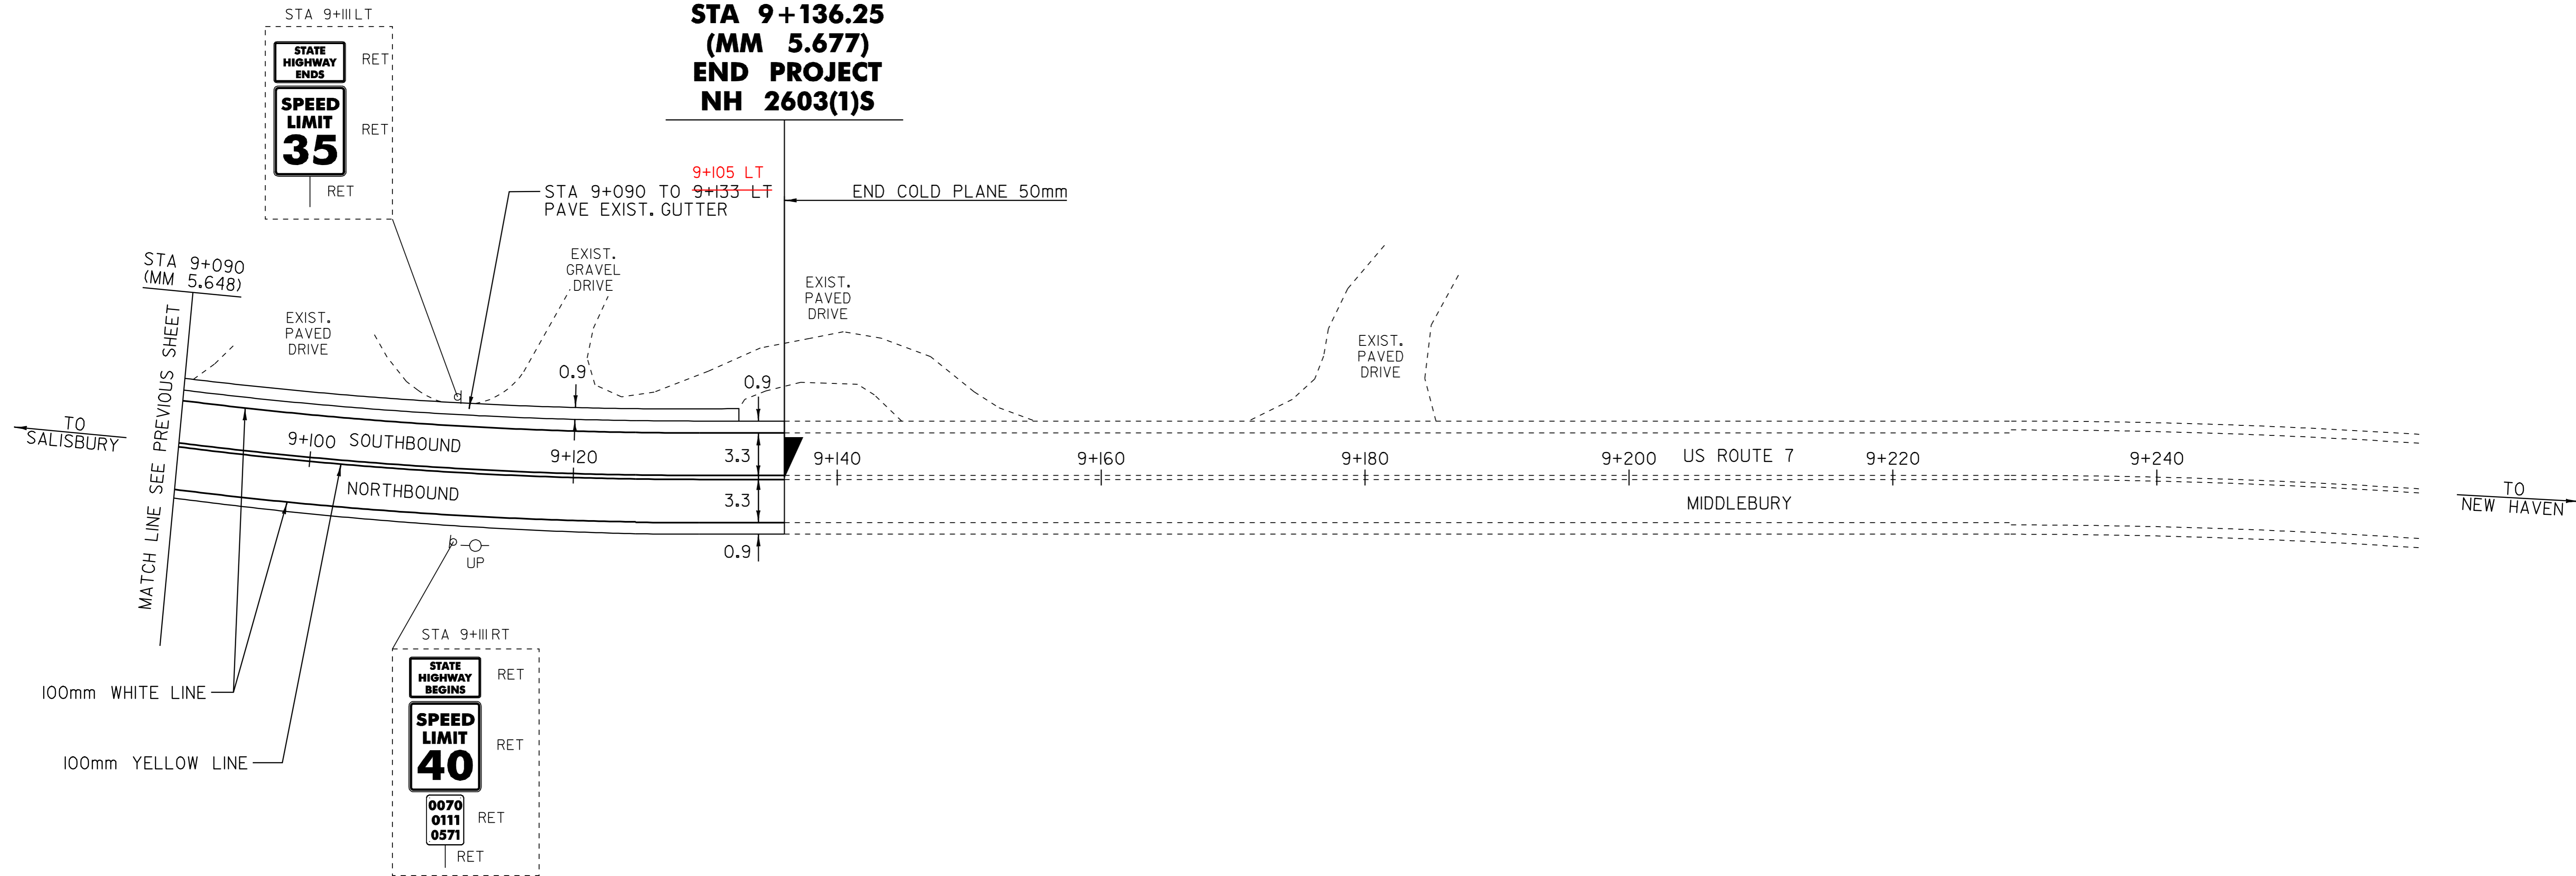

LEGEND

- R = REMOVE EXISTING
- S = SALVAGE
- R&S = REMOVE AND SALVAGE
- N = NEW
- RET = RETAIN
- B-B = BACK TO BACK

PAVING LAYOUT 15

PROJECT NAME:	MIDDLEBURY	FILE NAME:	/pave/06b032/p06b032.dgn	PLOT DATE:	06-OCT-2008 13:1
PROJECT NUMBER:	NH 2603(1)S	PROJECT LEADER:	PTS	DRAWN BY:	MRS
		DESIGNED BY:	NLL	CHECKED BY:	NLL
		IPARM FILE NAME:	p06b0321a15.1	SHEET	83 OF 103

NOT TO SCALE

NOTE: ALL DIMENSIONS IN METERS EXCEPT AS INDICATED