

CONSTRUCT DRIVES

STA 17+530.0 LT - 11.0 m WIDE, COLORED STONE-COMM.
 STA 17+570.0 LT - 10.5 m WIDE, COLORED STONE-COMM.
 STA 17+620.0 RT - 12.0 m WIDE, PAVED-COMM.
 STA 1+040.0 RT - 6.0 m WIDE, GRAVEL-COMM.
 STA 1+060.0 LT - 12.0 m WIDE, PAVED-COMM.


REMOVING AND RESETTING FENCE

STA 17+580.0 - 17+588.4 LT
 STA 1+034.5 - 1+036.5 RT
 STA 1+043.2 - 1+047.5 RT

SPECIAL PROVISION (REMOVE AND RESET COMMERCIAL SIGN)

STA 17+633 RT	
EXISTING	PROPOSED
IP 17+588.534	IP 17+588.972
9.577 m (31.42') LT	10.973 m (36.00') LT

BEGIN MAINT. AGREE ZONE #2
 17+556.230, 7.545 m (24.76') RT =
 T.H. 8 1+007.545 CL

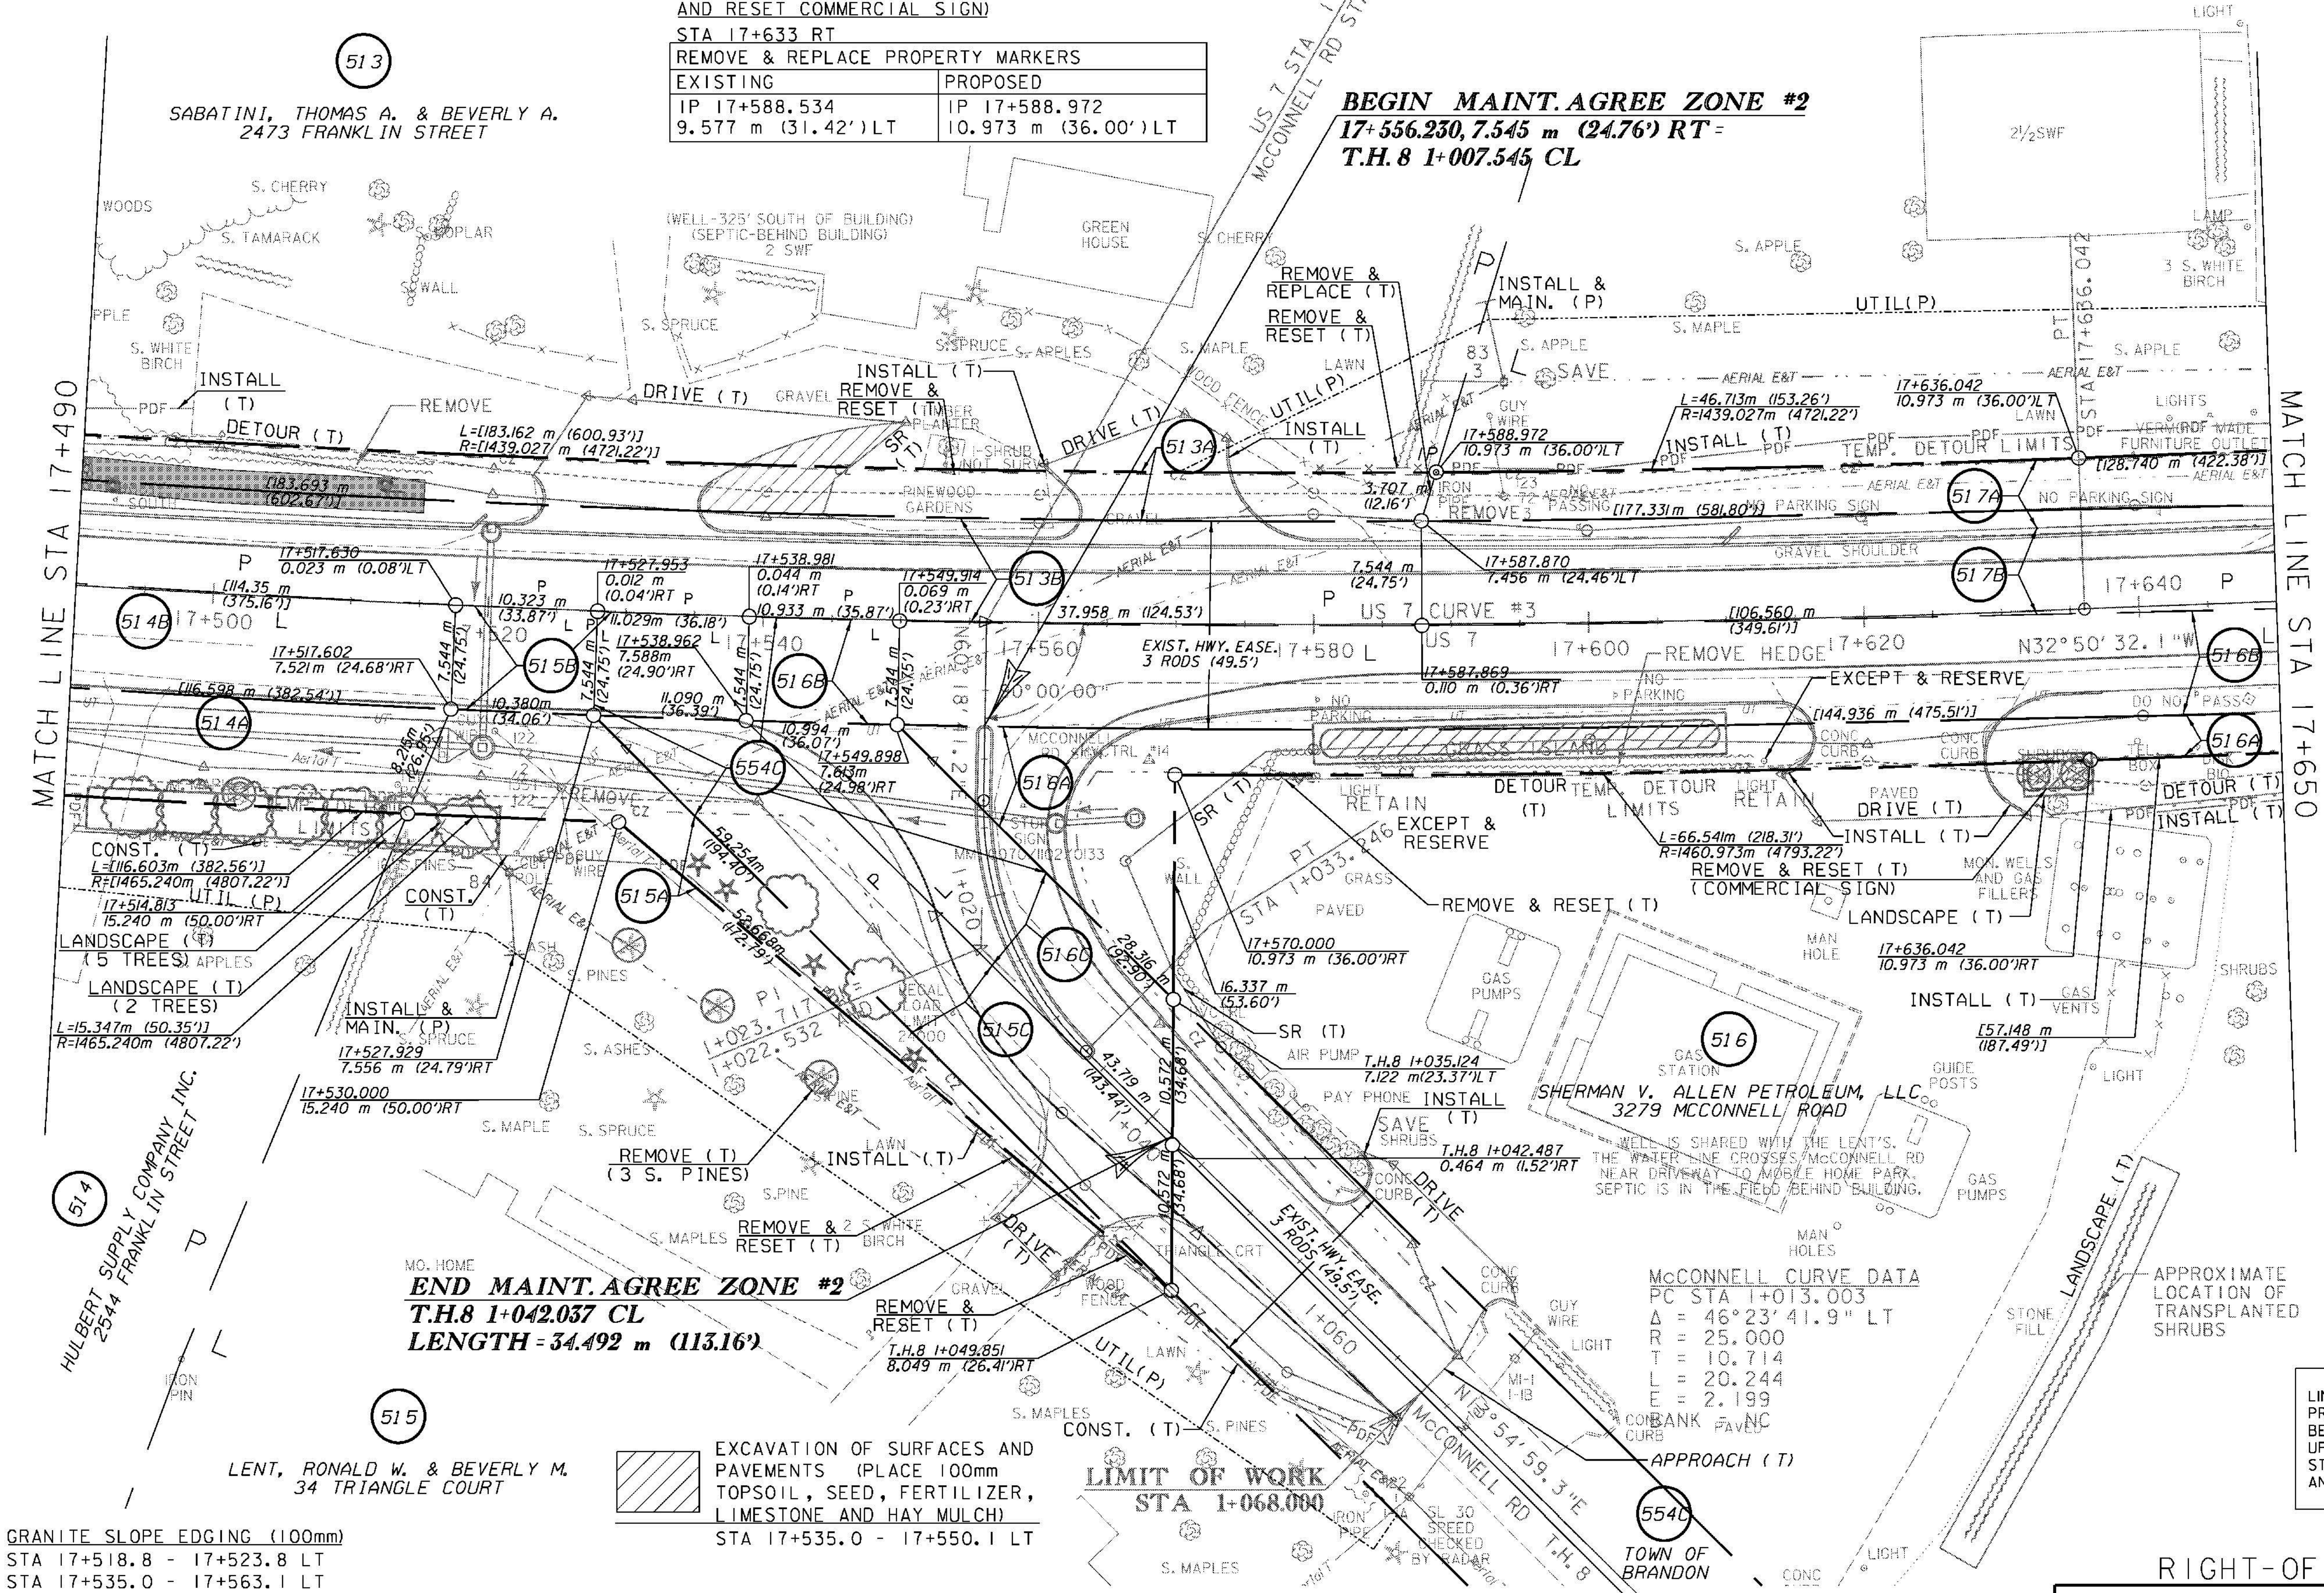

MATCH LINE STA 17+490

MATCH LINE STA 17+650

513
 SABATINI, THOMAS A. & BEVERLY A.
 2473 FRANKLIN STREET

517
 MARKOWSKI, GREGORY F. & LINDA B.
 2417 FRANKLIN STREET

515
 LENT, RONALD W. & BEVERLY M.
 34 TRIANGLE COURT

516
 SHERMAN V. ALLEN PETROLEUM, LLC
 3279 MCCONNELL ROAD

514
 HULBERT SUPPLY COMPANY, INC.
 2514 FRANKLIN STREET

554C
 EXCAVATION OF SURFACES AND PAVEMENTS (PLACE 100mm TOPSOIL, SEED, FERTILIZER, LIMESTONE AND HAY MULCH)
 STA 17+535.0 - 17+550.1 LT

554C
 LIMIT OF WORK
 STA 1+068.000


516
 MCCONNELL CURVE DATA
 PC STA 1+013.003
 Δ = 46°23'41.9" LT
 R = 25.000
 T = 10.714
 L = 20.244
 E = 2.199

516
 APPROXIMATE LOCATION OF TRANSPLANTED SHRUBS

GRANITE SLOPE EDGING (100mm)

STA 17+518.8 - 17+523.8 LT
 STA 17+535.0 - 17+563.1 LT
 STA 17+568.3 - 17+616.2 RT
 STA 17+573.6 - 17+583.3 LT
 STA 17+628.4 - 17+637.1 RT
 STA 1+007.5 - 1+033.8 LT & RT (MCCONNELL ROAD) (ISLAND)
 STA 1+007.3 - 1+054.9 LT (MCCONNELL ROAD)

554C
 BITUMINOUS CONCRETE GUTTERS AND TRAFFIC ISLANDS
 STA 1+007.5 - 1+033.8 LT & RT (MCCONNELL ROAD) (ISLAND)

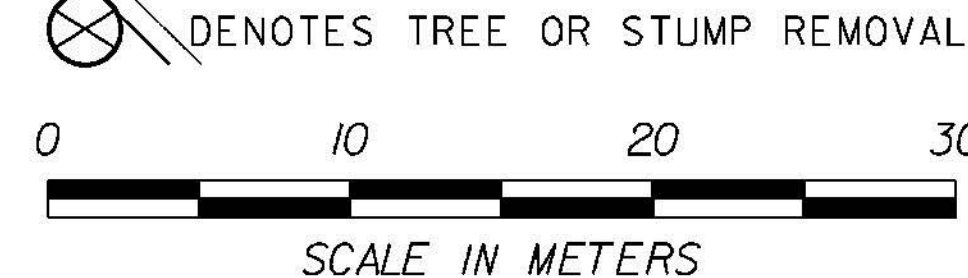

RIGHT-OF-WAY LAYOUT 8	
PROJECT NAME: BRANDON	PLOT DATE: 9/3/2009
PROJECT NUMBER: NH 019-3(495)	DRAWN BY: JCS
FILE NAME: zb008s5-ROW08.dgn	CHECKED BY: PTS
PROJECT LEADER: CRB	SHEET 43 OF 546
DESIGNED BY: PTS	
ROW SHEET 28 OF 164	