

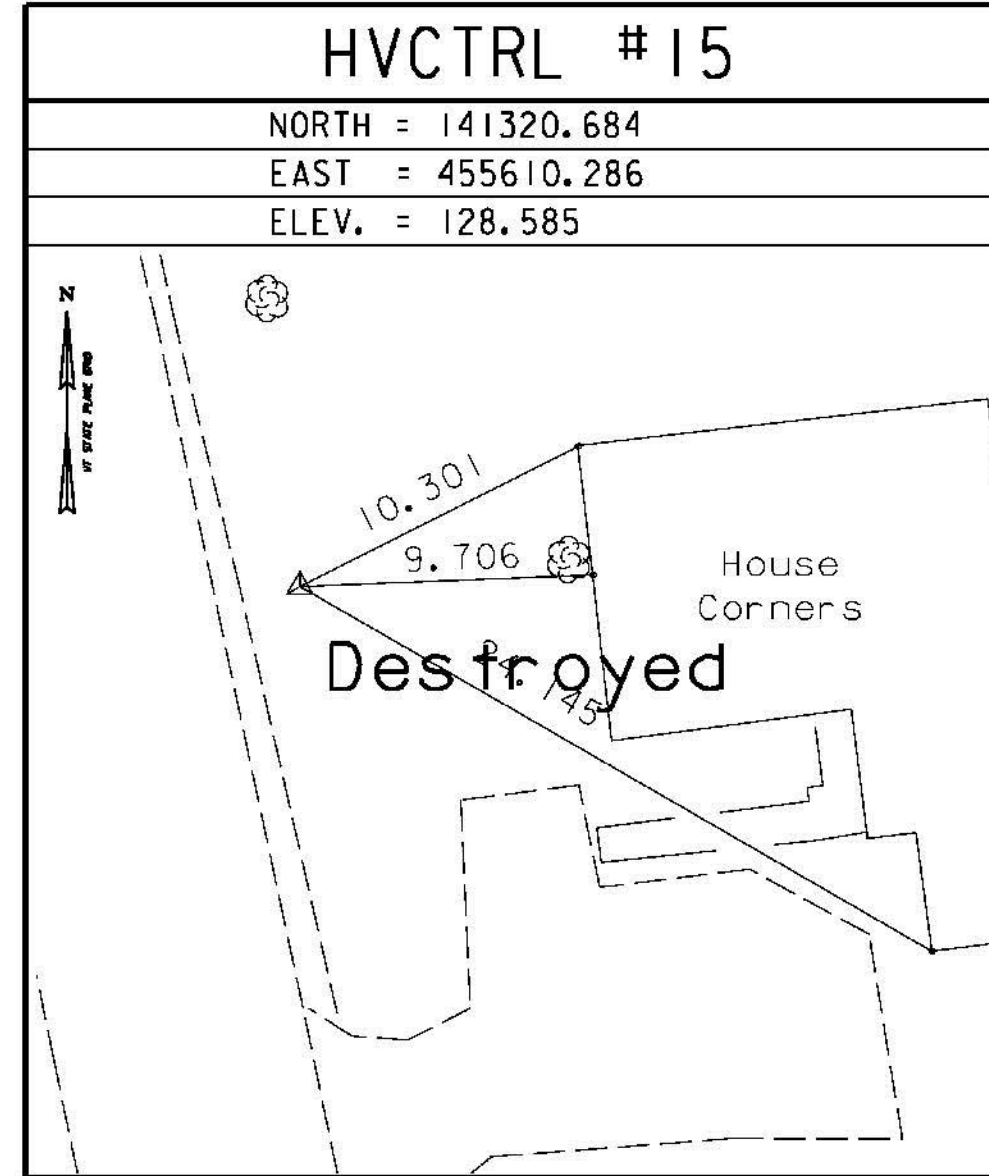
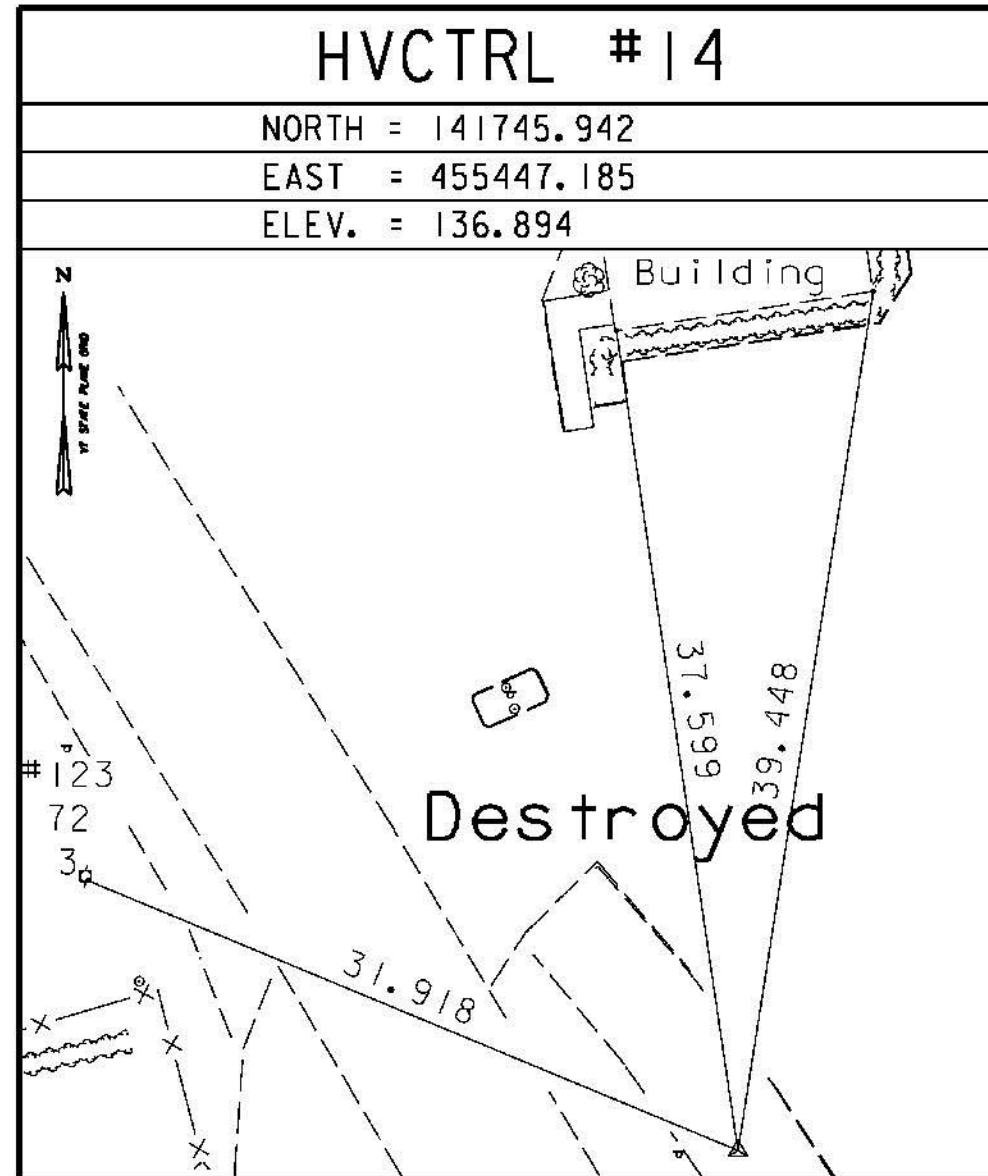







TRAVERSE TIES

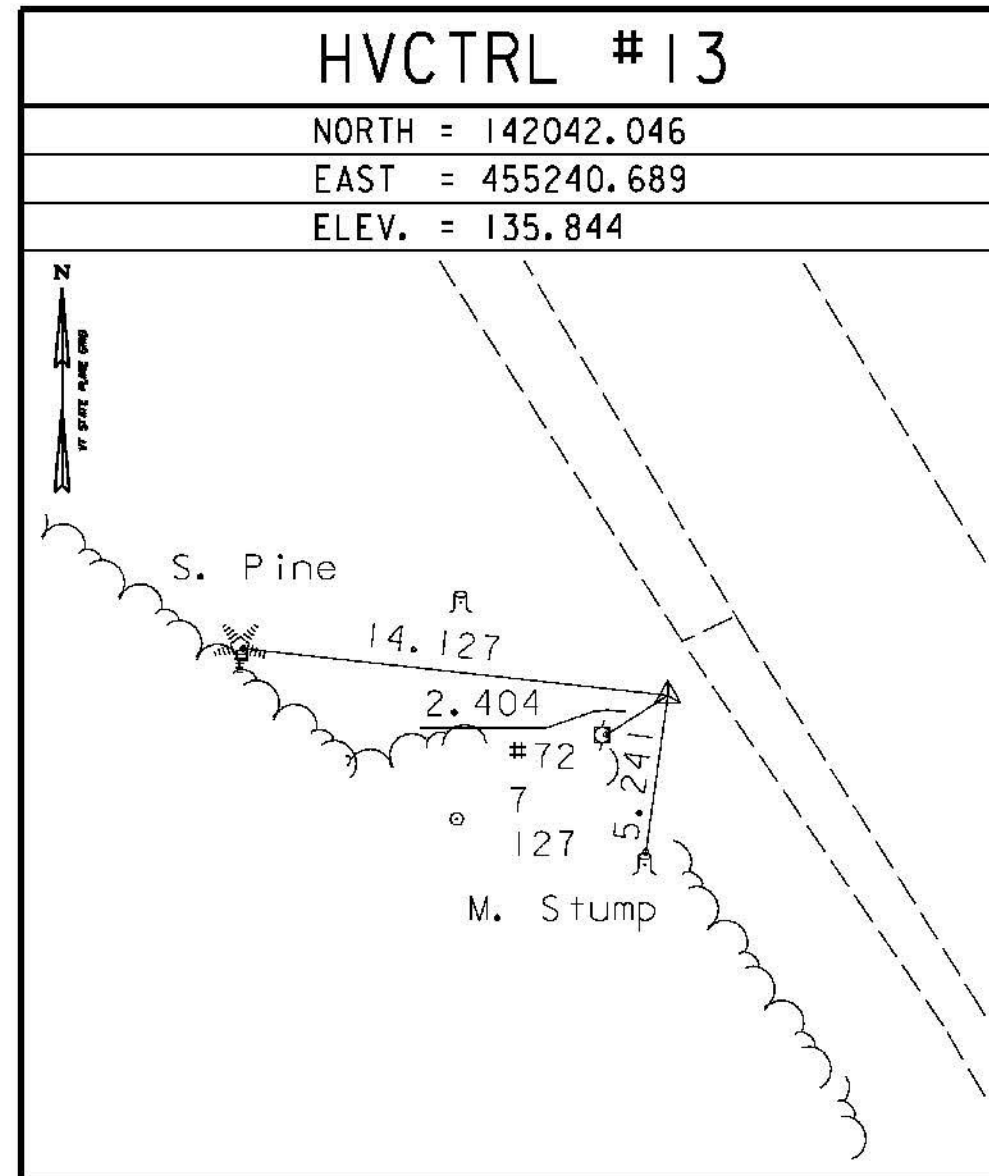

ALIGNMENT TIES





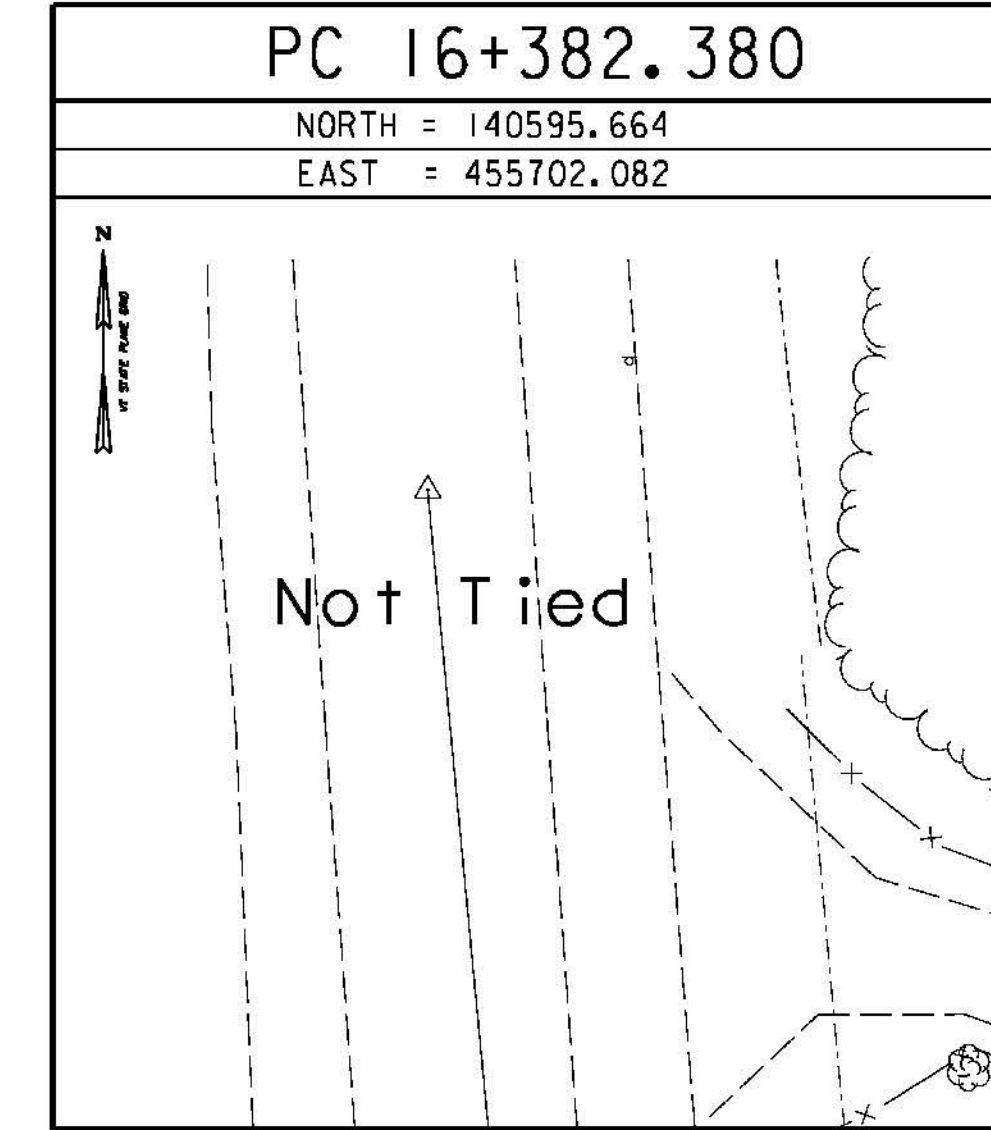


ALIGNMENT TIES

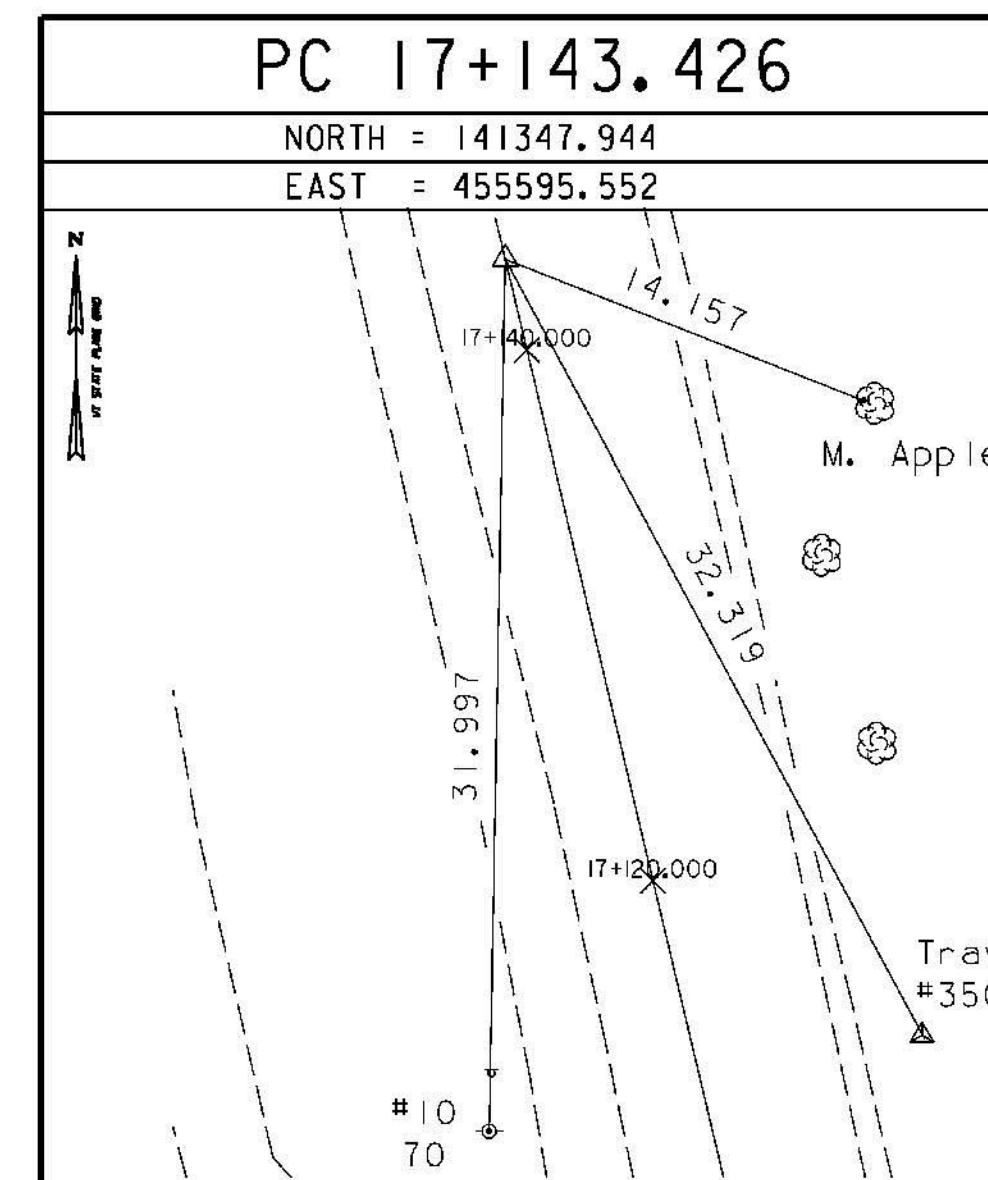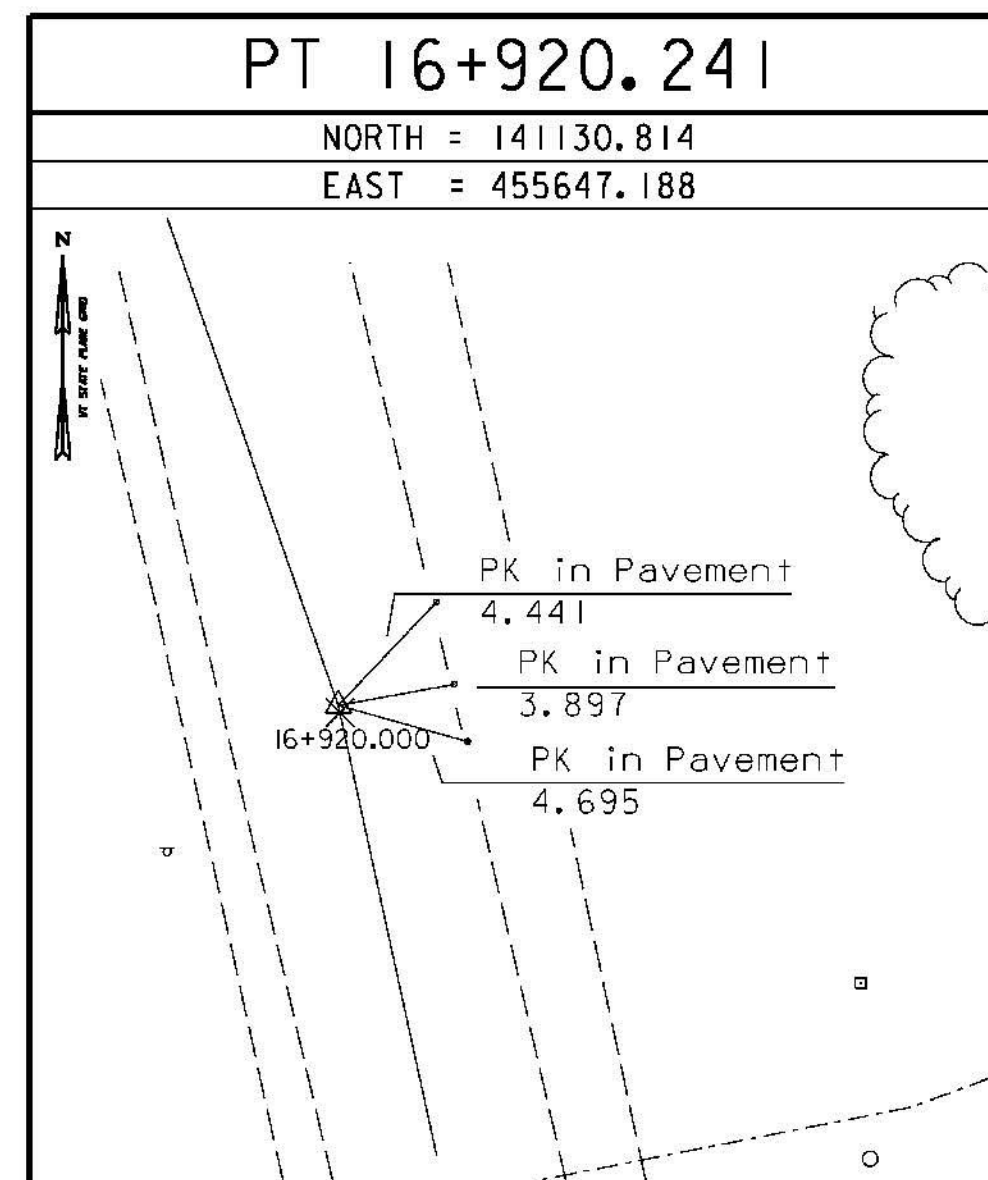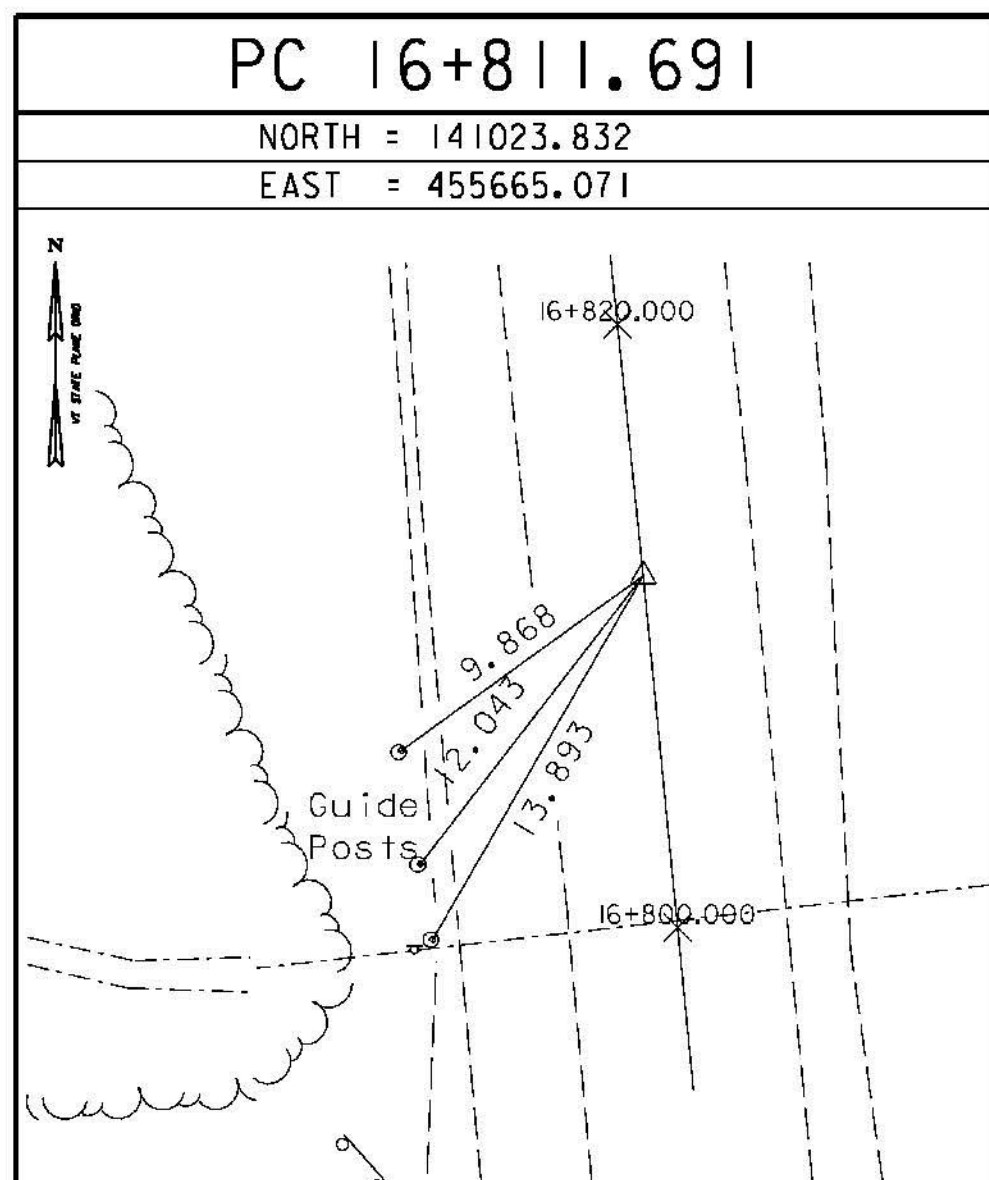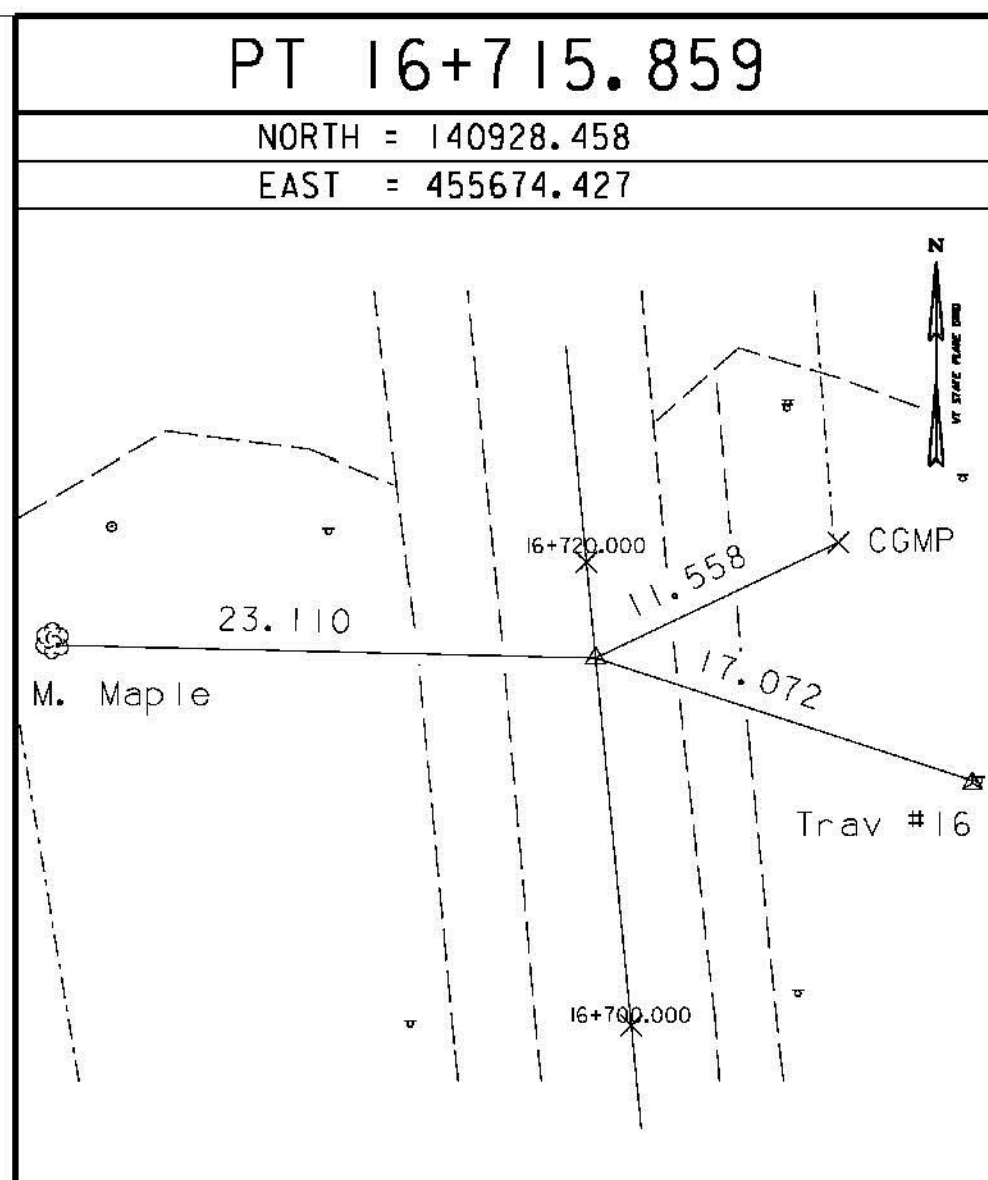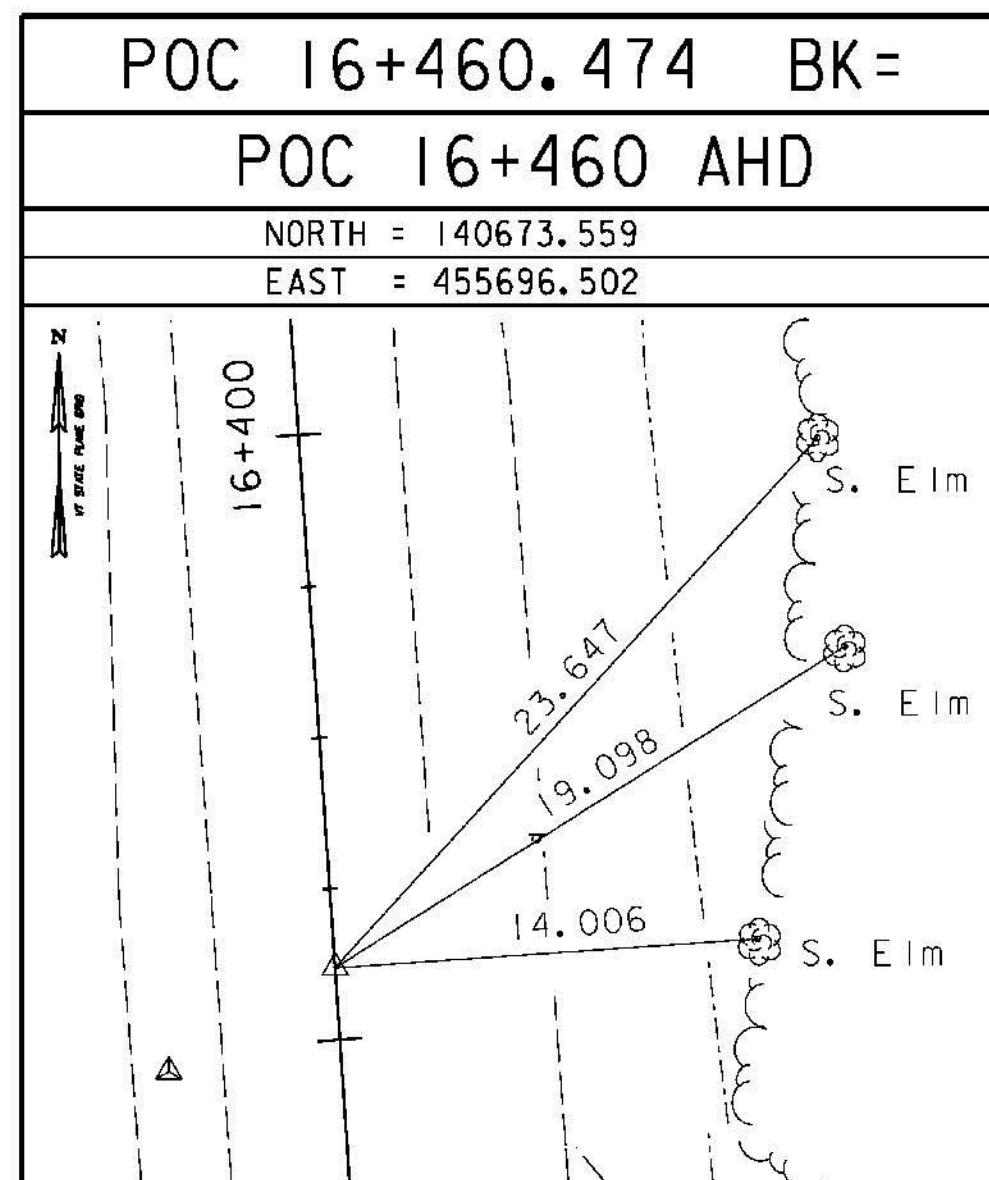

\* Alignment Staked 08/05/03 by L/ Orvis P.C. & J. Hulett & B. Farley

ALIGNMENT TIES

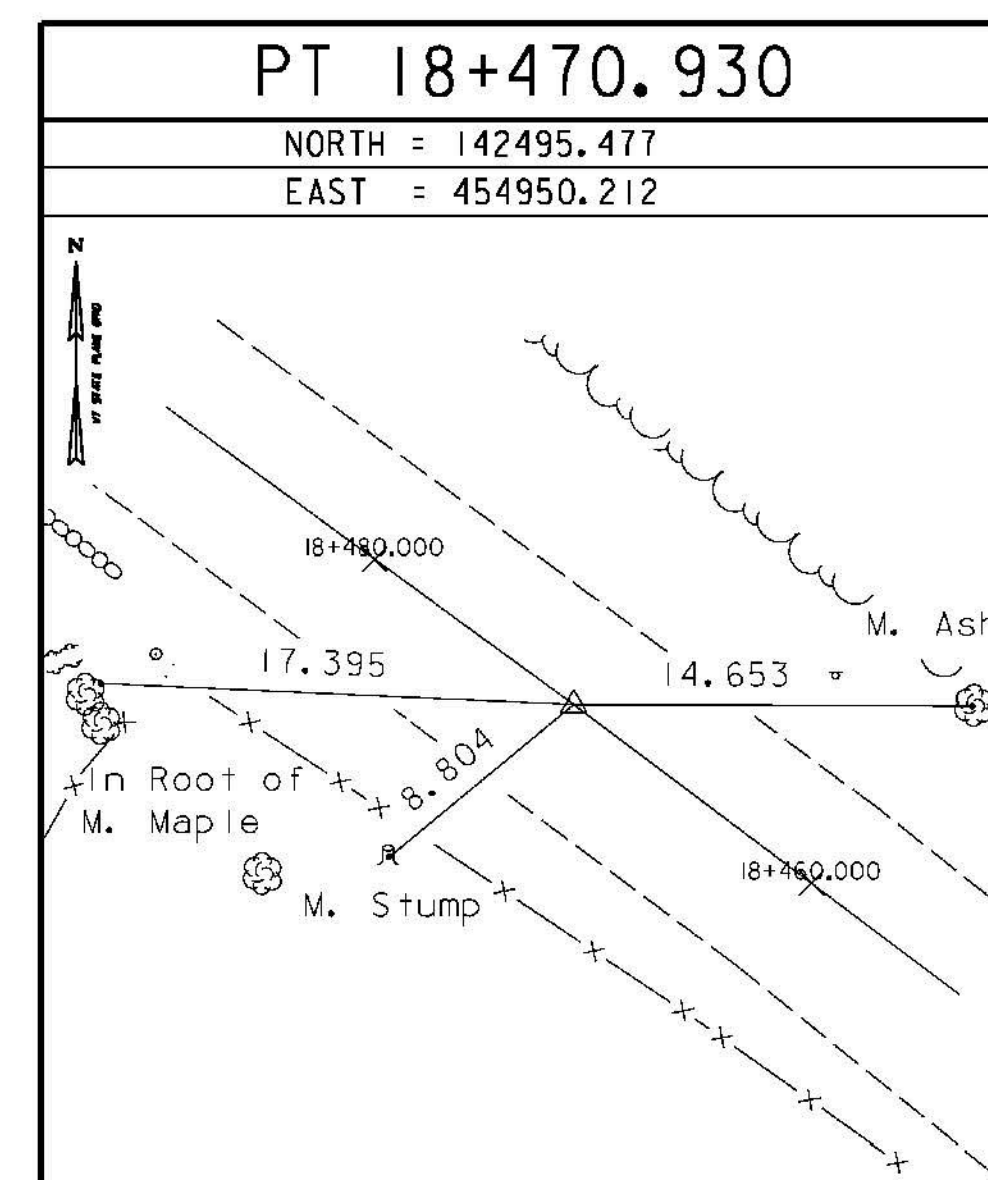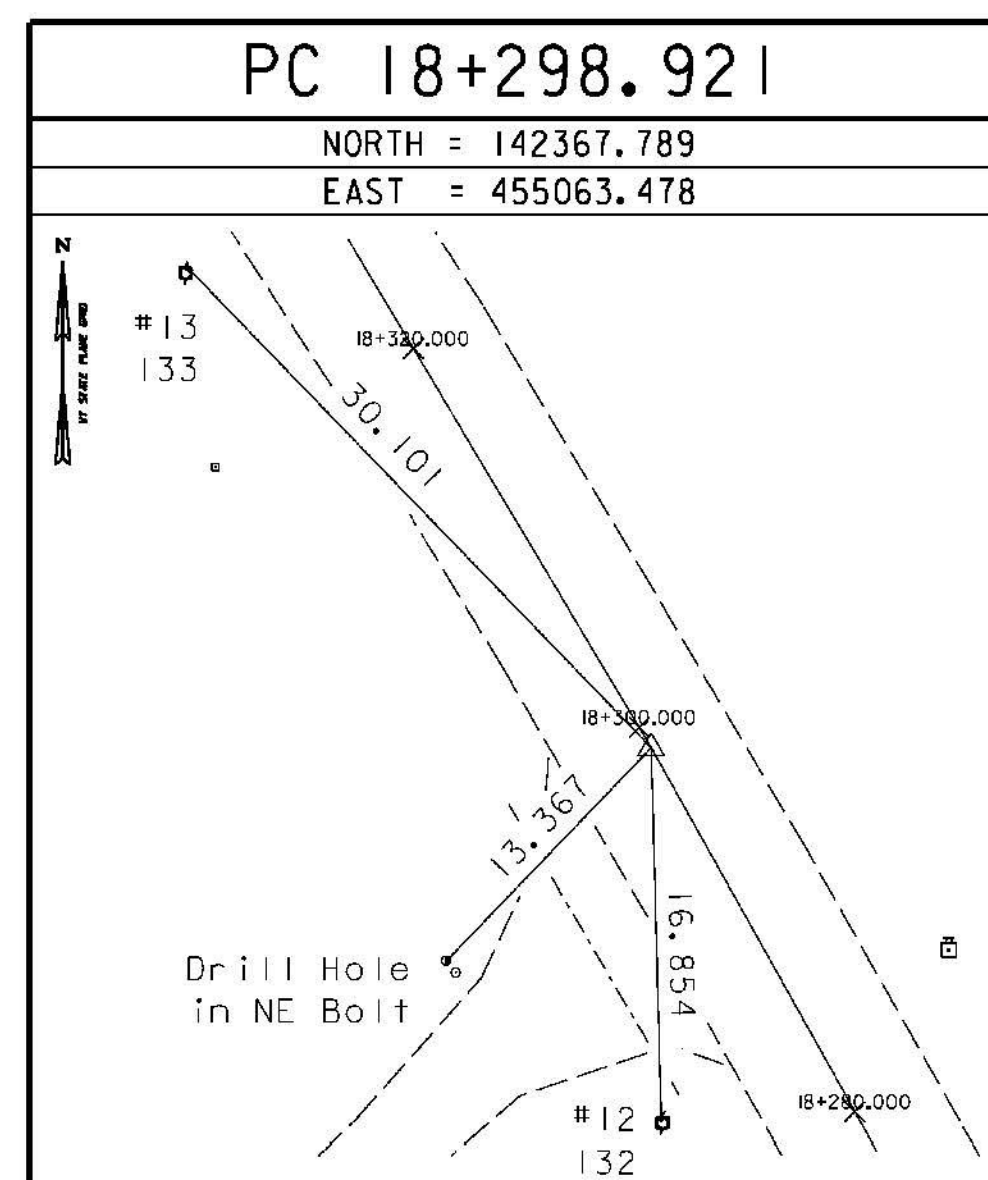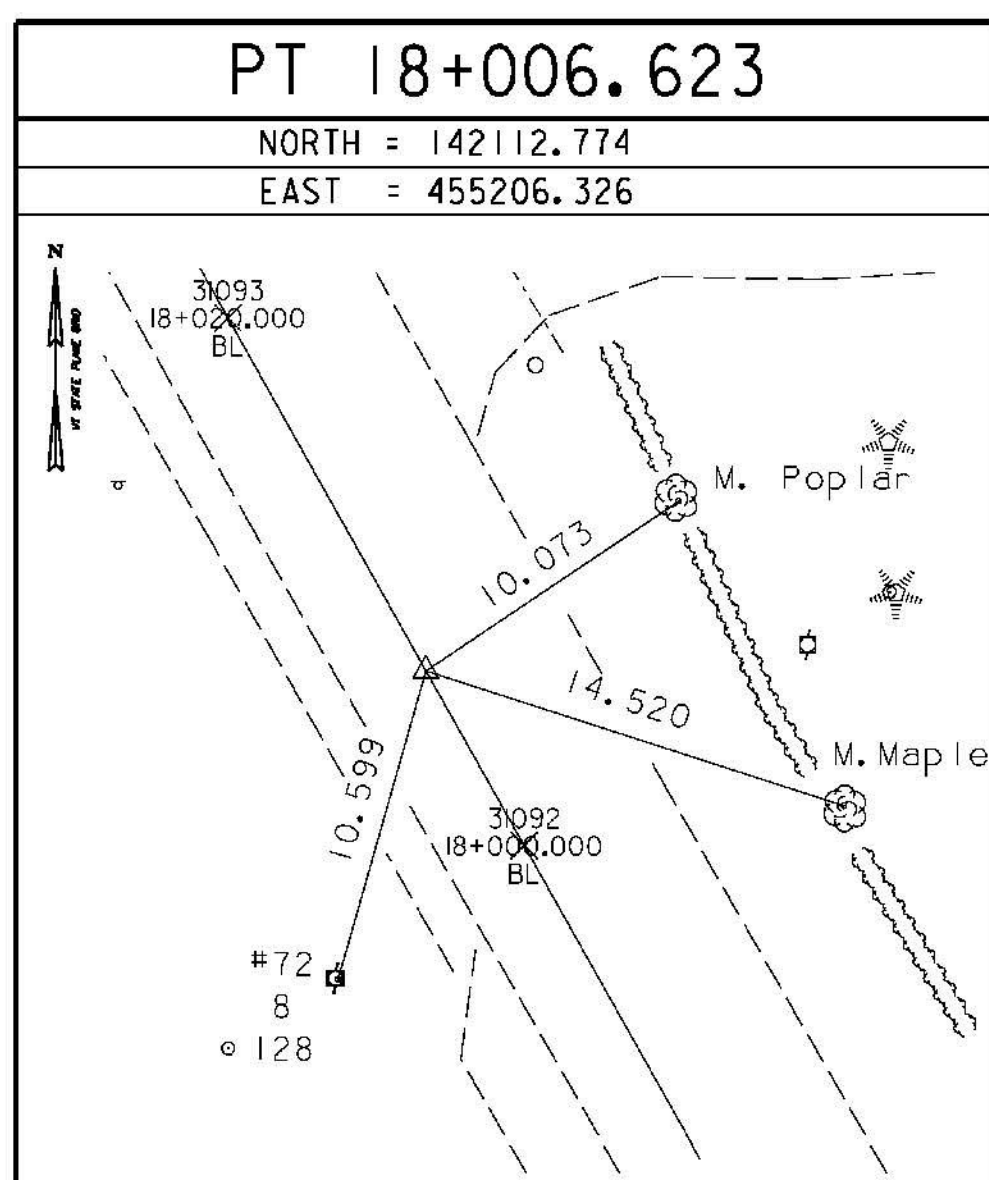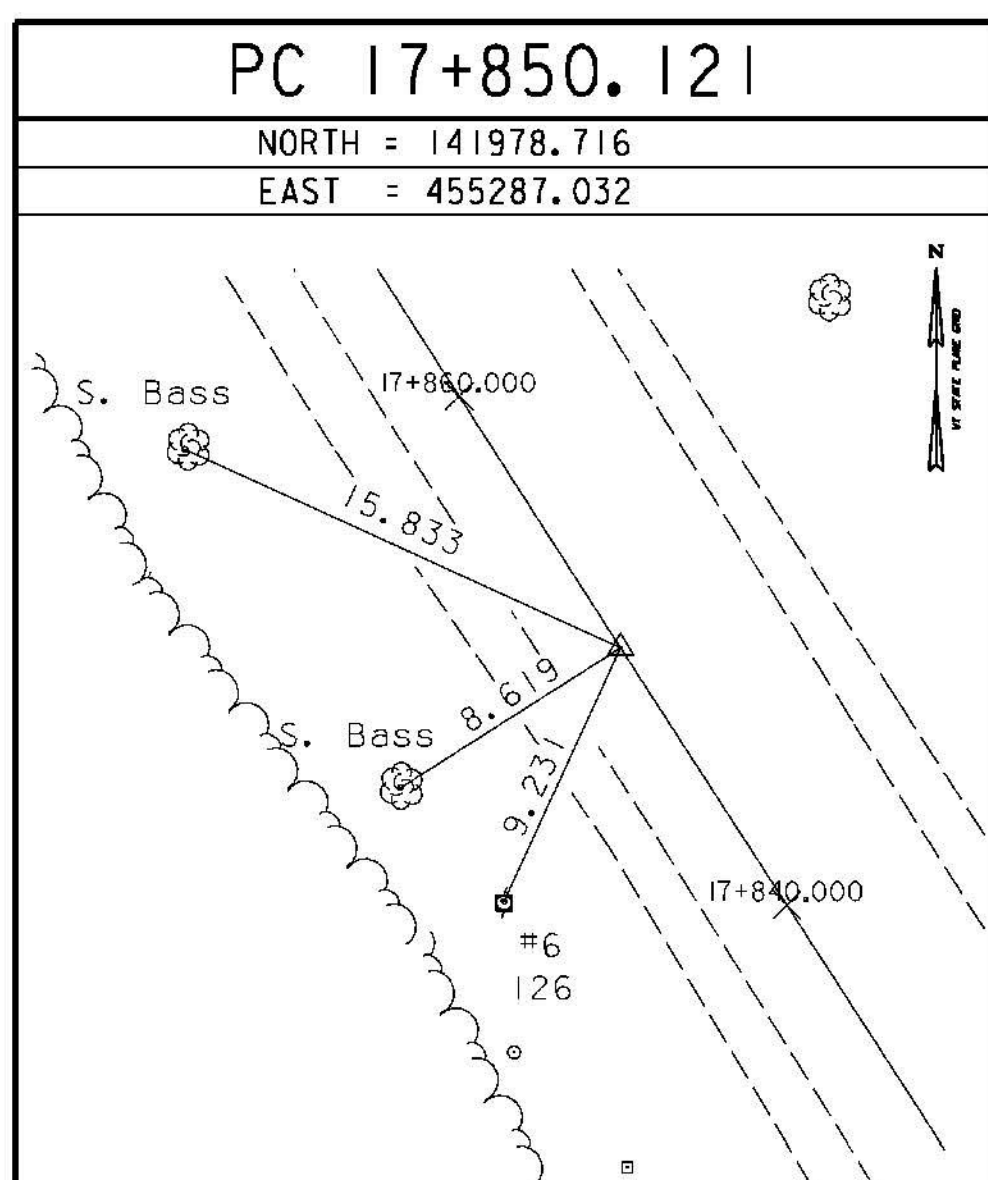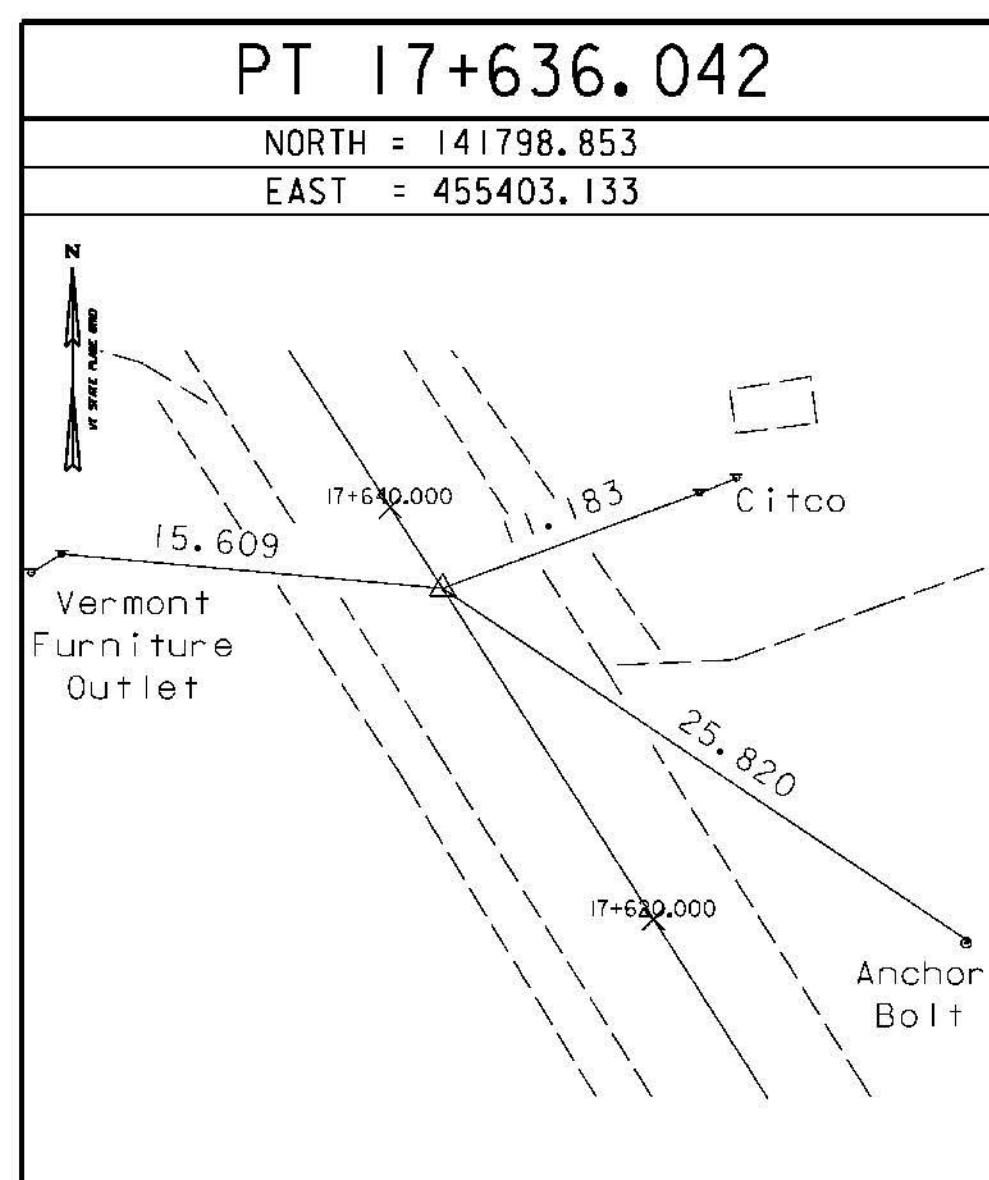

TIE SHEET

<b>DATUM</b>	
VERTICAL	NAVD 88
HORIZONTAL	NAD 83/92
ADJUSTMENT	Least Squares

PROJECT NAME:	BRANDON	PLOT DATE:	9/3/2009
PROJECT NUMBER:	NH 019-3(495)	DRAWN BY:	R. Bullock
FILE NAME:	x85b008s5-t102.dgn	CHECKED BY:	VTRANS
PROJECT LEADER:	VAOT	SHEET	66 OF 546
DESIGNED BY:	VTRANS		
CLD 02-0149			

NOTE: ALL TIE DISTANCES IN METERS