

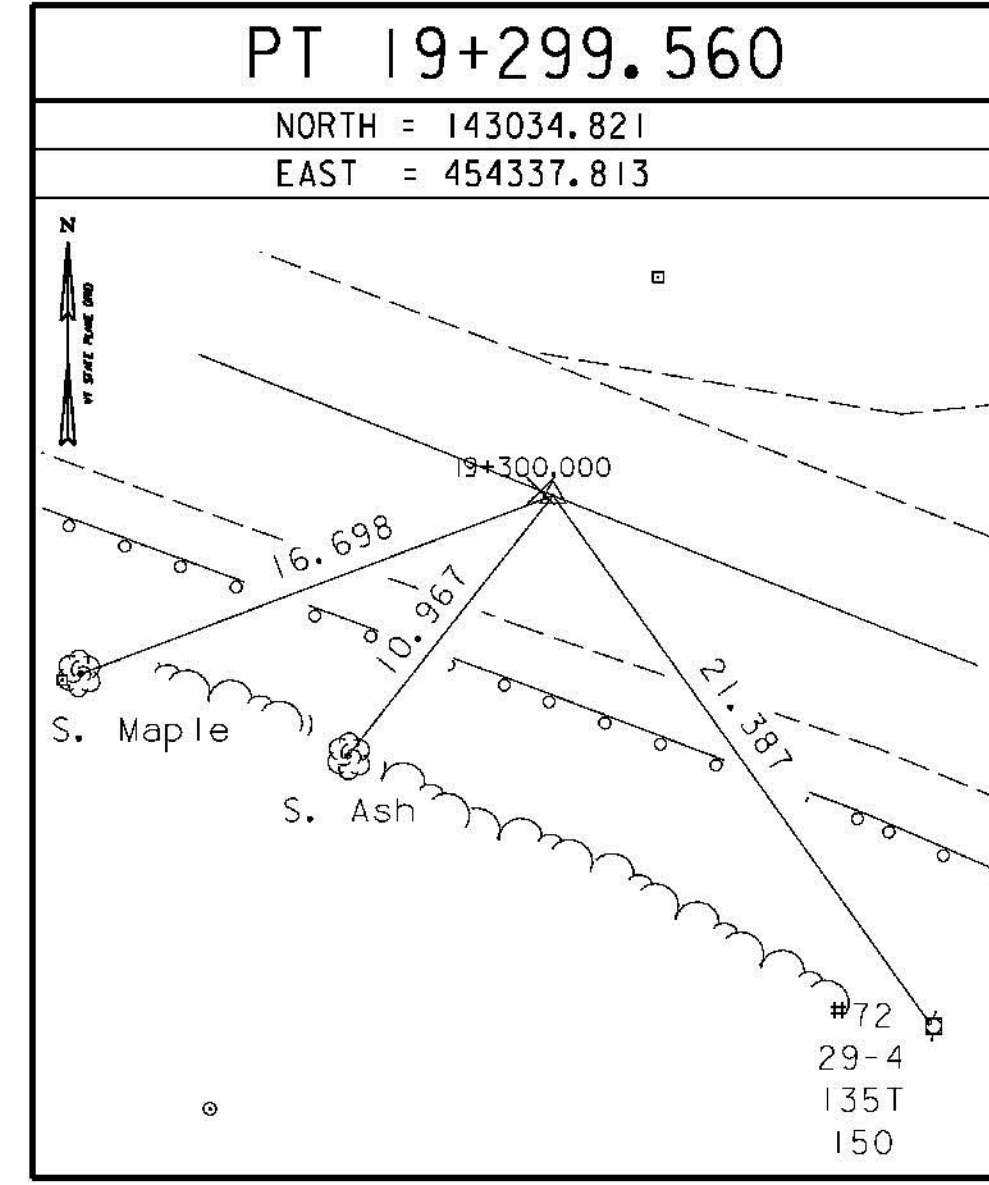
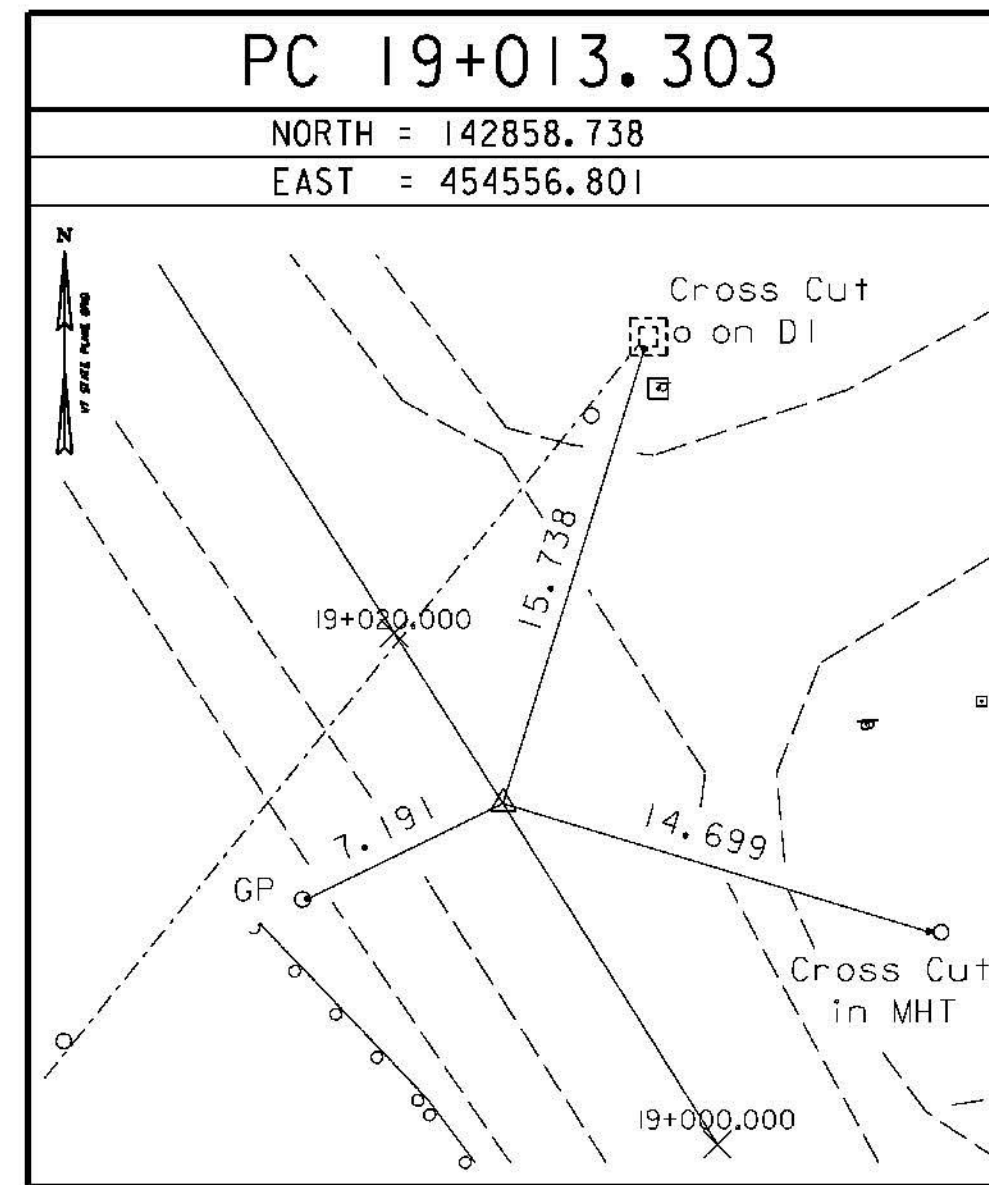
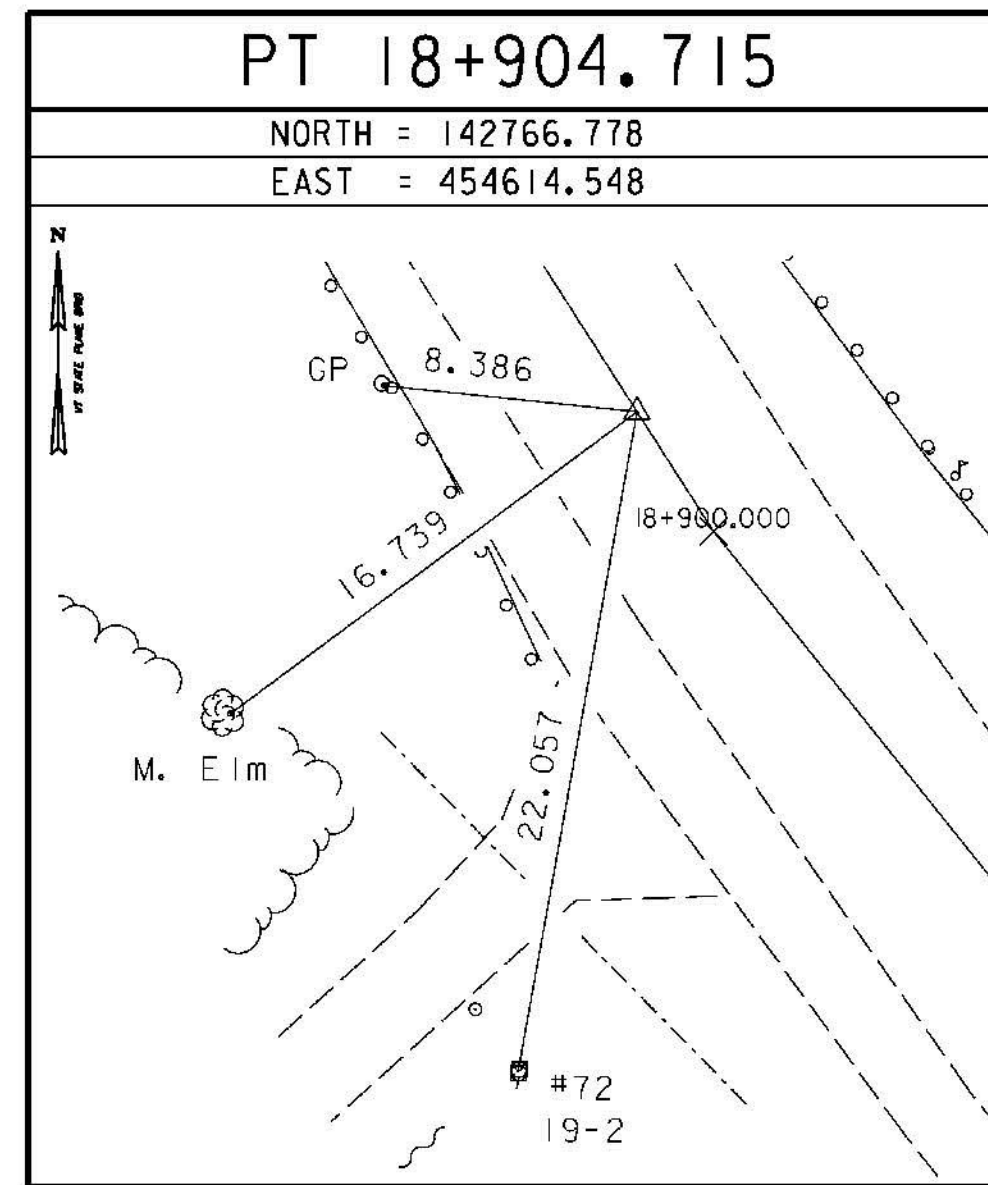
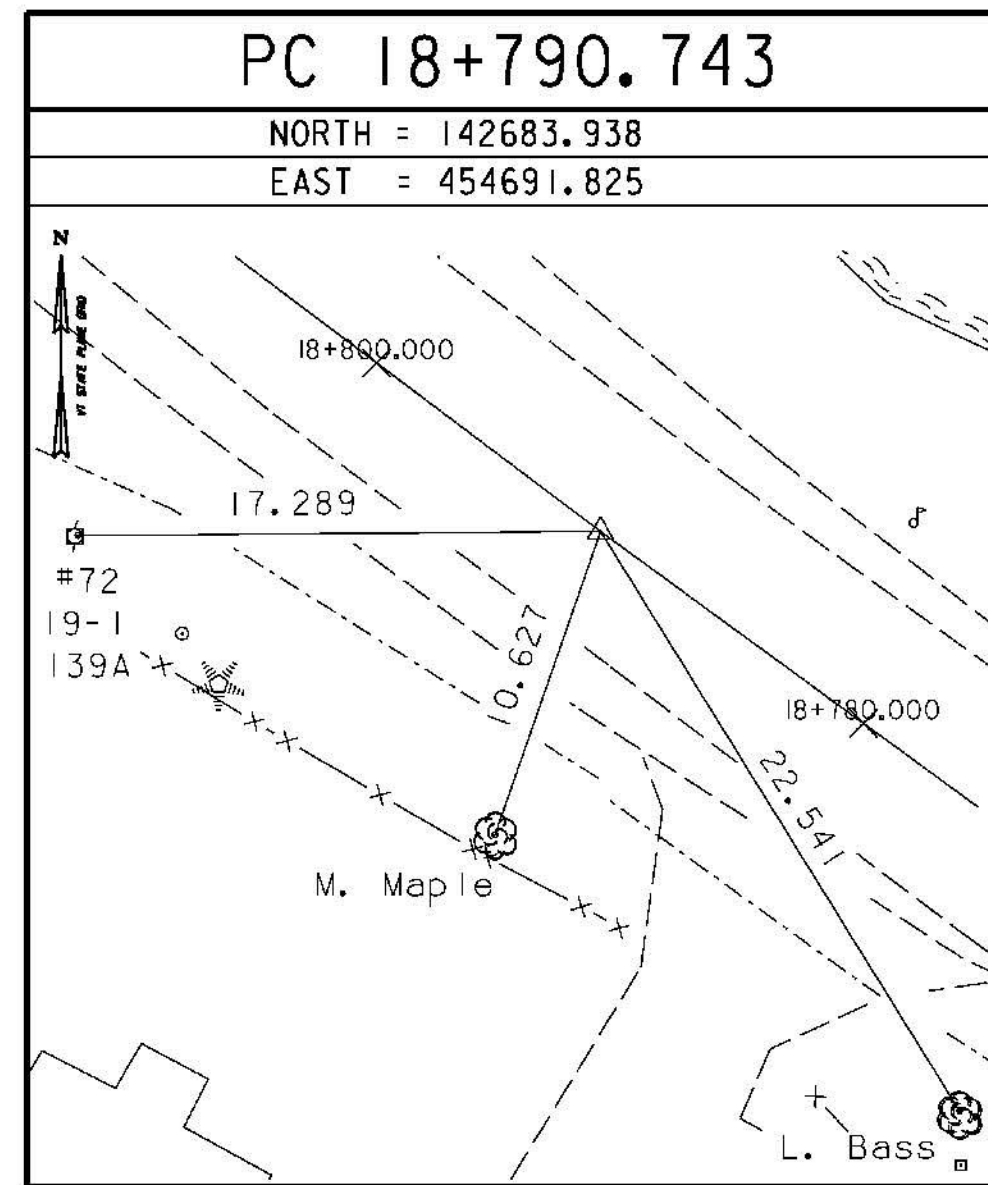
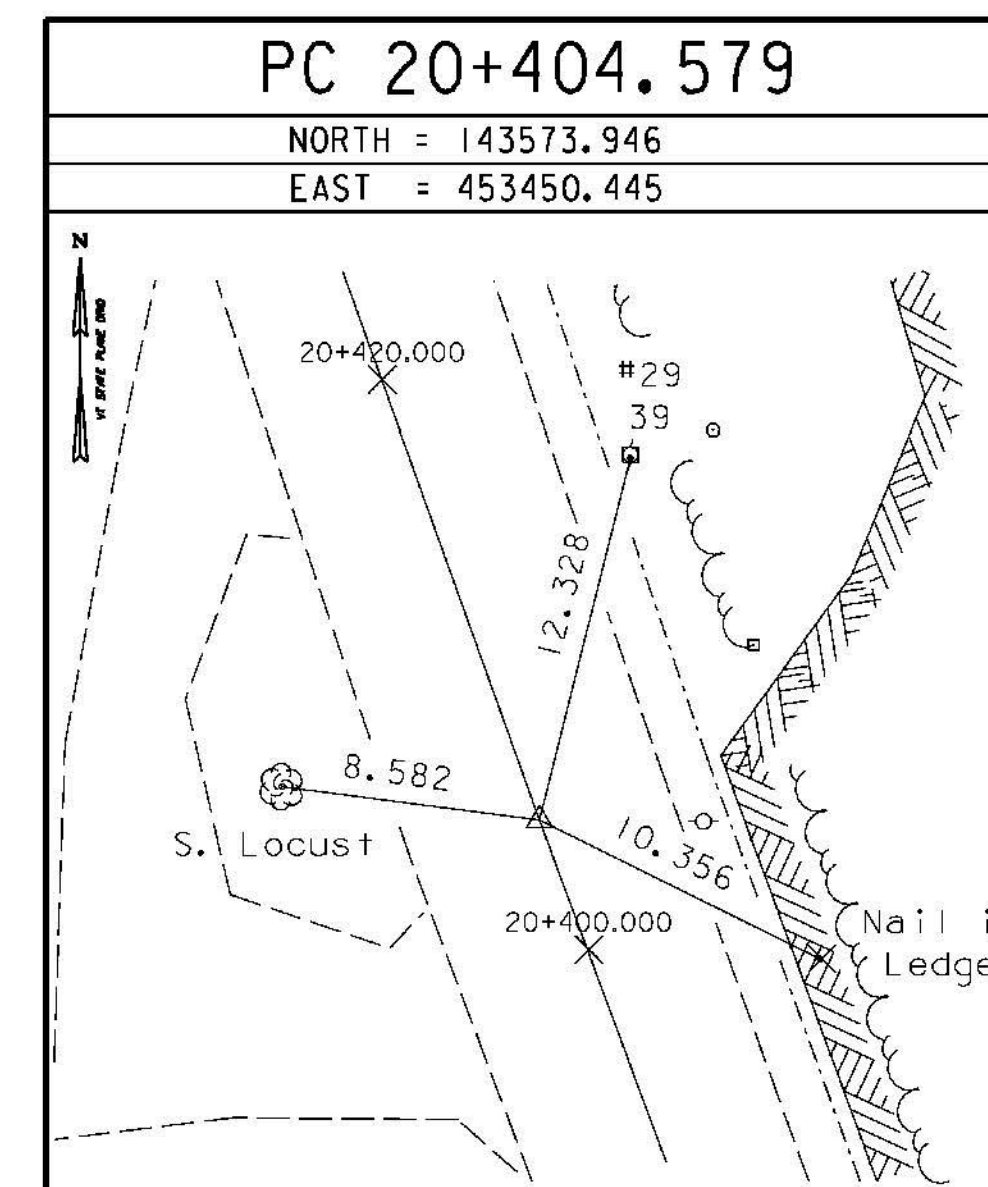
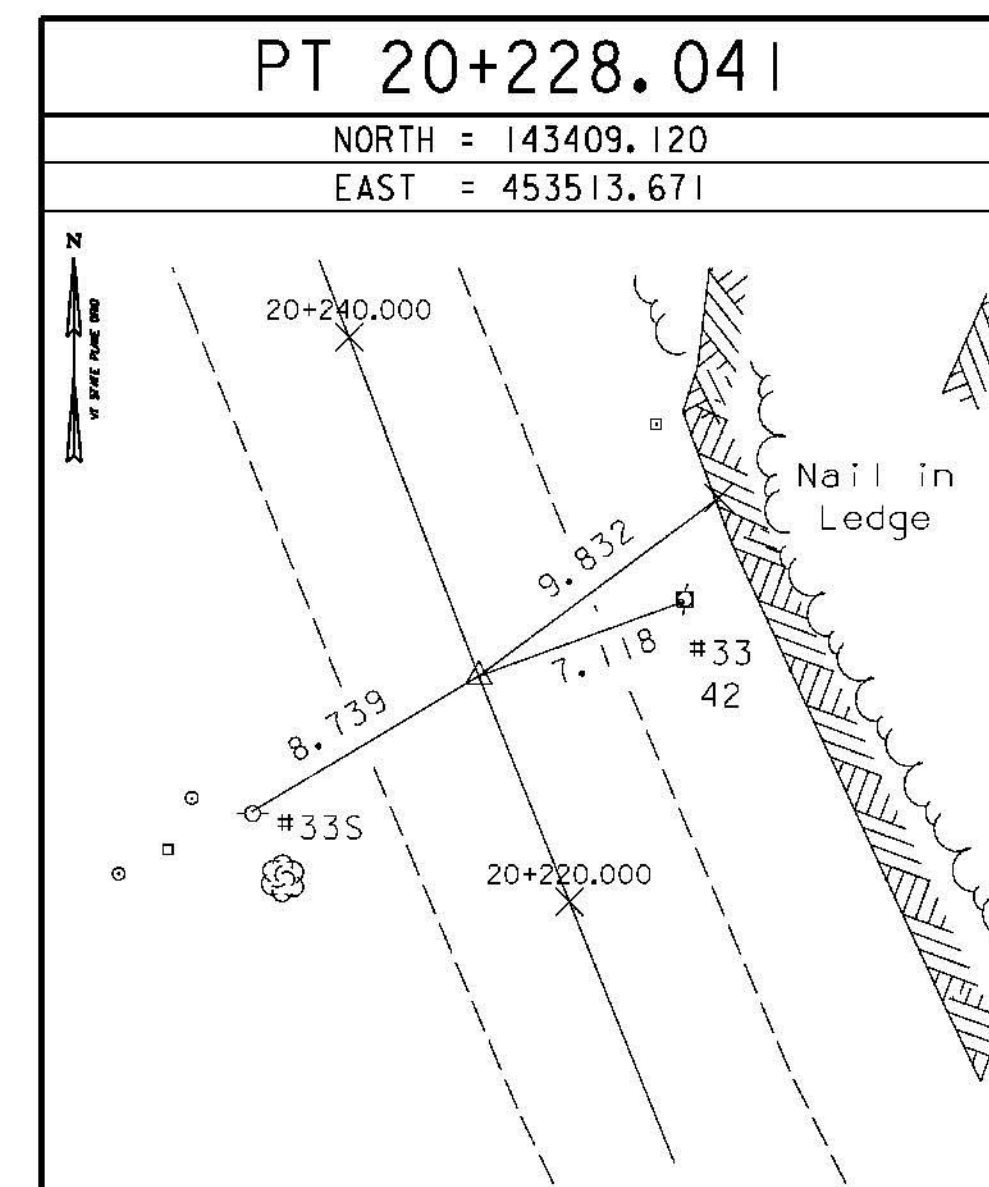
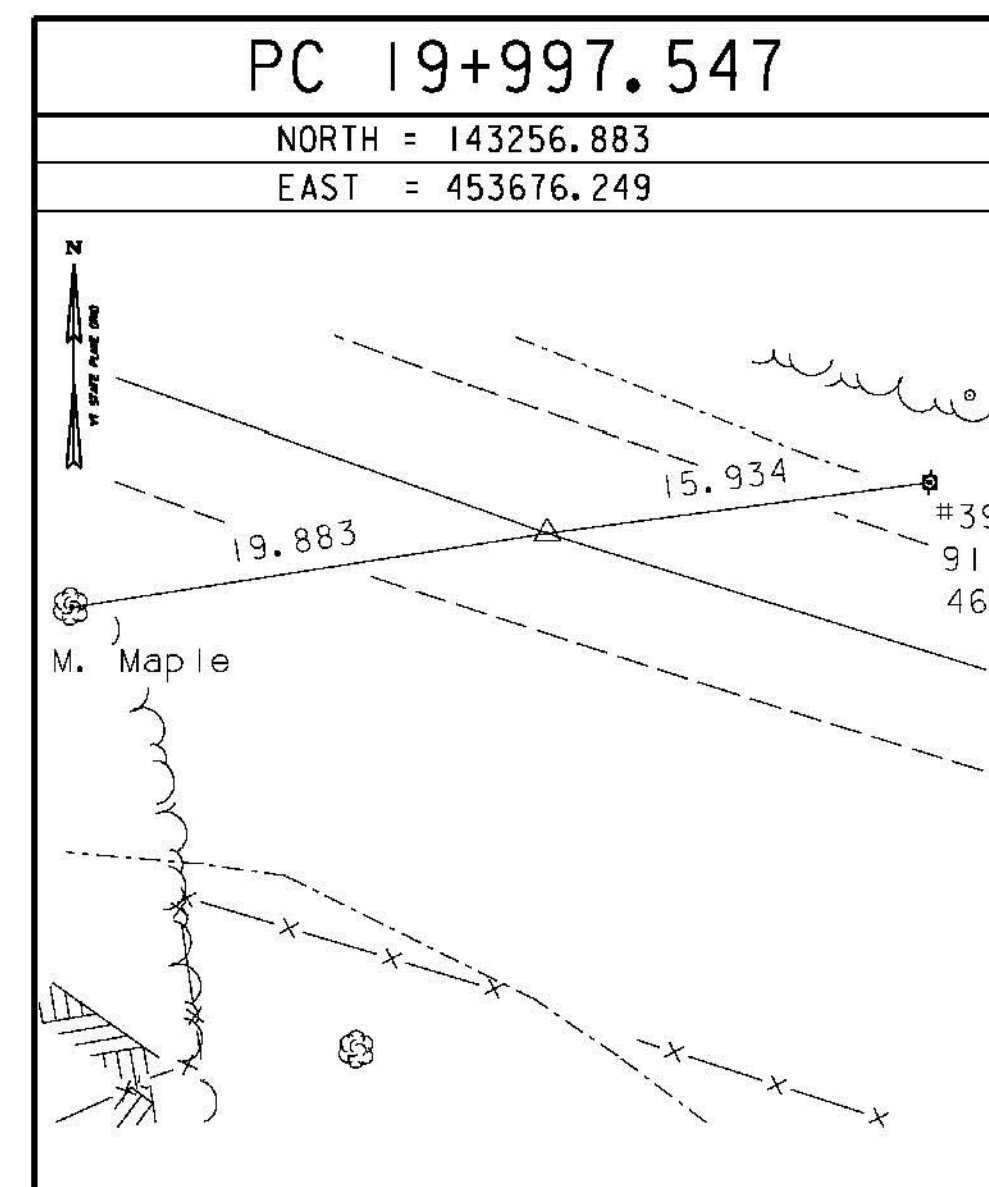







ALIGNMENT TIES

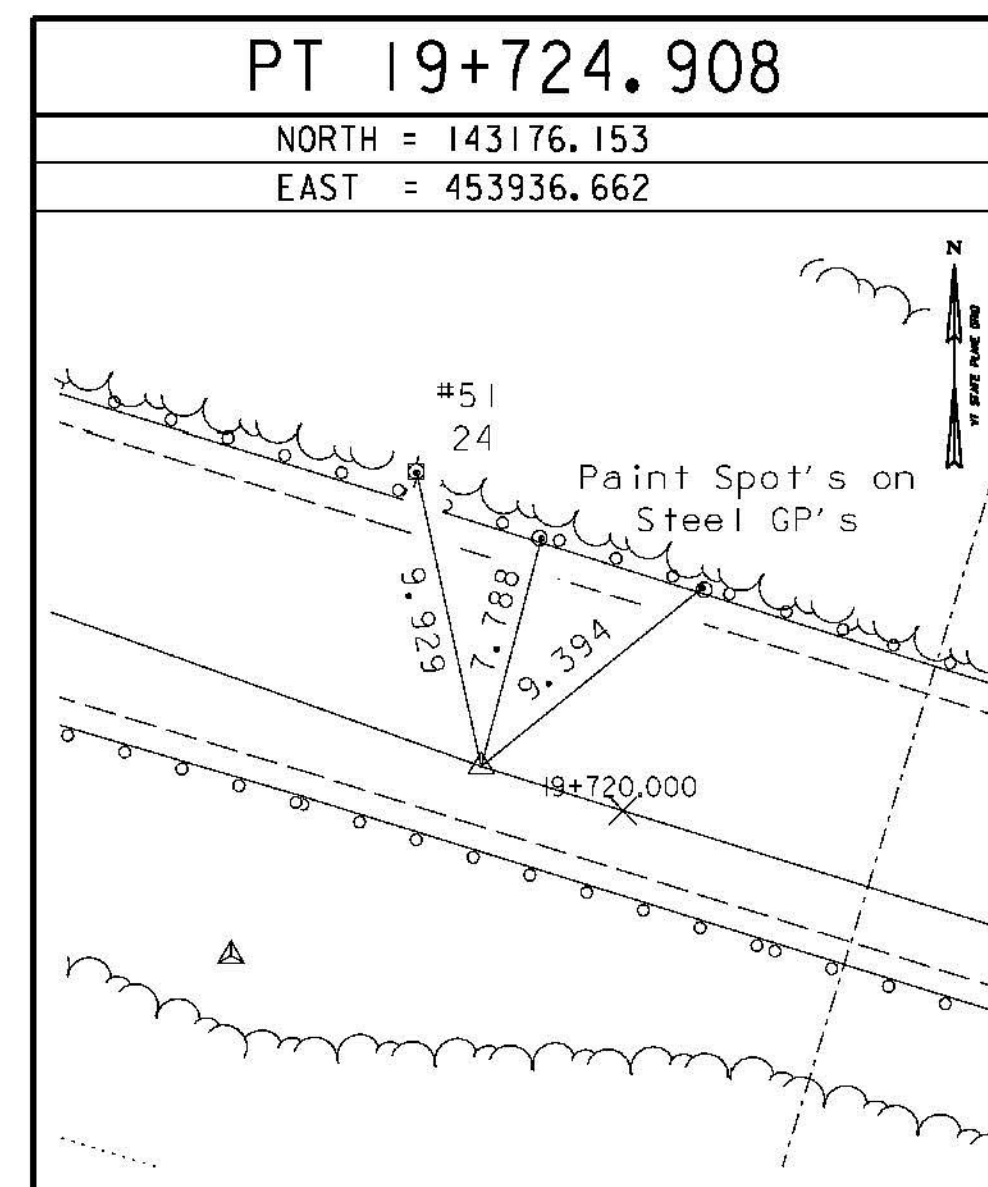

ALIGNMENT TIES

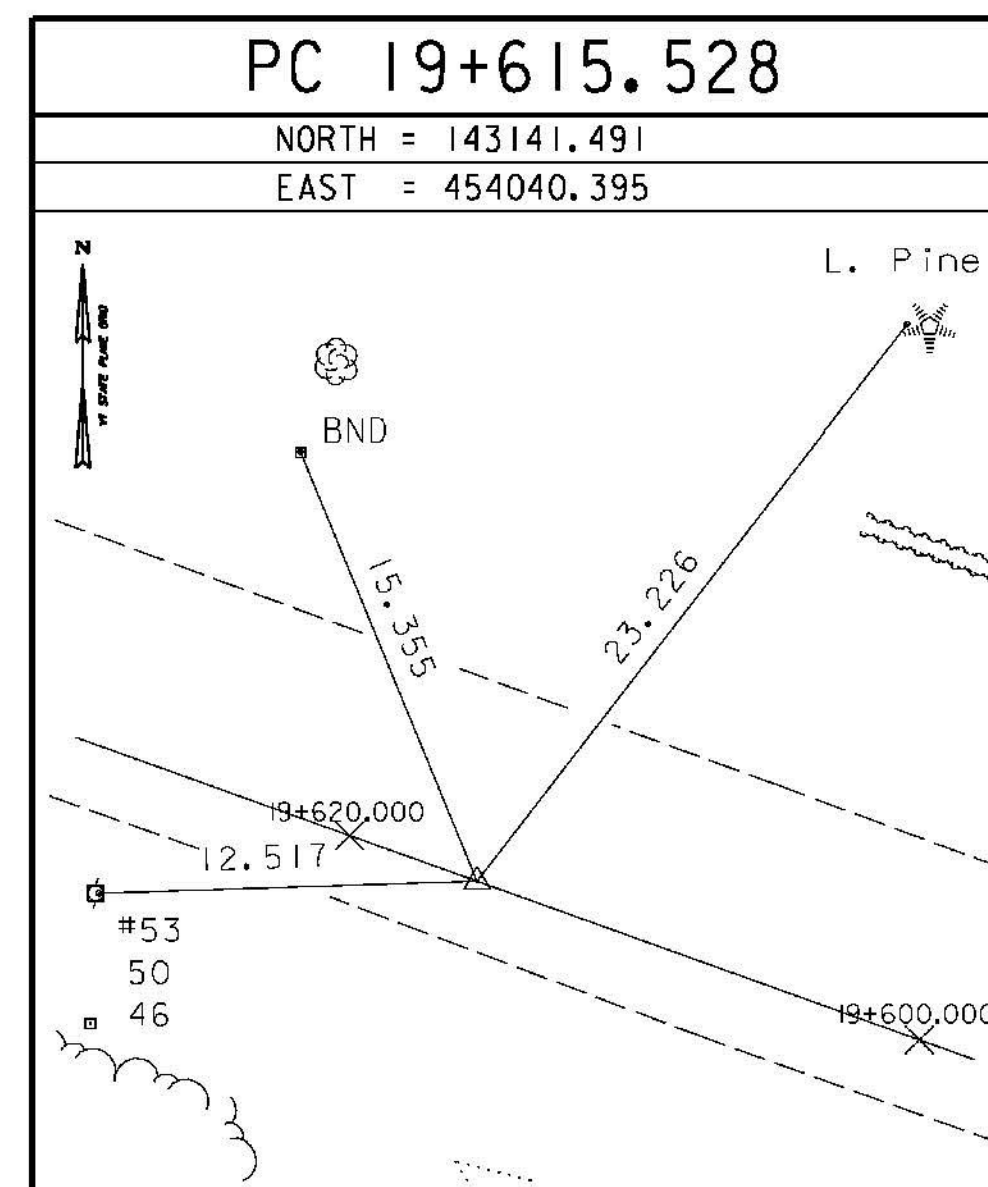

ALIGNMENT TIES

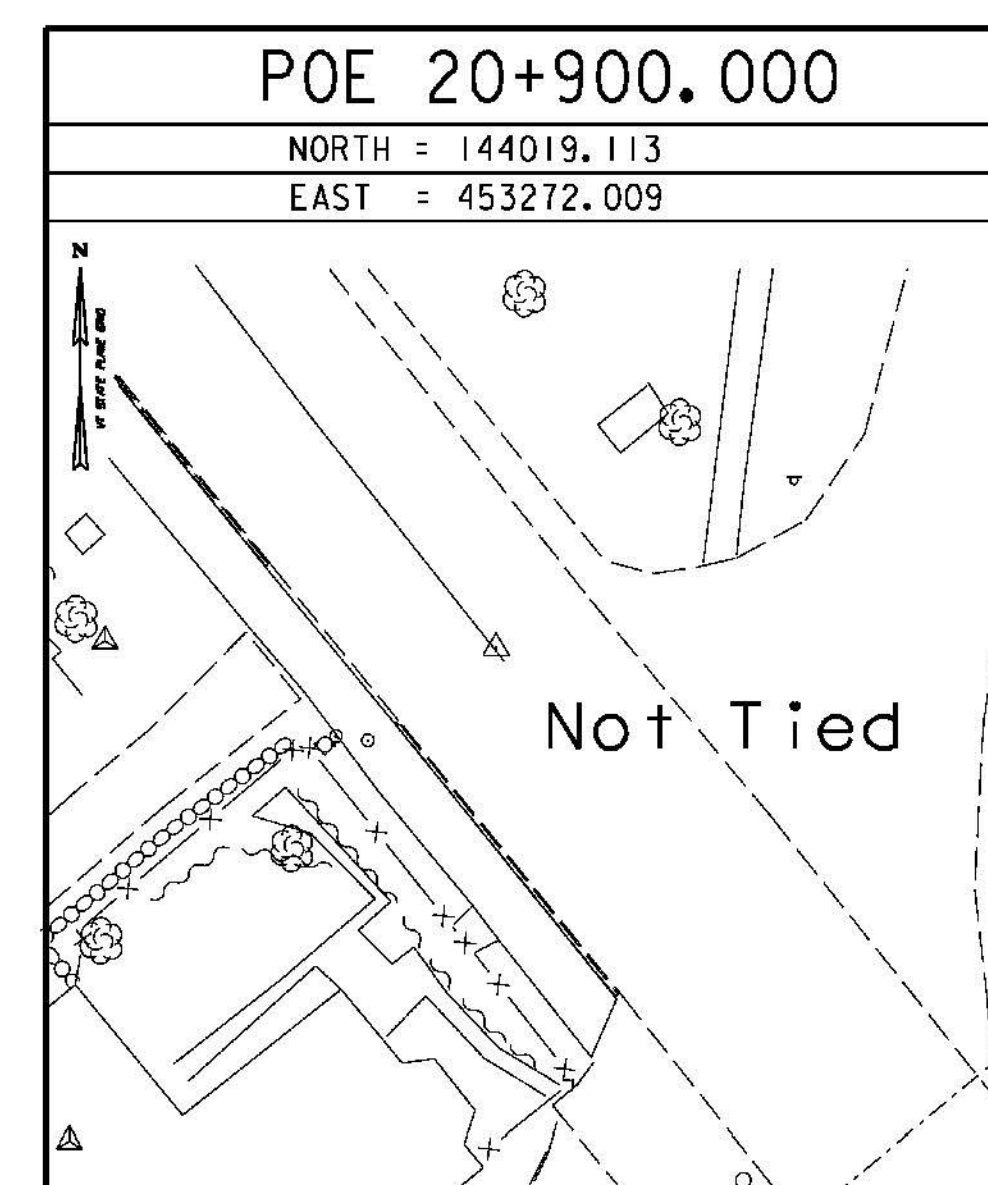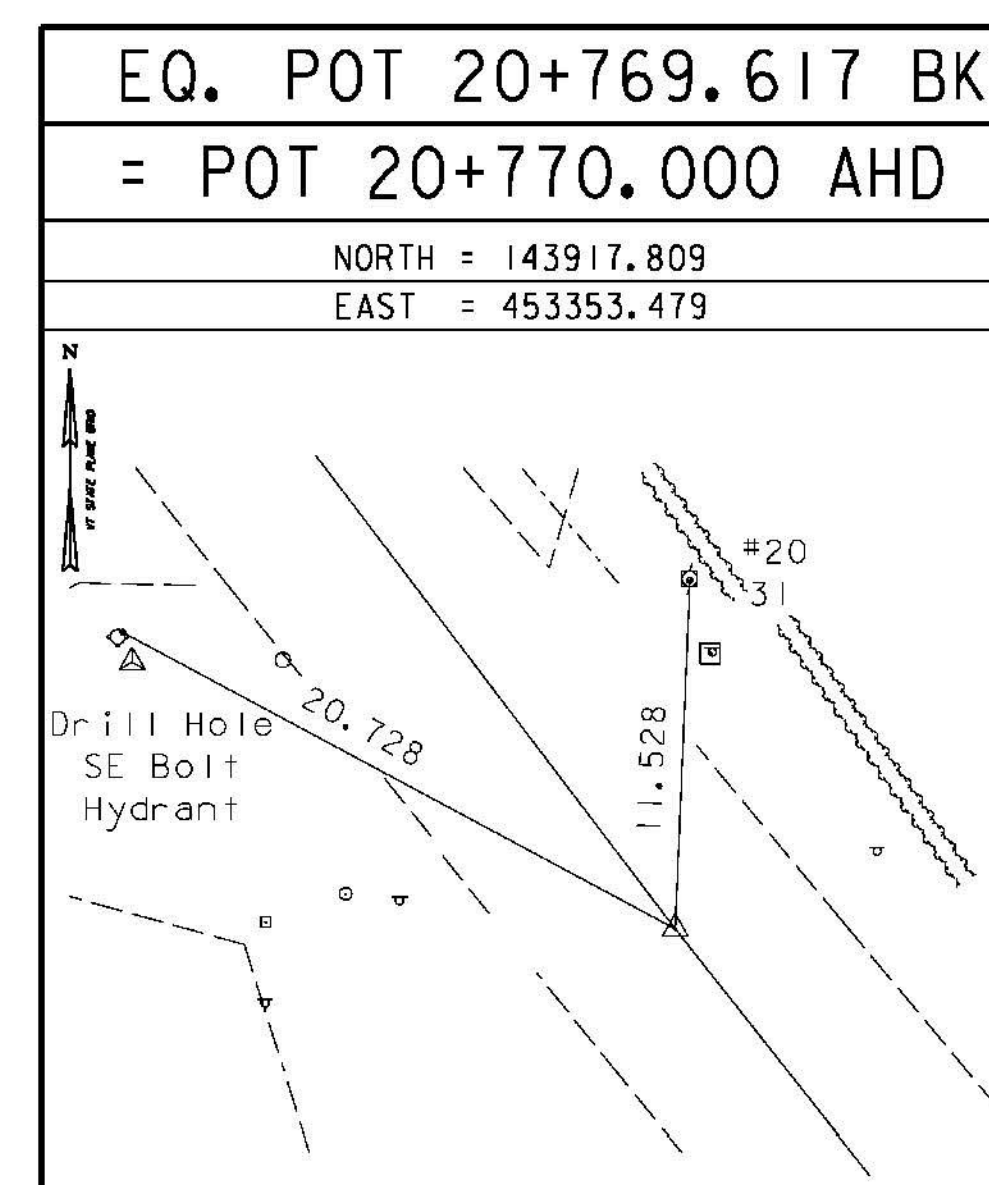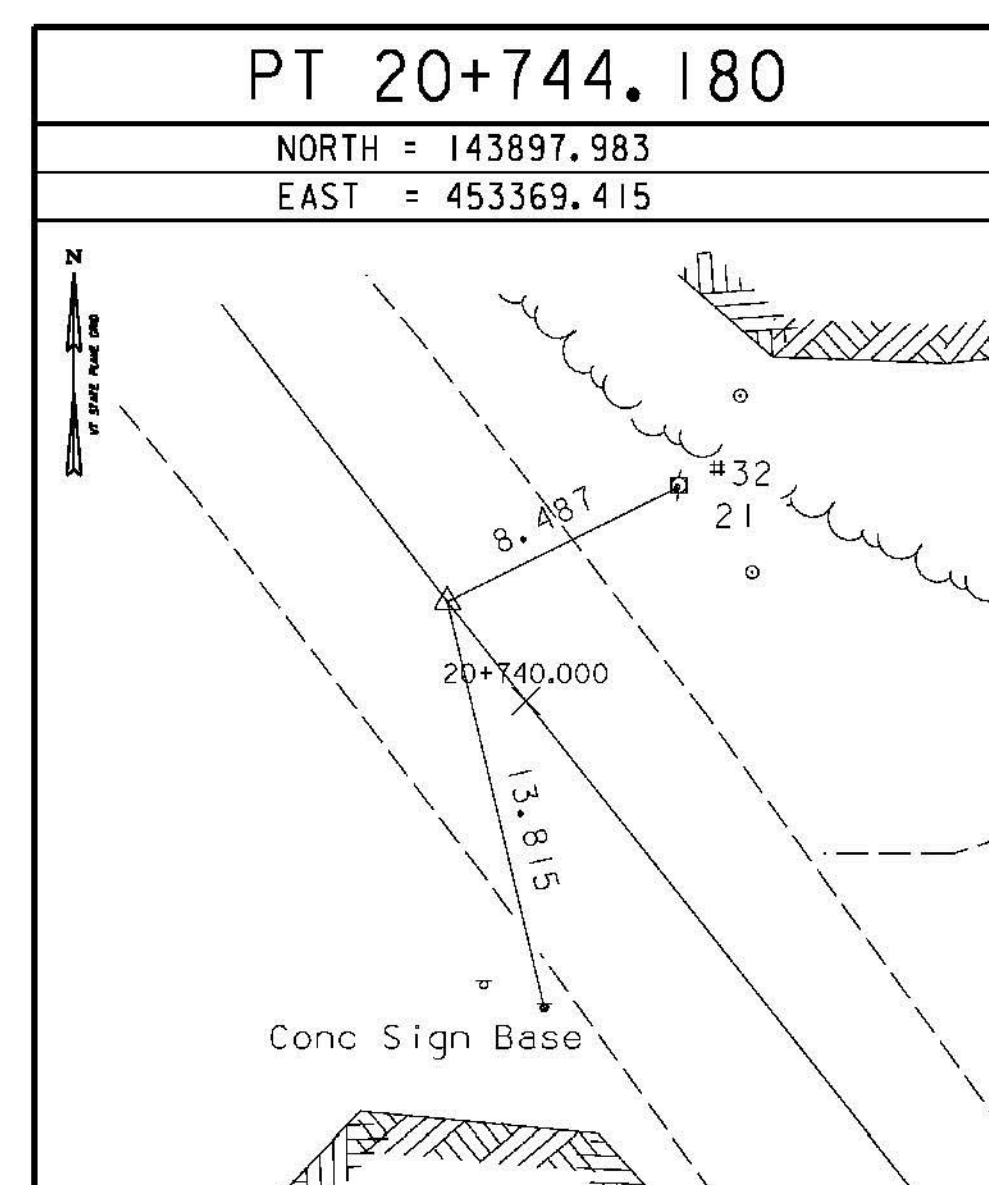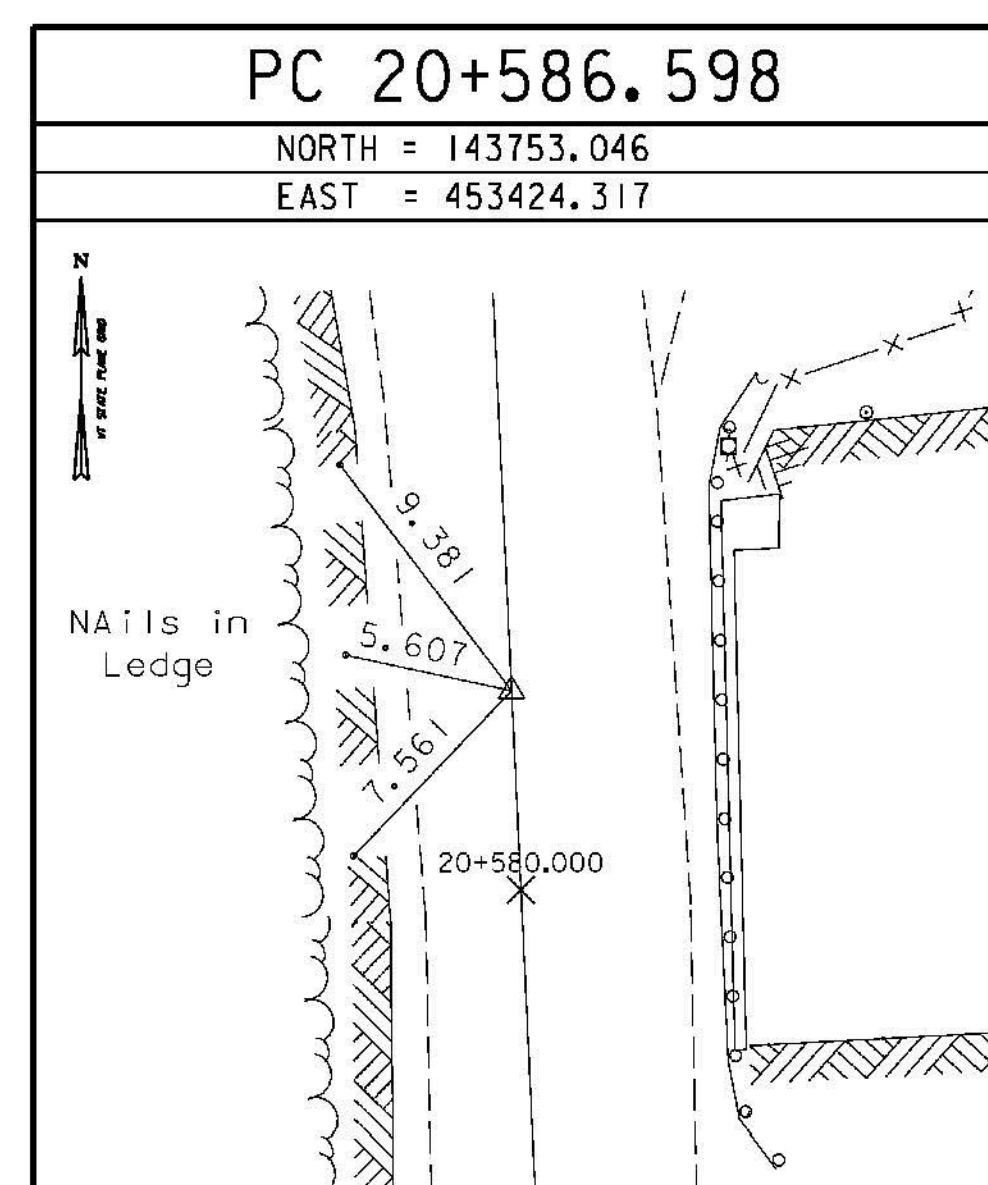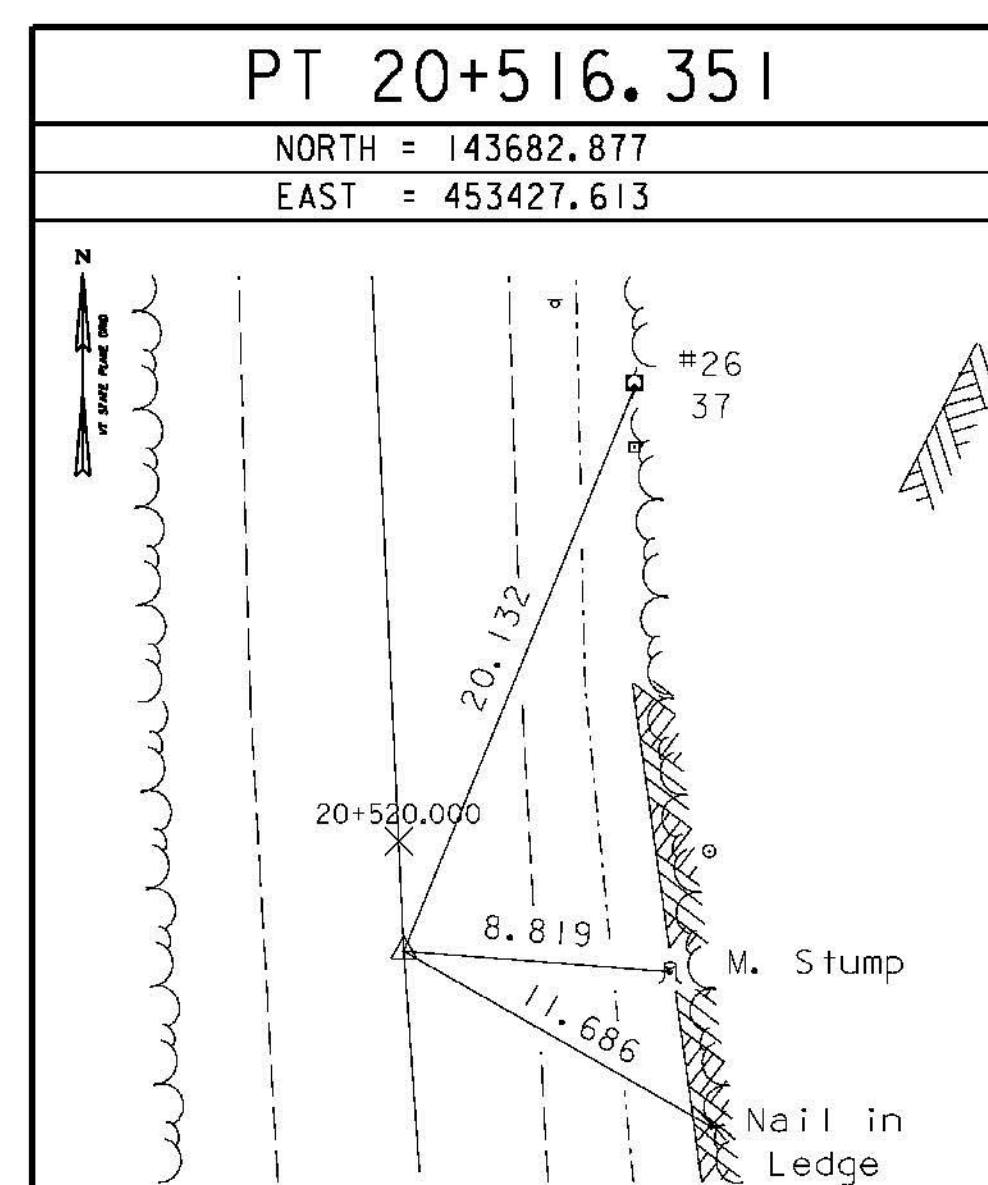

DATUM

| | |
|------------|---------------|
| VERTICAL | NAVD 88 |
| HORIZONTAL | NAD 83/92 |
| ADJUSTMENT | Least Squares |

| | | | |
|-----------------|--------------------|-------------|------------|
| PROJECT NAME: | BRANDON | PLOT DATE: | 9/3/2009 |
| PROJECT NUMBER: | NH 019-3(495) | DRAWN BY: | R. Bullock |
| FILE NAME: | x85b008s5-t103.dgn | CHECKED BY: | VTRANS |
| PROJECT LEADER: | VAOT | SHEET | 67 OF 546 |
| DESIGNED BY: | VTRANS | | |
| CLD 02-0149 | | | |

NOTE: ALL TIE DISTANCES IN METERS

TIE SHEET