


CONSTRUCT DRIVES
 STA 16+430.0 RT - 5.5 m WIDE, PAVED-RES.
 STA 16+475.0 LT - 5.4 m WIDE, PAVED-COMM.
 STA 16+502.8 RT - 3.6 m WIDE, PAVED-RES.

~~REMOVING AND RESETTING LIGHT POLE~~
~~STA 16+482.5 LT (WORK DONE BY SCHOOL)~~
~~STA 16+513.7 LT~~
~~SPECIAL PROVISION (REMOVING AND RESETTING GROUND/ORNAMENTAL LIGHT ASSEMBLY)~~
~~STA 16+440.2 RT (LIGHTS NOT THERE)~~
~~STA 16+445.6 RT~~



RELOCATE MAILBOX, SINGLE SUPPORT
 STA 16+499.1 RT
RELOCATE MAILBOX, MULTIPLE SUPPORT
 STA 16+421.0 RT

REMOVAL AND DISPOSAL OF GUARDRAIL
 STA 16+482.9 - 16+530.0 LT
STEEL BEAM GUARDRAIL, GALVANIZED
 STA 16+495.0 - 16+520.0 LT
CHAIN-LINK FENCE, 1.8M BRACING ASSEMBLY FOR CHAIN-LINK FENCE
GEOTEXTILE FOR SILT FENCE
 STA 16+506 - 16+530 RT
TEMPORARY TRAFFIC BARRIER (CMB)
 STA 16+506 - 16+530 RT
 (PER NECESSITY STIPULATION)

STEEL BEAM GUARDRAIL, GALVANIZED W/2.4m POSTS
 STA 16+520.0 - 16+530.0 LT
MANUFACTURED TERMINAL SECTION, TANGENT
 STA 16+495.0 LT

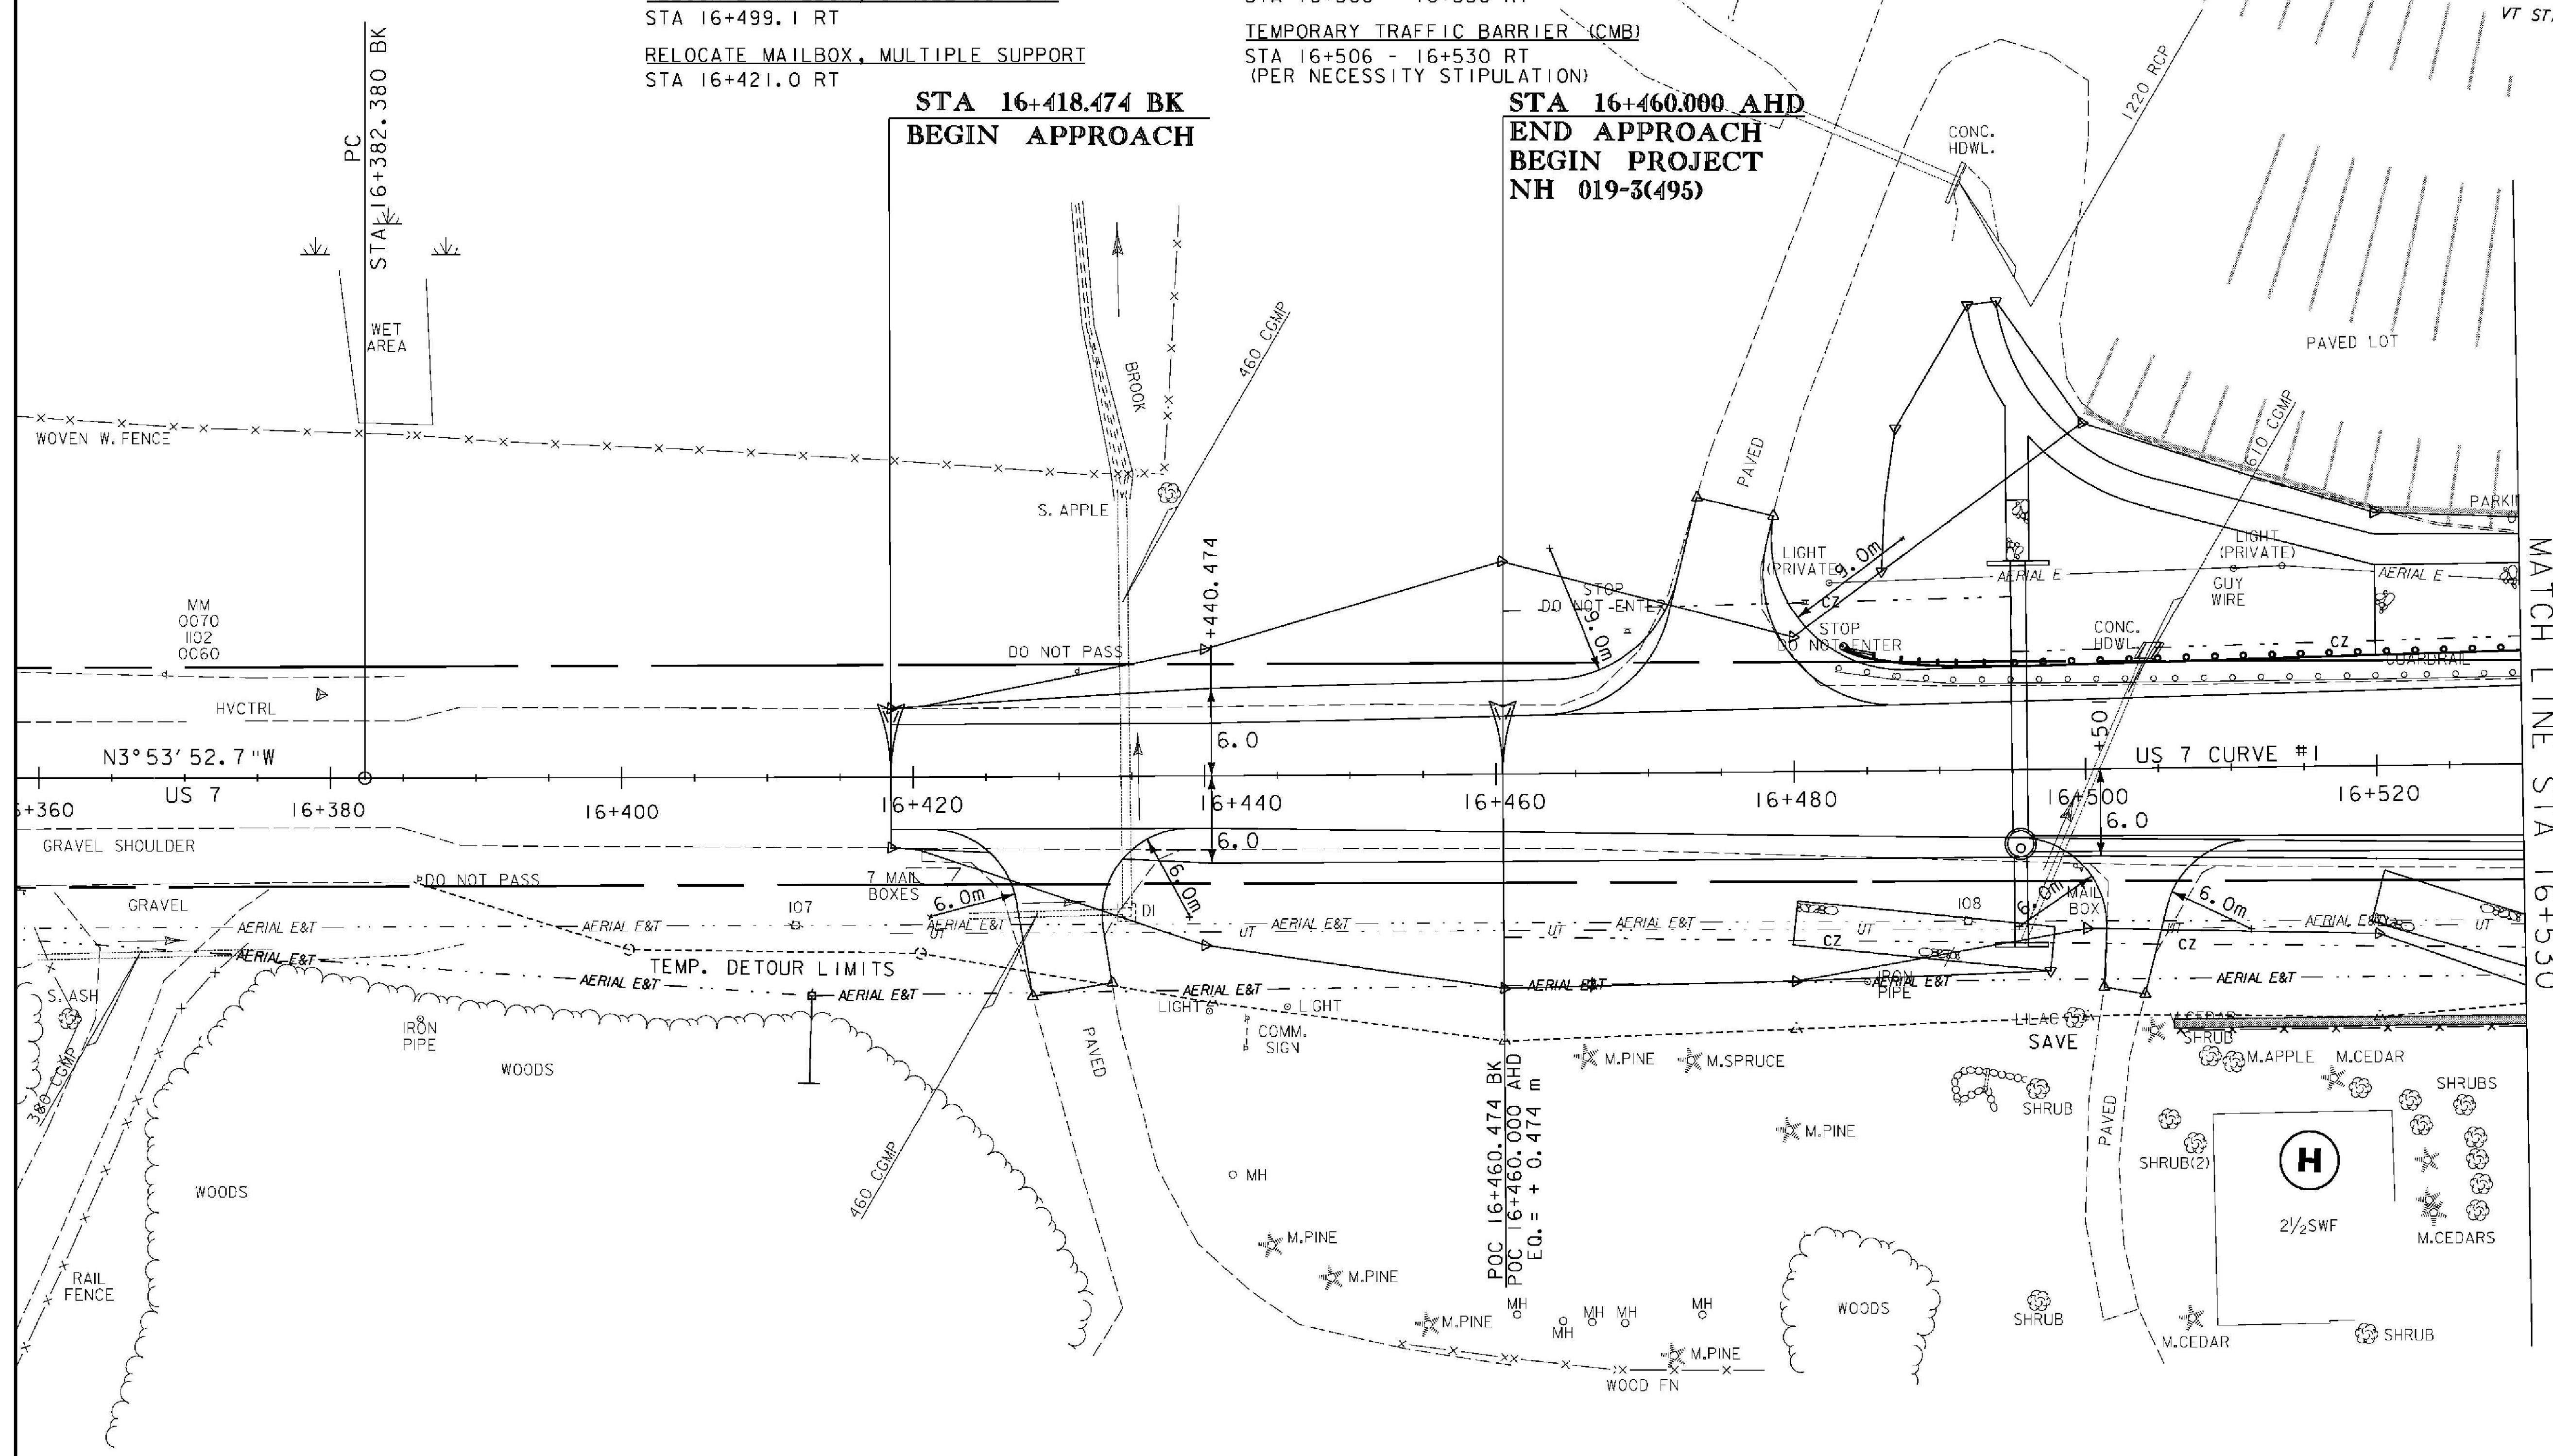

MATCH LINE STA 16+530

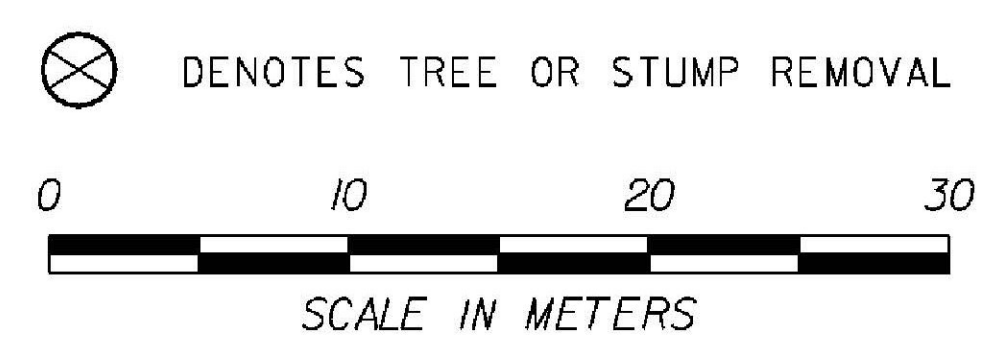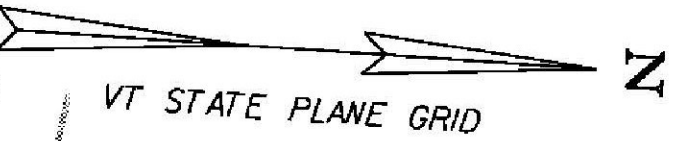

ROADWAY LAYOUT I	
PROJECT NAME:	BRANDON
PROJECT NUMBER:	NH 019-3(495)
FILE NAME:	zb008s5-gen01.dgn
PROJECT LEADER:	CRB
DESIGNED BY:	DAM
CLD 02-019	
PLOT DATE:	9/3/2009
DRAWN BY:	NLL
CHECKED BY:	PTS
SHEET	68 OF 546