


**NOTE**  
 1. EXISTING GROUND ELEVATION IS SHOWN LIGHT.  
 2. FINISH GRADE ELEVATION IS SHOWN IN BOLD.

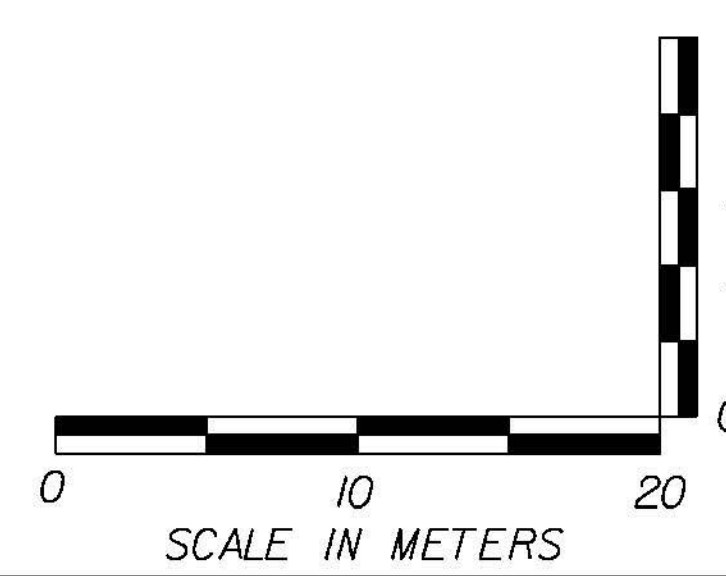

**US 7 PROFILE 2**

PROJECT NAME: BRANDON	PLOT DATE: 9/3/2009
PROJECT NUMBER: NH 019-3(495)	DRAWN BY: NLL
FILE NAME: zb008s5-pro02.dgn	CHECKED BY: PTS
PROJECT LEADER: CRB	SHEET 71 OF 546
DESIGNED BY: DAM	
CLD 02-0149	