
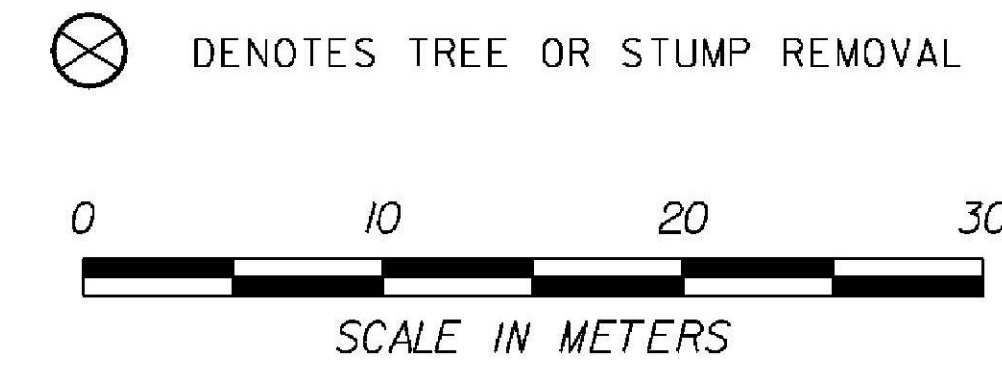


CONSTRUCT DRIVES  
 STA 17+320.0 RT - 10.5 m WIDE, PAVED-COMM.

GRANITE SLOPE EDGING (100mm)  
 STA 17+306.3 - 17+315.8 RT  
 STA 17+326.5 - 17+330.0 RT (ISLAND)

STEEL BEAM GUARDRAIL, GALVANIZED  
 STA 17+170.0 LT - 17+290.0 LT  
 MANUFACTURED TERMINAL SECTION, TANGENT  
 STA 17+290.0 LT

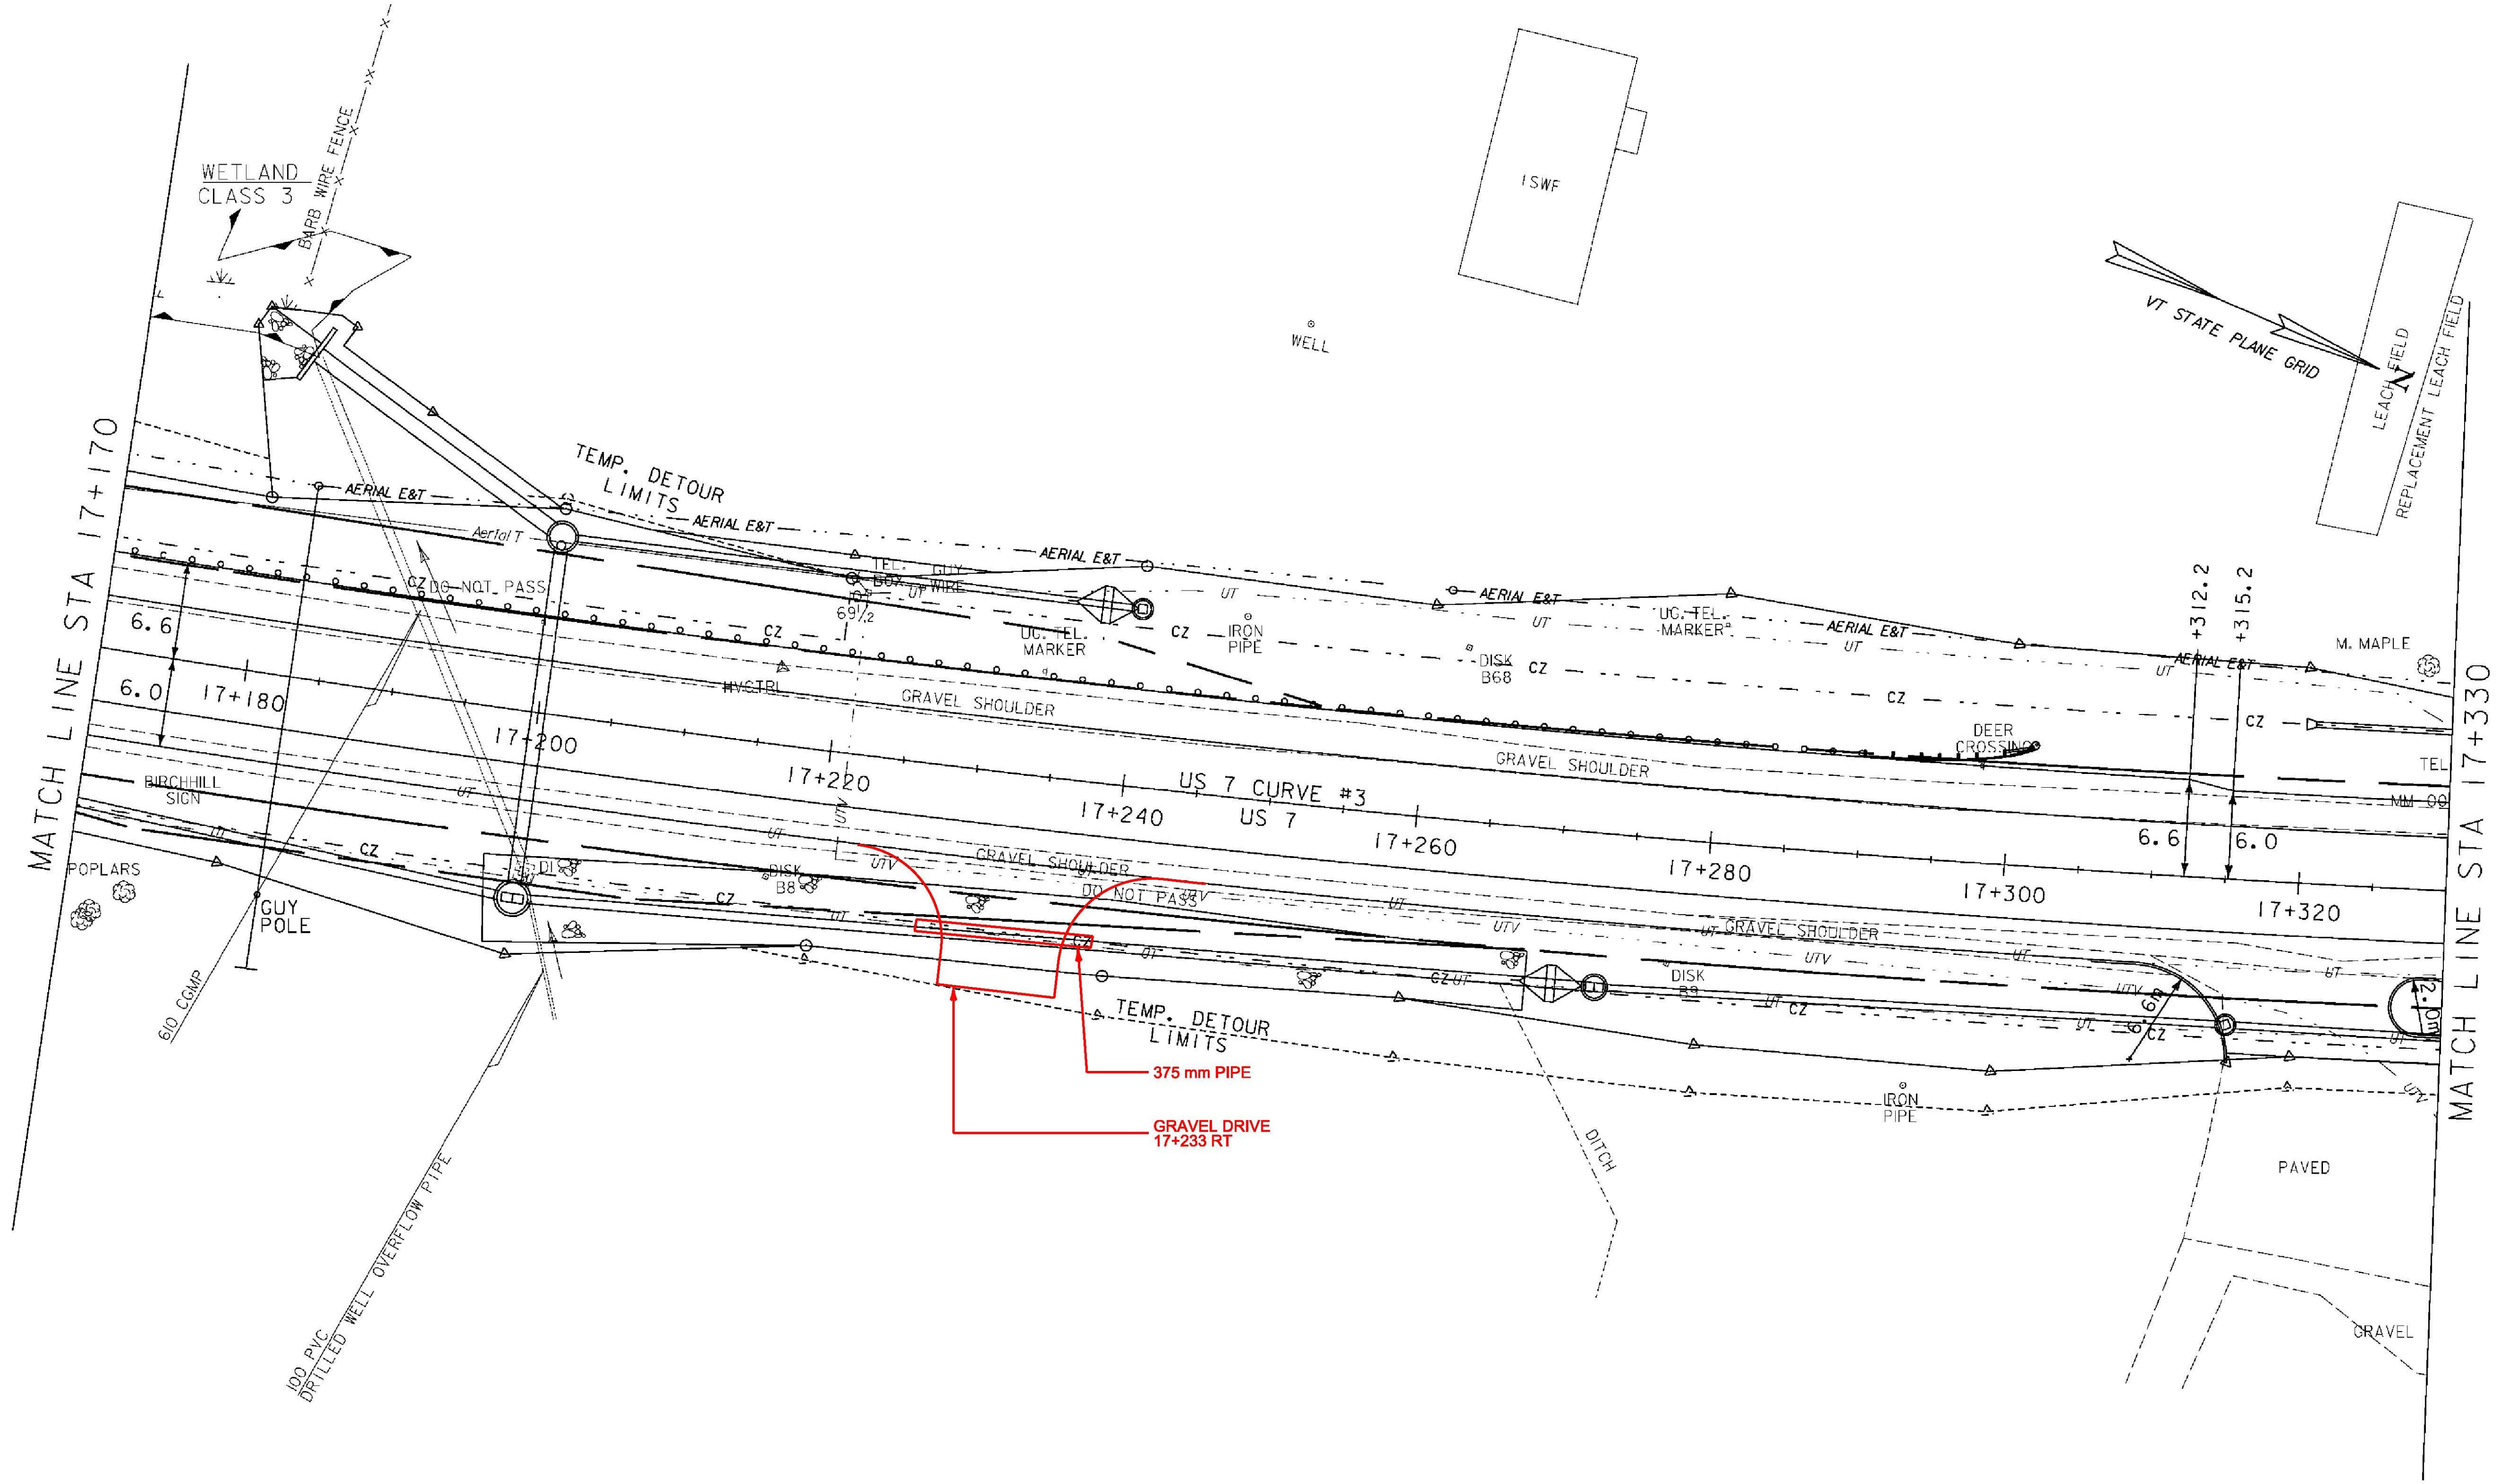

ROADWAY LAYOUT 6	
PROJECT NAME:	BRANDON
PROJECT NUMBER:	NH 019-3(495)
FILE NAME:	zb008s5-gen06.dgn
PROJECT LEADER:	CRB
DESIGNED BY:	DAM
CLD 02-0149	
PLOT DATE:	9/3/2009
DRAWN BY:	NLL
CHECKED BY:	PTS
SHEET	78 OF 546