
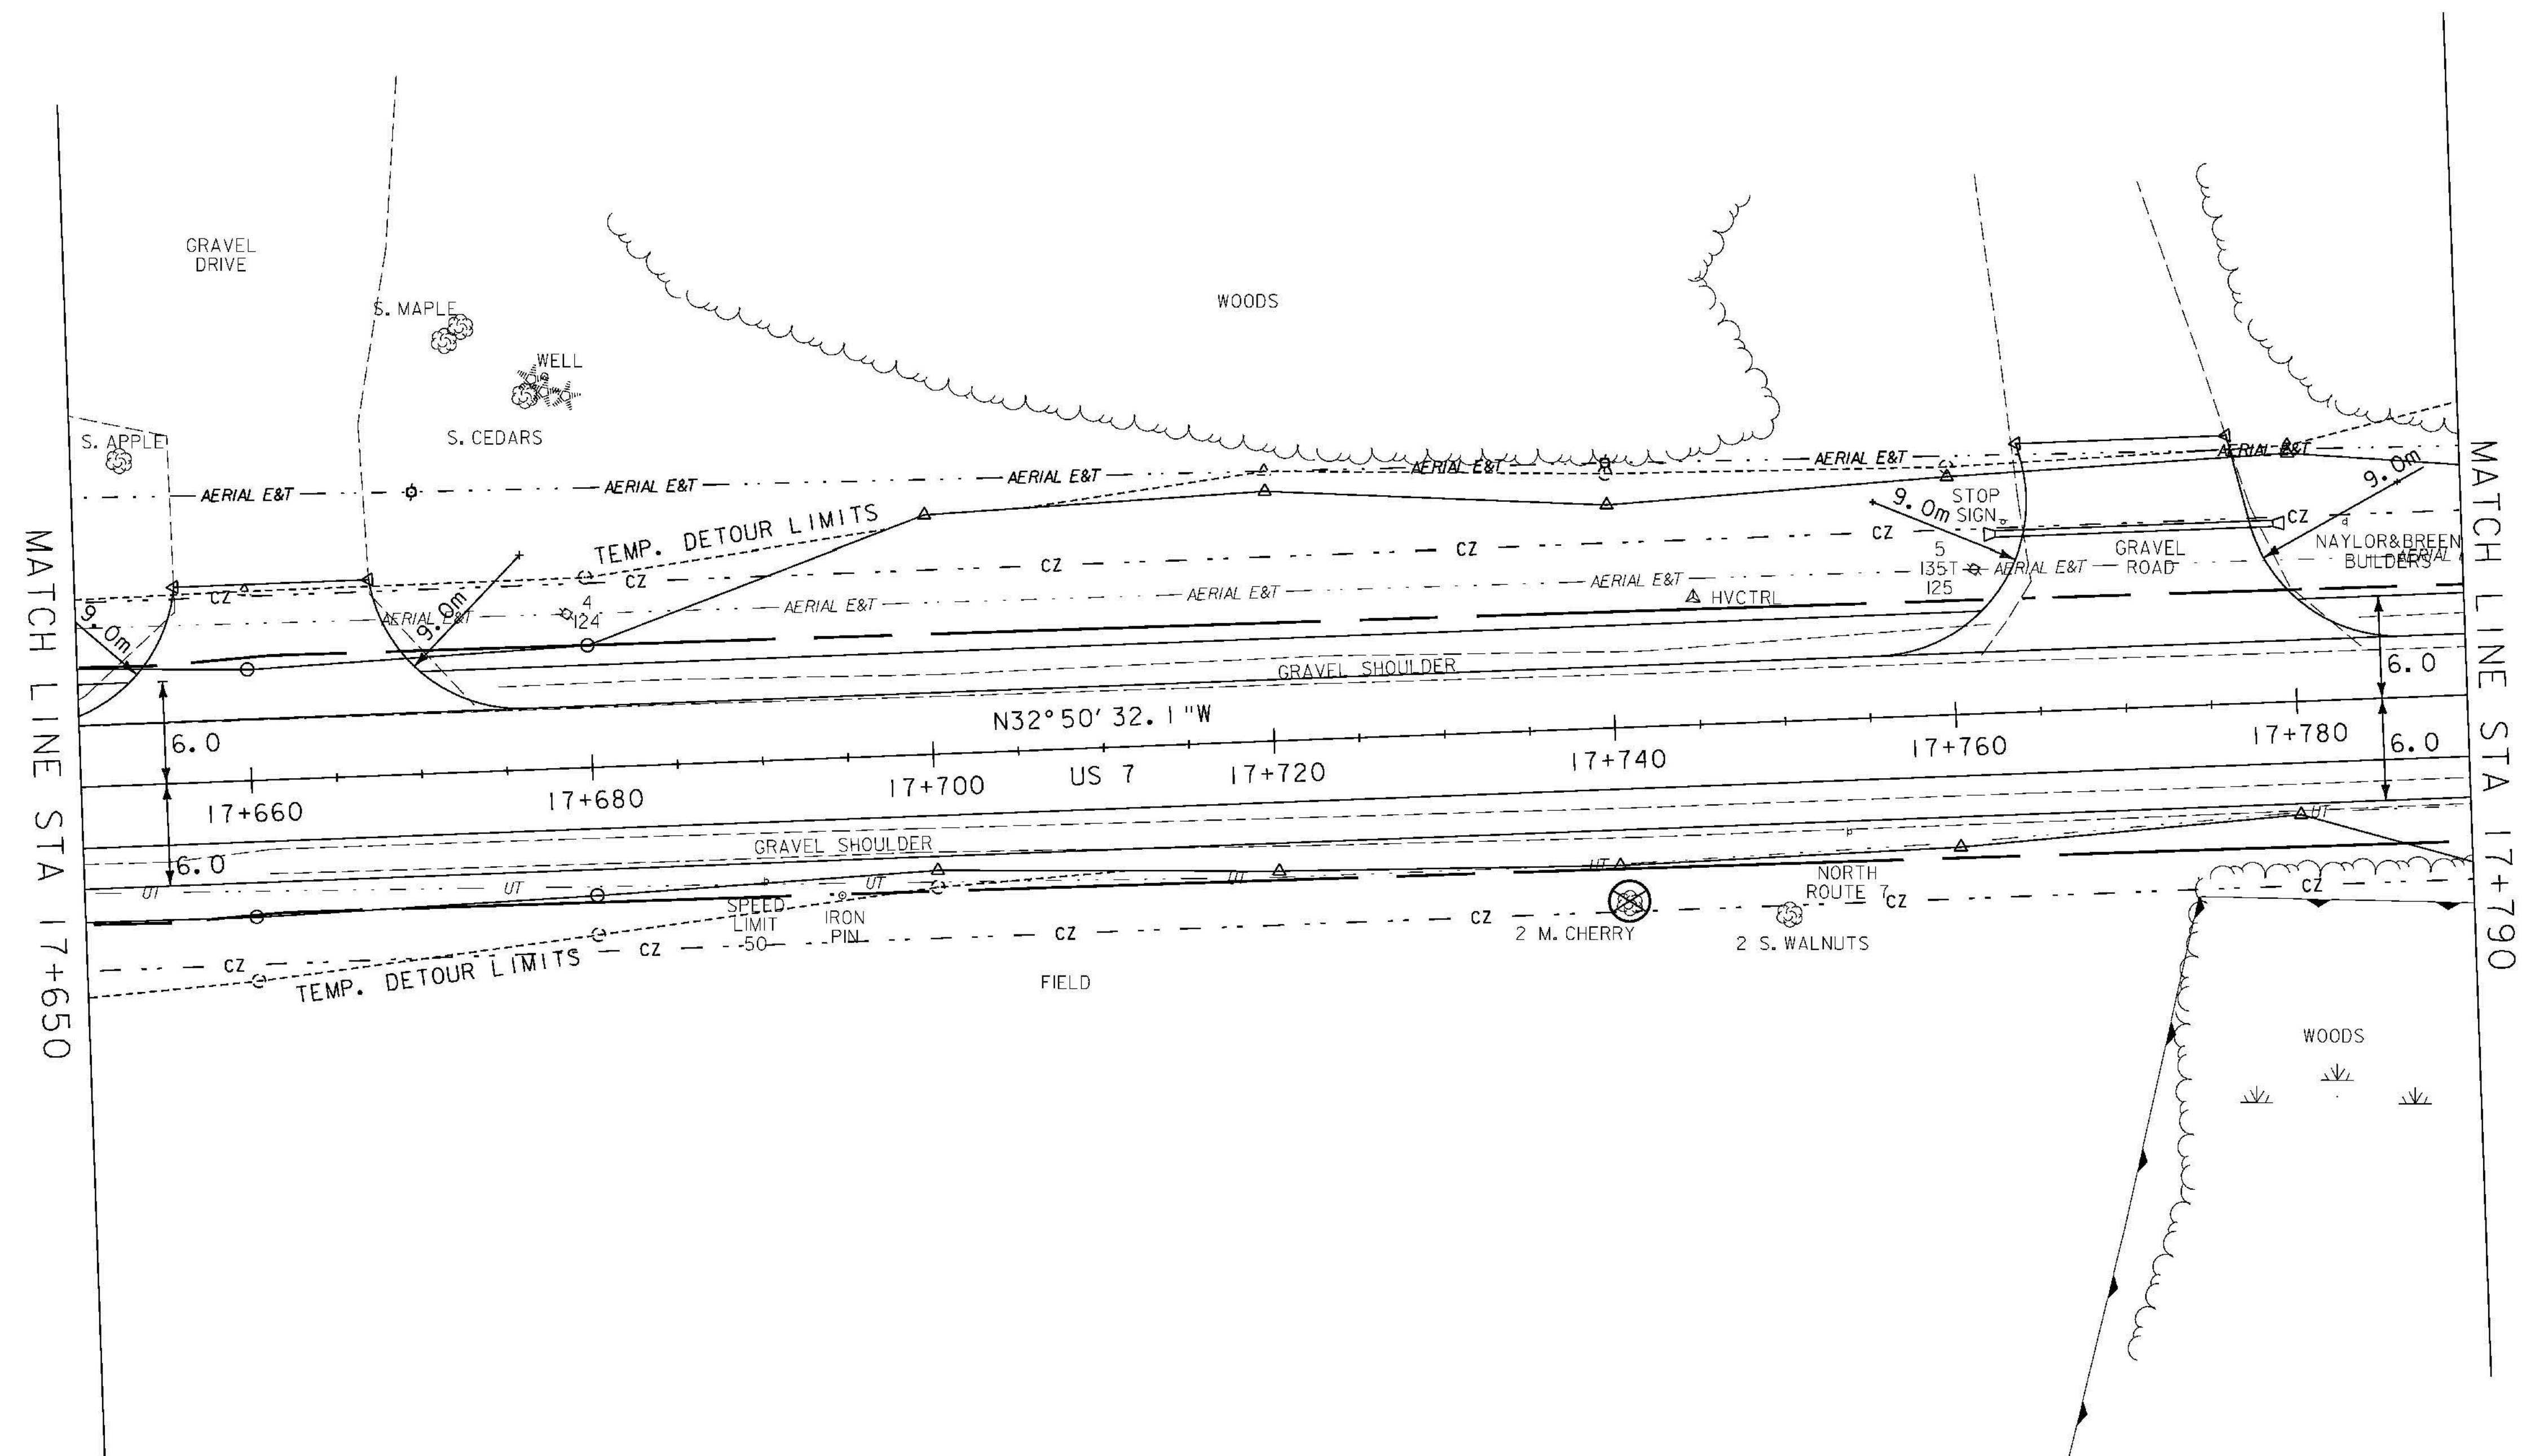


CONSTRUCT DRIVES
 STA 17+660.0 LT - 11.4 m WIDE, GRAVEL-COMM.
 STA 17+770.0 LT - 12.0 m WIDE, GRAVEL-COMM.

SPECIAL PROVISION (REMOVE
 AND RESET COMMERCIAL SIGN)
 STA 17+783.2 LT

IRON
 PIN

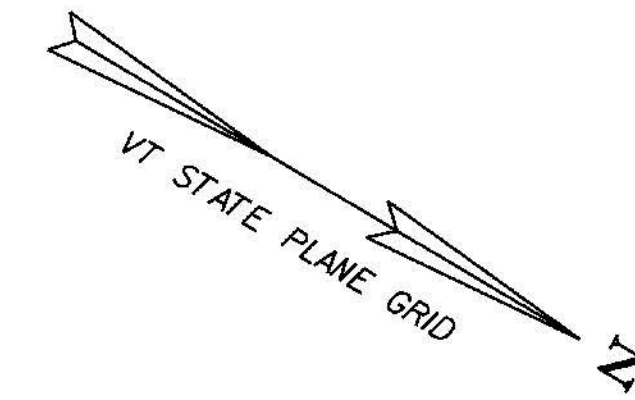

MATCH LINE STA 17+650

MATCH LINE STA 17+790

⊗ DENOTES TREE OR STUMP REMOVAL



ROADWAY LAYOUT 9

PROJECT NAME: BRANDON	PLOT DATE: 9/3/2009
PROJECT NUMBER: NH 019-3(495)	DRAWN BY: NLL
FILE NAME: zb008s5-gen09.dgn	CHECKED BY: PTS
PROJECT LEADER: CRB	SHEET 84 OF 546
DESIGNED BY: DAM	
CLD 02-0149	