
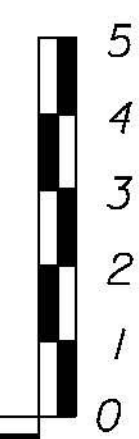


$L = 120 \text{ m}$
 $K = 44$
 $SSD = 135 \text{ m}$

PVI STA = 17+680.000
 PVI ELEV = 137.478

-0.5000%

NOTE
 1. EXISTING GROUND ELEVATION IS SHOWN LIGHT.
 2. FINISH GRADE ELEVATION IS SHOWN IN BOLD.

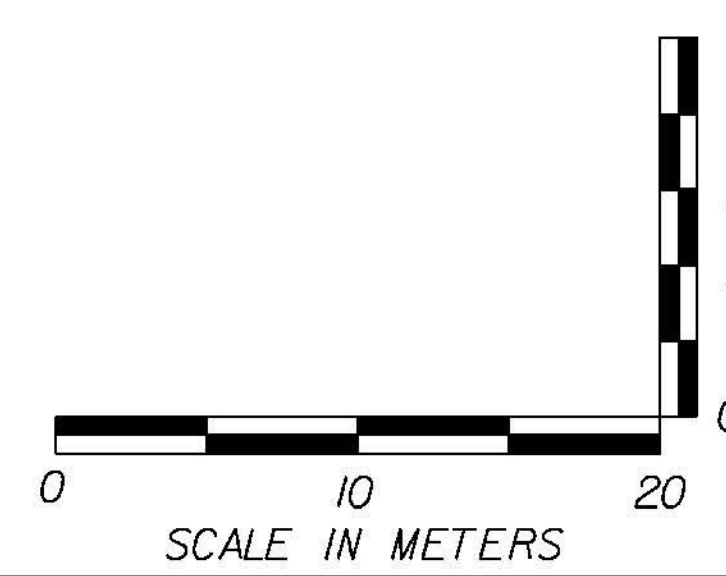

US 7 PROFILE 9

PROJECT NAME: BRANDON	PLOT DATE: 9/3/2009
PROJECT NUMBER: NH 019-3(495)	DRAWN BY: NLL
FILE NAME: zb008s5-pro09.dgn	CHECKED BY: PTS
PROJECT LEADER: CRB	SHEET 85 OF 546
DESIGNED BY: DAM	