


NOTE
 1. EXISTING GROUND ELEVATION IS SHOWN LIGHT.
 2. FINISH GRADE ELEVATION IS SHOWN IN BOLD.

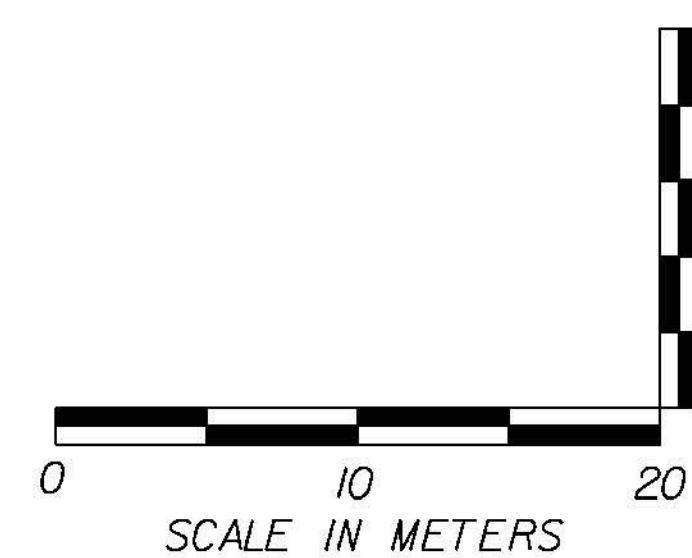

US 7 PROFILE 11

PROJECT NAME: BRANDON	PLOT DATE: 9/3/2009
PROJECT NUMBER: NH 019-3(495)	DRAWN BY: NLL
FILE NAME: zb008s5-pr011.dgn	CHECKED BY: PTS
PROJECT LEADER: CRB	SHEET 89 OF 546
DESIGNED BY: DAM	
CLD 02-0149	