



CONSTRUCT DRIVES
 STA 18+169.2 LT - 7.2 m WIDE, PAVED-COMM.

SPECIAL PROVISION (REMOVING AND
 RESETTING GROUND/ORNAMENTAL LIGHT)
 STA 18+164.3 LT
 STA 18+172.4 LT

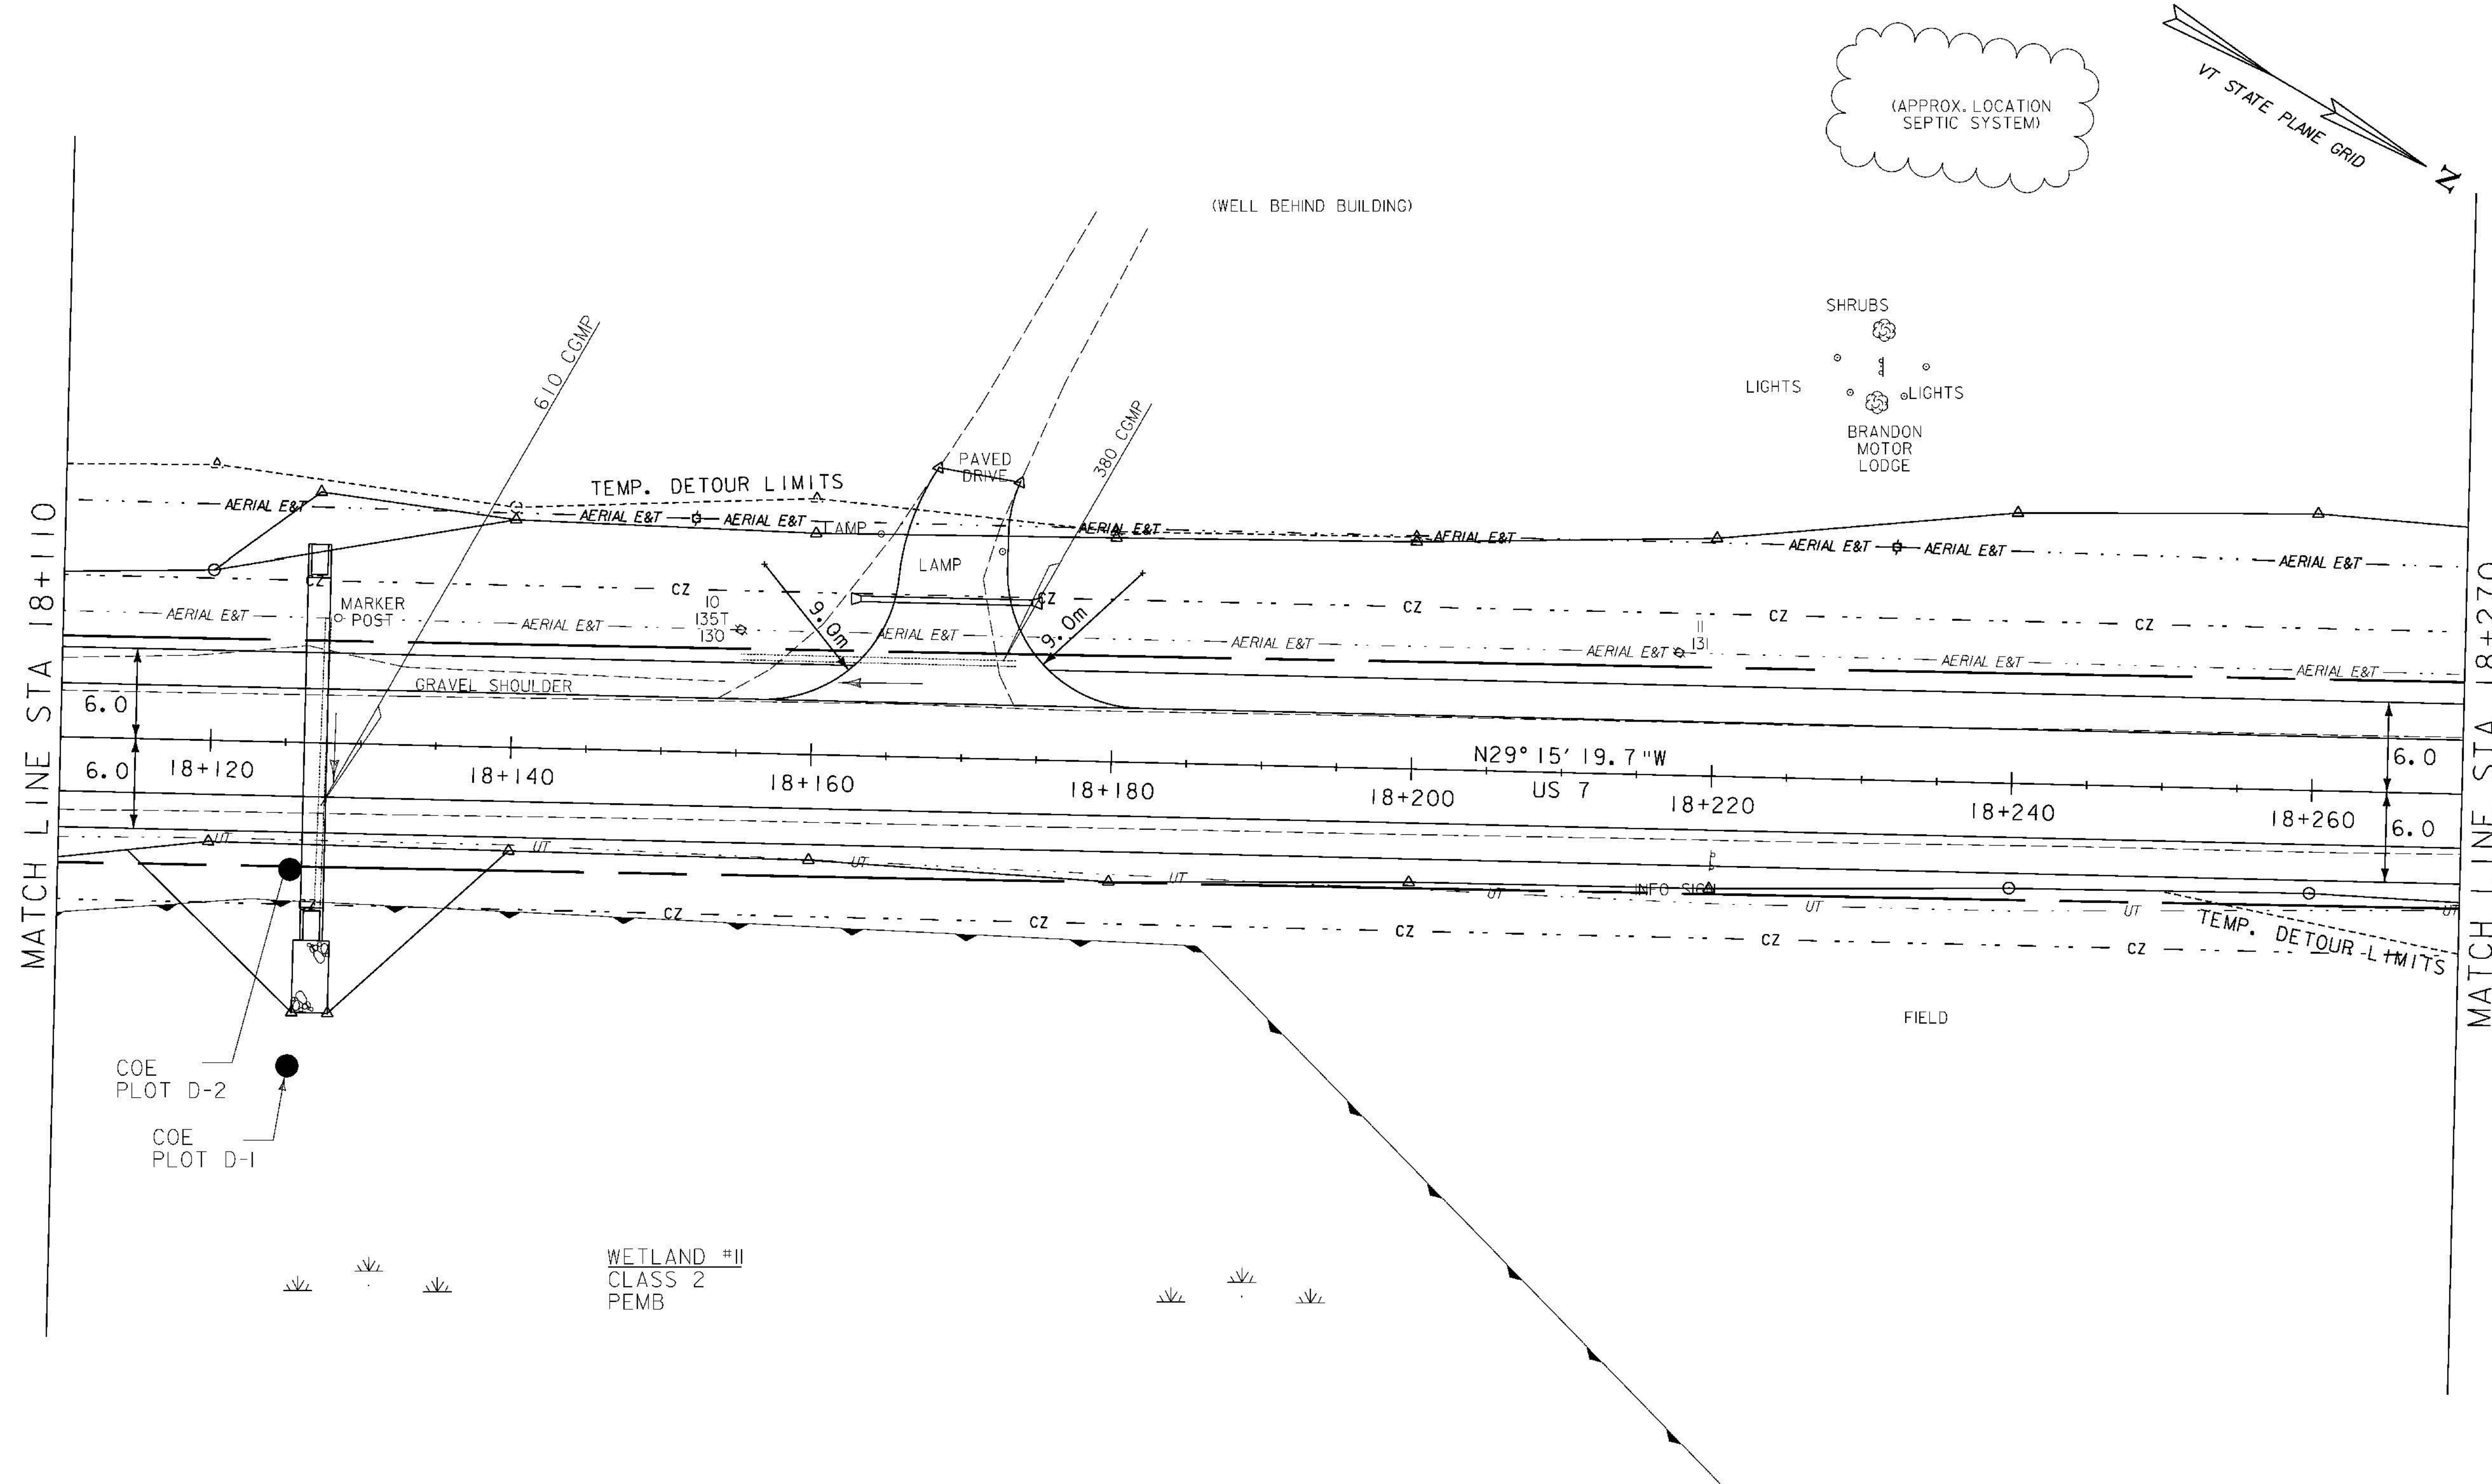

⊗ DENOTES TREE OR STUMP REMOVAL

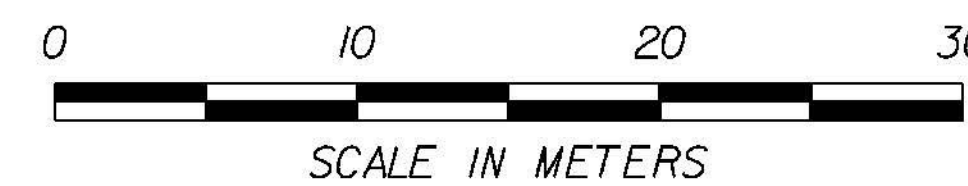

ROADWAY LAYOUT 12

PROJECT NAME:	BRANDON	PLOT DATE:	9/3/2009
PROJECT NUMBER:	NH 019-3(495)	DRAWN BY:	NLL
FILE NAME:	zb008s5-genl2.dgn	CHECKED BY:	PTS
PROJECT LEADER:	CRB		
DESIGNED BY:	DAM		
CLD 02-0149		SHEET	90 OF 546