

STA 19+234.000
 END COLD PLANE
 & OVERLAY
 RESUME FULL DEPTH
 CONSTRUCTION

EXISTING GROUND

-2.0055%


PVC STA = 19+330.000
 PVC ELEV = 127.044

L = 90 m
 K = 76

-0.8286%

PVI STA = 19+375.000
 PVI ELEV = 126.142

NOTE
 1. EXISTING GROUND ELEVATION IS SHOWN LIGHT.
 2. FINISH GRADE ELEVATION IS SHOWN IN BOLD.

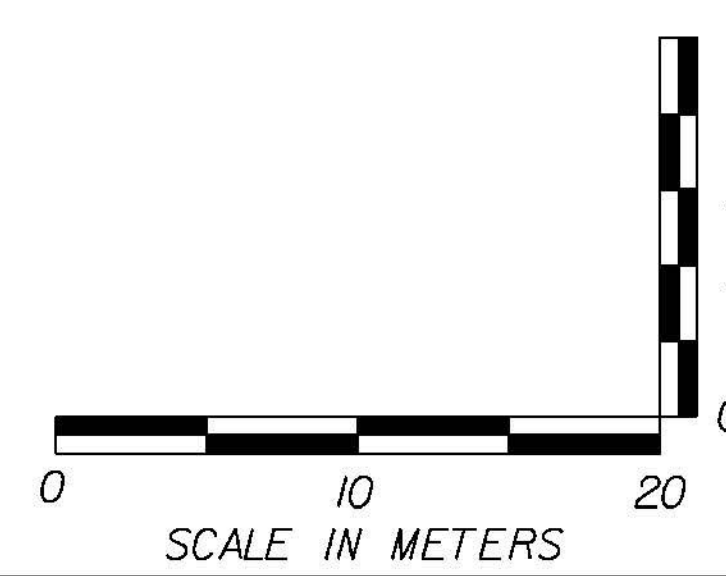

US 7 PROFILE 19	
PROJECT NAME: BRANDON	PLOT DATE: 9/3/2009
PROJECT NUMBER: NH 019-3(495)	DRAWN BY: NLL
FILE NAME: zb008s5-prot9.dgn	CHECKED BY: PTS
PROJECT LEADER: CRB	SHEET 105 OF 546
DESIGNED BY: DAM	
CLD 02-0149	