
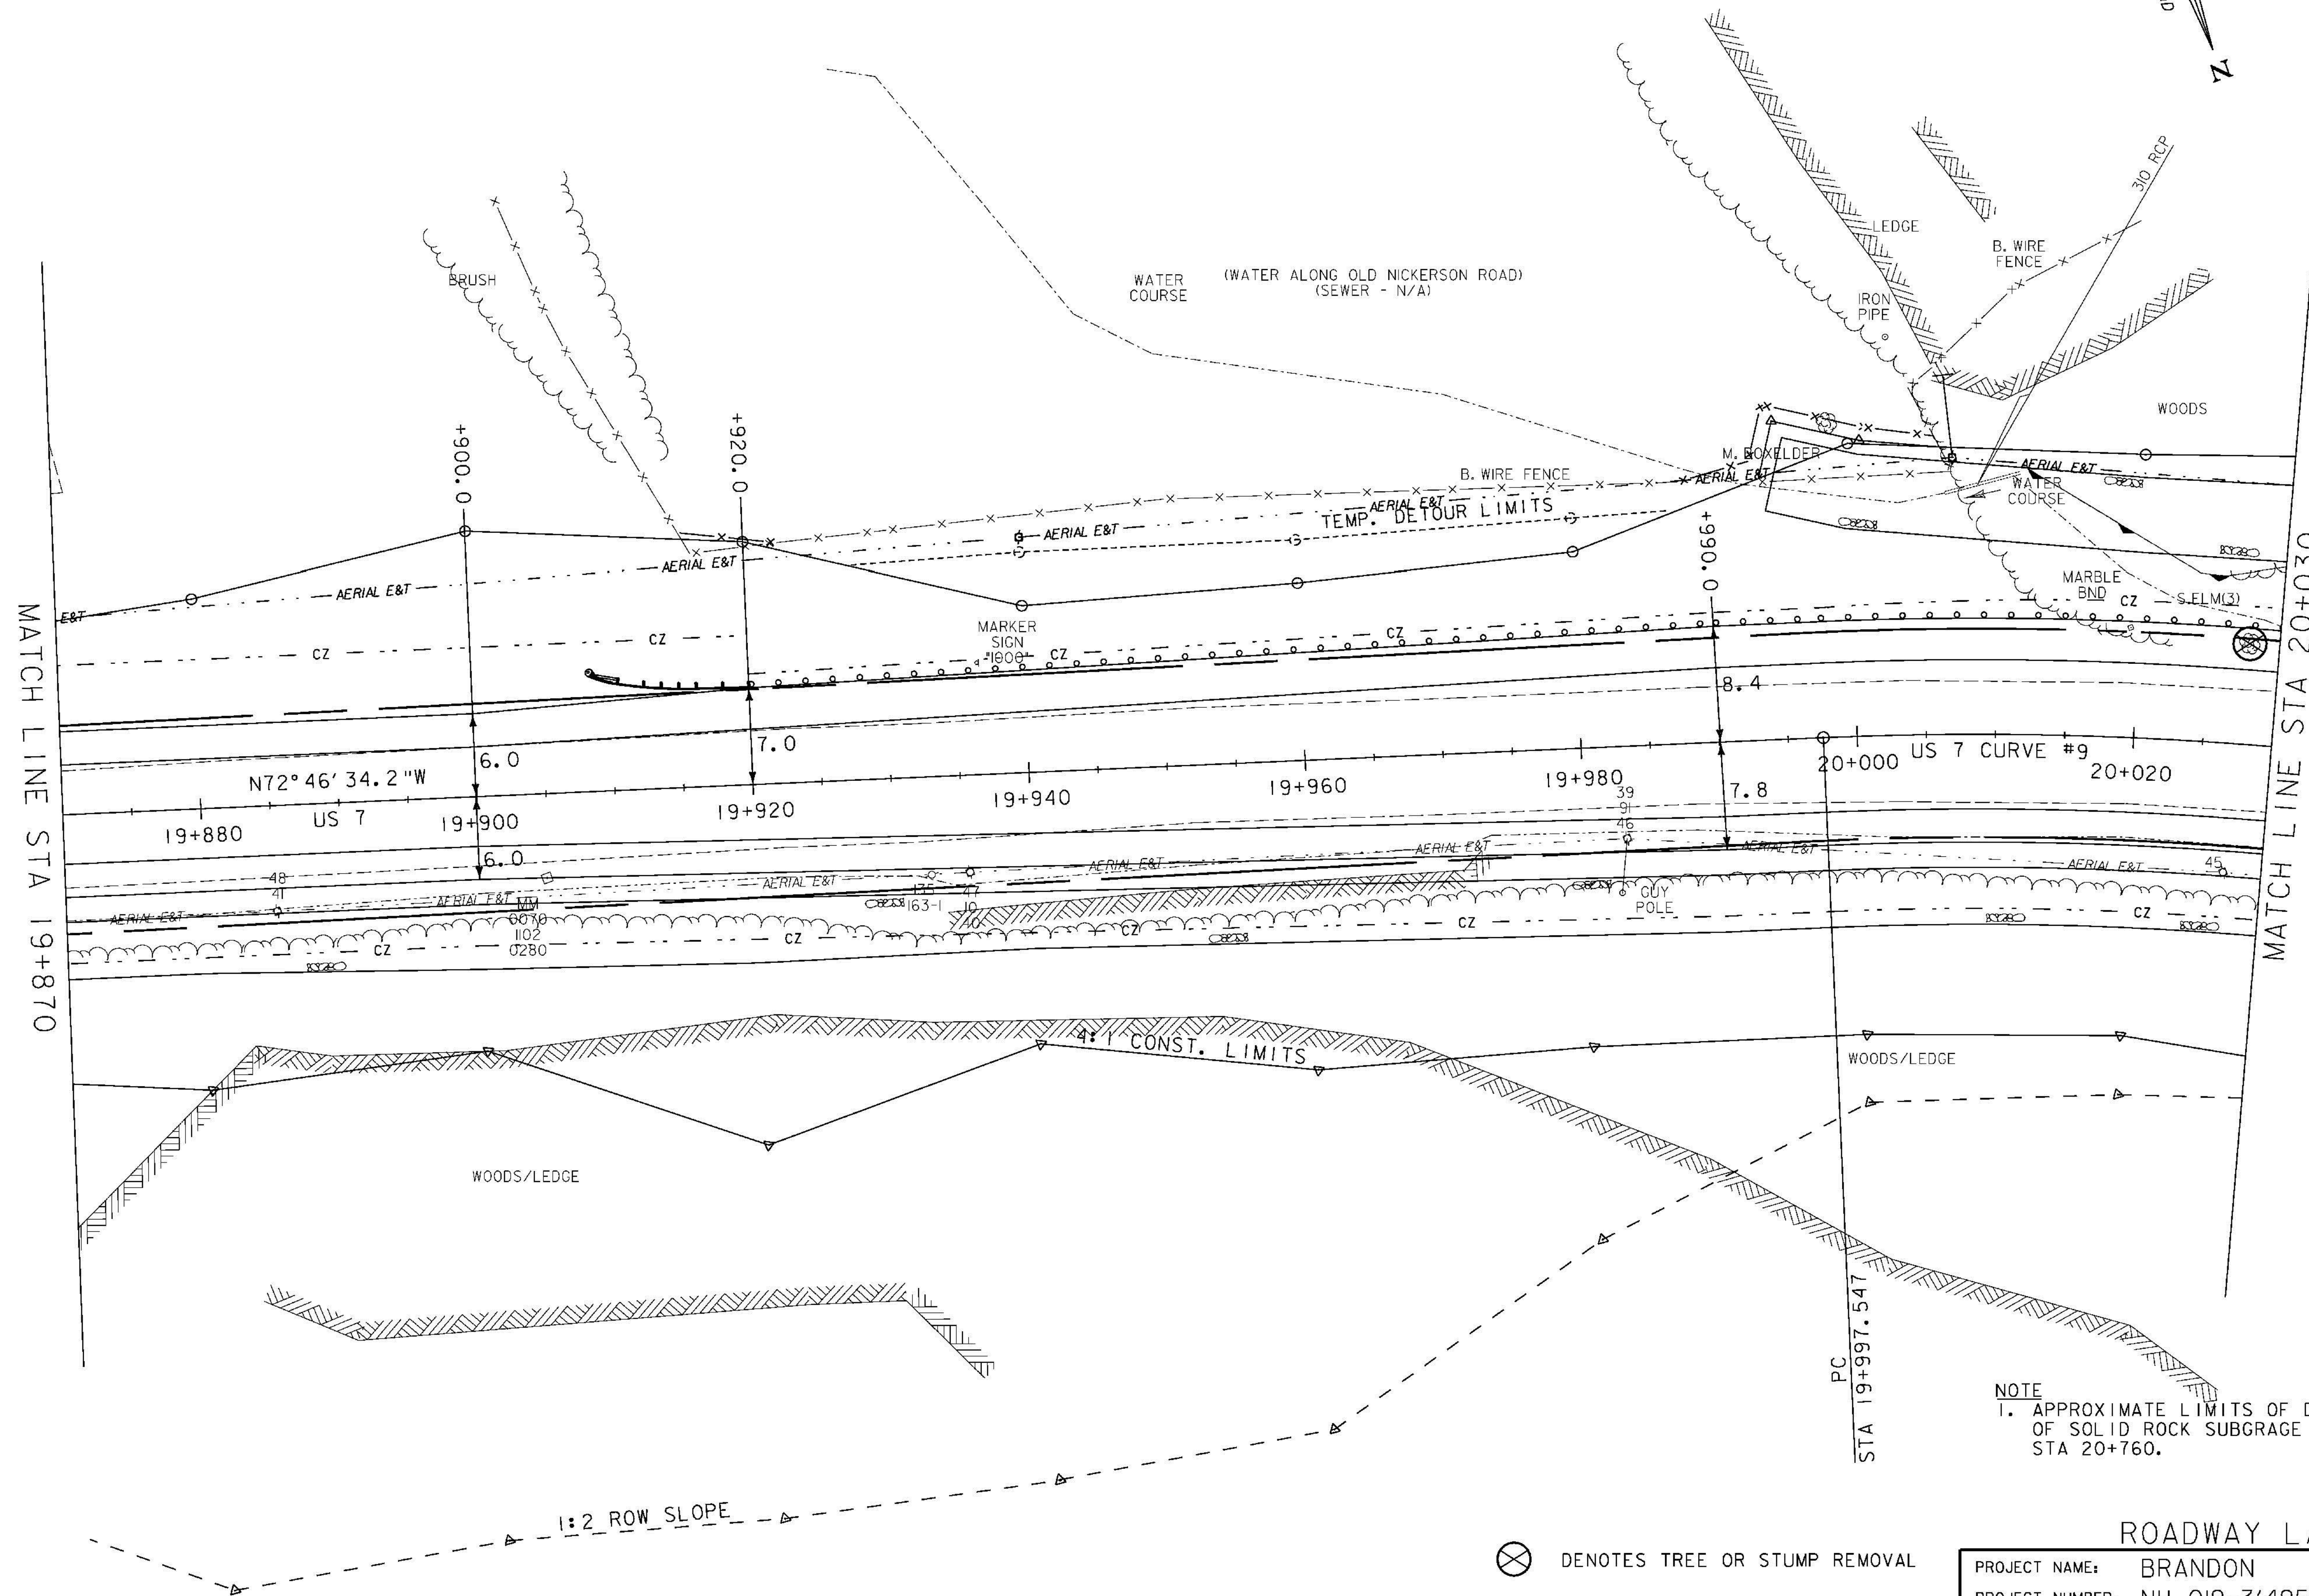



STEEL BEAM GUARDRAIL, GALVANIZED  
 STA 19+920.0 - 20+030.0 LT  
 MANUFACTURED TERMINAL SECTION, TANGENT  
 STA 19+920.0 LT

REMOVAL OF EXISTING FENCE  
 STA 19+915.6 - 19+922.5 LT  
 STA 19+993.5 - 20+005.8 LT  
 SPECIAL PROVISION  
 (BARBED WIRE FENCE)  
 STA 19+915.6 - 19+922.5 LT  
 STA 19+987.8 - 20+006.0 LT

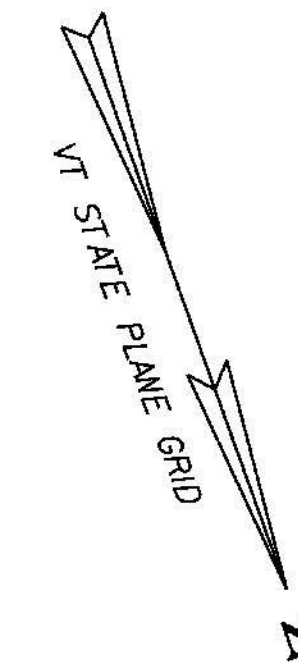

NOTE  
 1. APPROXIMATE LIMITS OF DRILLING AND BLASTING OF SOLID ROCK SUBGRAGE FROM STA 19+780 TO STA 20+760.

⊗ DENOTES TREE OR STUMP REMOVAL

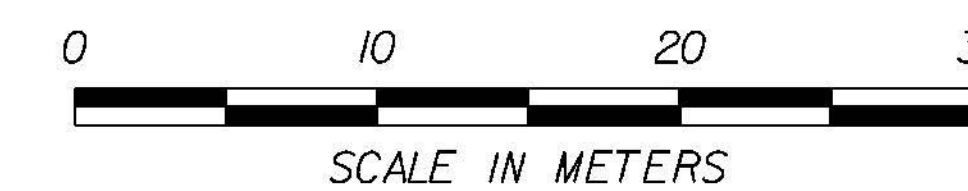

ROADWAY LAYOUT 23

PROJECT NAME:	BRANDON	PLOT DATE:	9/3/2009
PROJECT NUMBER:	NH 019-3(495)	DRAWN BY:	NLL
FILE NAME:	zb008s5-gen23.dgn	CHECKED BY:	PTS
PROJECT LEADER:	CRB	CLD 02-0149	SHEET 12 OF 546
DESIGNED BY:	DAM		